

Lloyd's Register of British and Foreign Shipping.

(Report on Vessel No. 7060 Port Leith .)

No. 3752 SHIP FORGINGS ~~OR~~ CASTINGS.

I have to report that the undermentioned Iron ~~or Steel~~ Forgings ~~or Castings~~, manufactured by Messrs Wm Beardmore & Co of Glasgow for the Vessel No. 177, being built by The Grangemouth D. Co of Grangemouth have been inspected by me as set forth below and found to be, so far as can be seen, Sound & efficient

Mark on Forgings.



Lloyd's
No. 3752
W H

William Hamilton

Glasgow
1/10/92

	STERN FRAME.	RUDDER FRAME.	STEM.
Material* - - - -	/	Scrap iron	/
How made - - - -		Forged	
Dimensions - - - -		3 3/4 to 2 1/4 dia	
Progress on Inspection -		Forging & smithing	
Dates when Inspected		8.11.16.20.24. 30/9/92	

SKETCHES OF FRAMES SHEWING POSITION AND DESCRIPTION OF WELDS OF FORGINGS, OR PARTICULARS OF TESTS APPLIED TO CASTINGS.

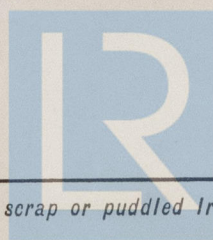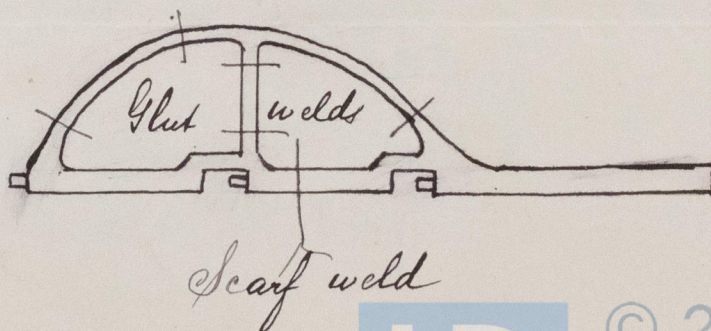

© 2019

Lloyd's Register
Foundation

* If of Iron, state whether scrap or puddled Iron.

Bkn. "River Hunter"

Lth. Rept No 7060



© 2019

Lloyd's Register
Foundation