

Lloyd's Register of British and Foreign Shipping.

Leith(Report on Vessel No. *7077* Port *Leith*)No. *2325 a*

SHIP FORGINGS OR CASTINGS.

I have to report that the undermentioned Iron ^{and} or Steel Forgings or Castings, manufactured by*The Darlington Forge Co*

of

*Darlington*for the Vessel No. *118*, being built by *Messrs Ramage & Ferguson*

of

Leith

have been inspected by me as set forth below, and found

to be, so far as can be seen, *sound*


Mark on Forgings.

Lloyd's

No. *2325 a**No. 6**Hugh Camm**Sunderland**26. 8. 92*

	STERN FRAME.	RUDDER FRAME.	STEM.
Material*	<i>Scrap iron</i>	<i>Scrap steel & cast iron</i>	<i>Scrap iron</i>
How made	<i>Fused</i>	<i>Fused</i>	<i>Fused</i>
Dimensions	<i>7 1/4" x 14 3/4"</i>	<i>6 1/2" - 3"</i>	<i>7 1/4" x 2 3/8"</i>
Progress on Inspection .	<i>Fused & smithed</i>	<i>Fused & smithed</i>	<i>Fused</i>
Dates when Inspected	<i>April 8th & June 10th 92</i>	<i>July 7th & Aug 17th 92</i>	<i>April 8th 92</i>

SKETCHES OF FRAMES SHEWING POSITION AND DESCRIPTION OF WELDS OF FORGINGS, OR PARTICULARS OF TESTS APPLIED TO CASTINGS.

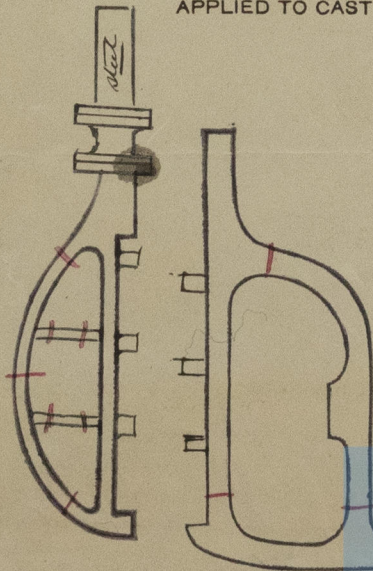

Welds

© 2019

Lloyd's Register
Foundation

S. S. "Norwegian"
Lth. Report. 70 77

© 2019



Lloyd's Register
Foundation