

## Lloyd's Register of British and Foreign Shipping.

(Report on Vessel No. 7096 Port Leith)No. 3721 SHIP FORGINGS ~~OR CASTINGS~~.

The words FORGINGS or CASTINGS, IRON or STEEL, should be struck out as may be required.

I have to report that the undermentioned Iron ~~or Steel~~ Forgings ~~or Castings~~, manufactuerd by Messrs Wm Beardmore & Coy of Glasgow for the Vessel No. 174, being built by The Grangemouth D. Coy of Grangemouth have been inspected by me as set forth below, and found to be, so far as can be seen, Sound & efficient


Mark on Forgings.

Lloyd's

No. 3721W HWilliam HamiltonGlasgow5/11/92

|                          | STERN FRAME. | RUDDER FRAME.                                                                                              | STEM. |
|--------------------------|--------------|---|-------|
| Material* - - - -        | /            | <u>Scrap iron</u>                                                                                          | /     |
| How made - - - -         |              | <u>Forged</u>                                                                                              |       |
| Dimensions - - - -       |              | <u>6 in to 3 1/4</u>                                                                                       |       |
| Progress on Inspection - |              | <u>Forging &amp; smithing</u>                                                                              |       |
| Dates when Inspected     |              | <u>13. 15. 24/6/92. 12. 13/7/92</u><br><u>5. 10. 19. 25. 29/8/92. 6/9/92</u><br><u>5. 24. 26. 29/10/92</u> |       |

SKETCHES OF FRAMES SHEWING POSITION AND DESCRIPTION OF WELDS OF FORGINGS, OR PARTICULARS OF TESTS APPLIED TO CASTINGS.

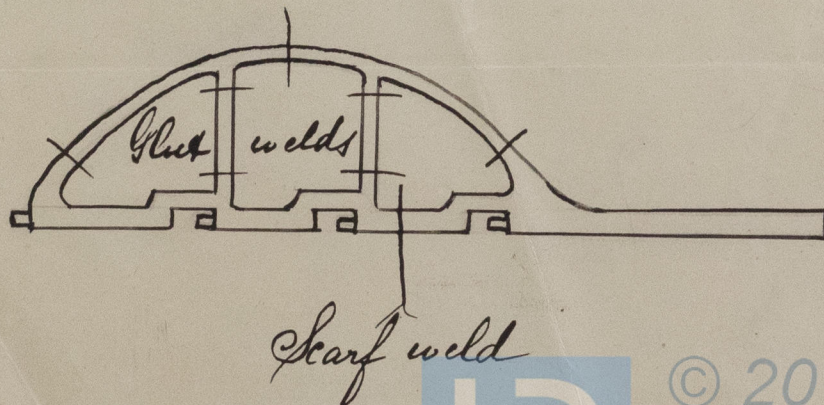

S.S. Ciudad de Reus

Lth. Rept. N<sup>o</sup> 7096



© 2019

Lloyd's Register  
Foundation