

## Lloyd's Register of British and Foreign Shipping.

(Report on Vessel No. 7096 Port Leith )

No. 3721

SHIP FORGINGS OR ~~CASTINGS~~.

The words FORGINGS or CASTINGS, IRON or STEEL, should be struck out as may be required.

I have to report that the undermentioned Iron ~~or Steel~~ Forgings ~~or Castings~~, manufactured by  
Messrs Wm Beardmore & Co of Glasgow  
 for the Vessel No. 174, being built by The Grangemouth D. Co  
 of Grangemouth have been inspected by me as set forth below, and found  
 to be, so far as can be seen, Sound & efficient

Mark on Forgings.

Lloyd's

No. 3721


W.H.

William Hamilton

Glasgow  
29/8/92


	STERN FRAME.	RUDDER FRAME.	STEM.
Material* . . . .	Scrap iron	/	Scrap iron
How made . . . .	Forged		Forged
Dimensions . . . .	8 1/2 x 4 5		8 1/2 x 2 1/2
Progress on Inspection .	Forging & smithing		Forging & smithing
Dates when Inspected	2.13.15.20/6/92 13/7/92 3.5.10.12/8/92		13.15.20/6/92 15/7/92

SKETCHES OF FRAMES SHEWING POSITION AND DESCRIPTION OF WELDS OF FORGINGS, OR PARTICULARS OF TESTS APPLIED TO CASTINGS.

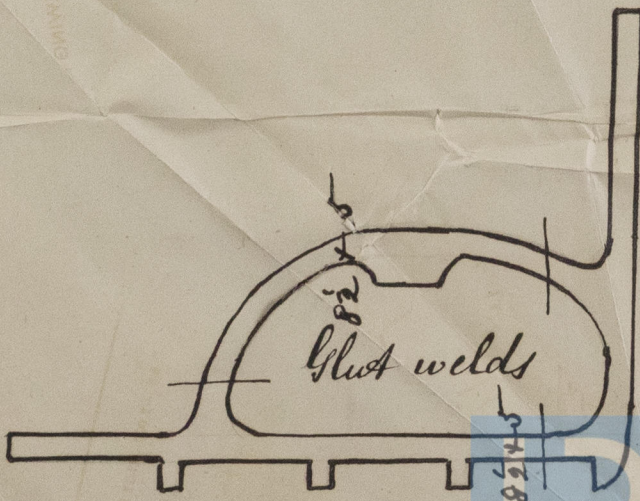

\* If of Iron, state whether scrap or puddled Iron.

Lith. Repert. No 7096.

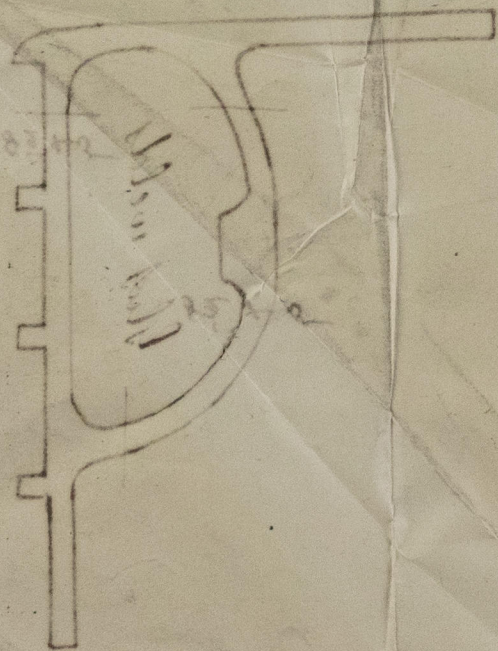






©

© 2019

Lloyd's Register  
Foundation