


S. S. "Saturnus"

Lth. Report. N<sup>o</sup> 7221

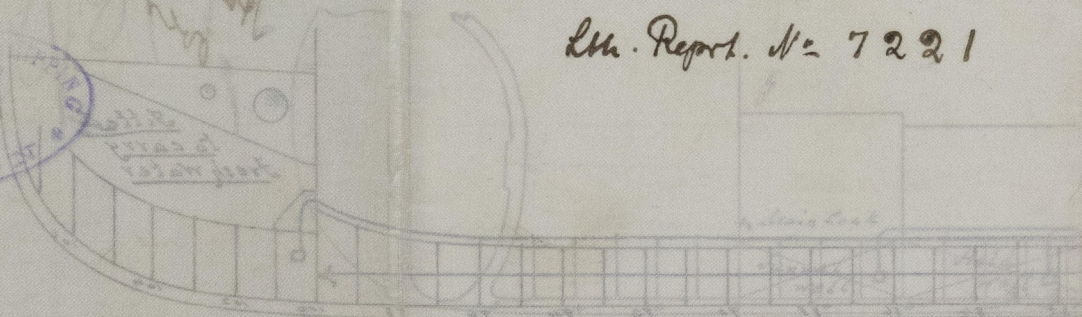


"Saturnus" P. P.

Lth. Report. N<sup>o</sup> 7221



Pumping Arrangement

2.5.184

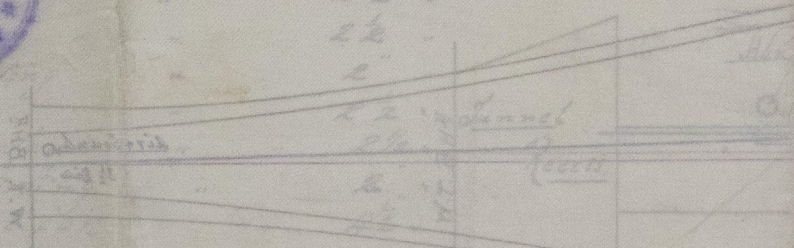

Lth. Report. N<sup>o</sup> 7221



© 2019

Lloyd's Register  
Foundation

LTH 563-0072






Fitted  
to carry  
Fresh water

9. 9. "Saturnus"

Lith. Report. N<sup>o</sup> 7221.

## PUMPING ARRANGEMENT

— S.S. № 84 —

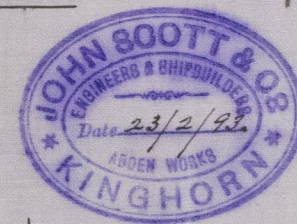

© 2019

24<sup>th</sup> Feb. 93. - H.V.


Lloyd's Register  
Foundation

— LIST OF PIPES. —

After Ballast Tank Suction Filling	2 1/2	Dis
Tunnel	"	2 1/2 "
After Hold	"	2 1/2 "
Engine Room	"	2 1/2 "
" " Ring	"	2 "
Fore Tank	"	2 1/2 "
" Peak Tank	"	2 1/2 "
Fore Hold Ring	"	2 "
Bulge Inspection	4 1/2	"

— NOTE All sluices & hand pumps  
accessible from Deck

Donkey & hand pumps  
accessible from Deck.

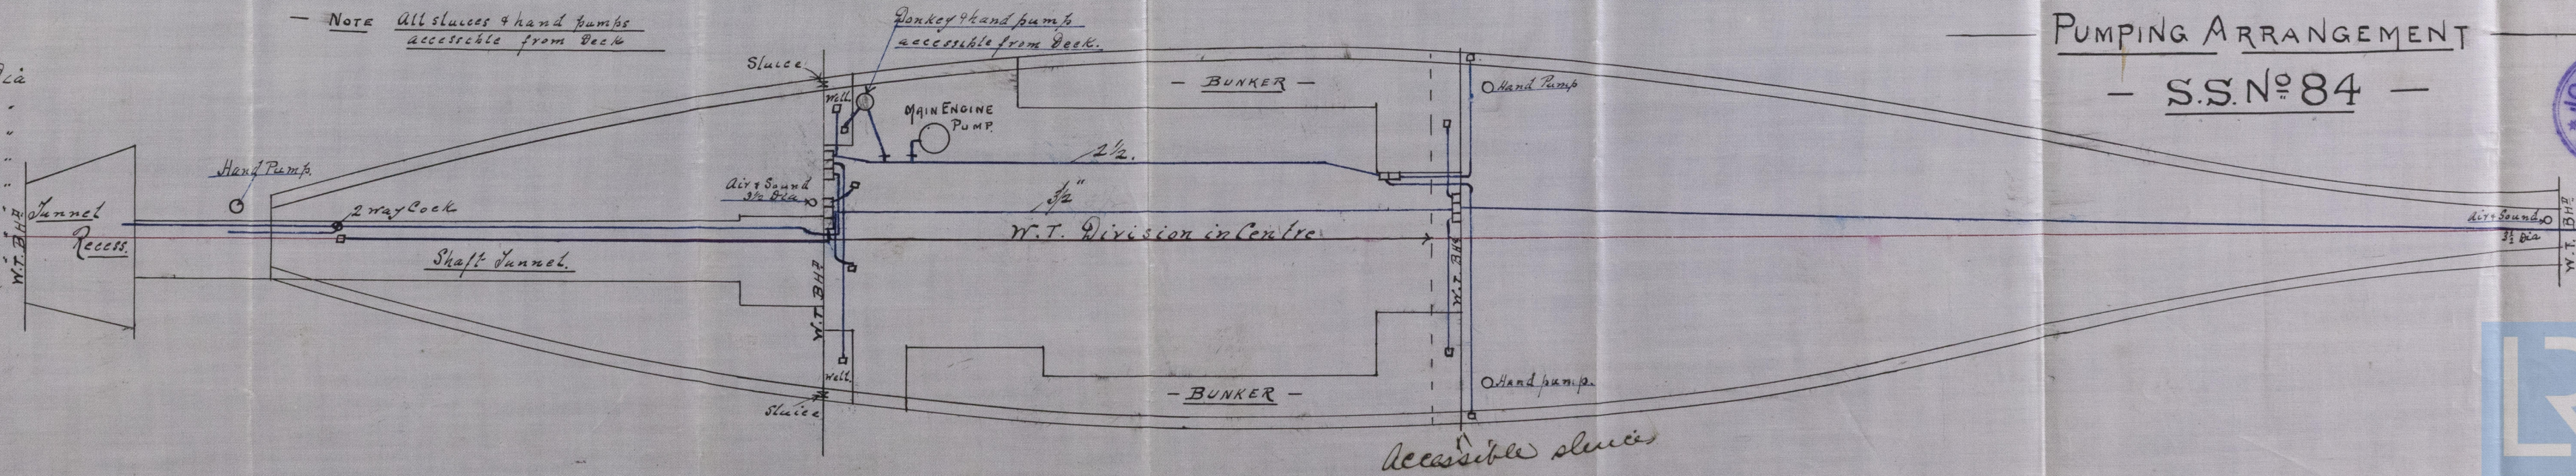

accessible sluces

LT# 563-0072