

Lloyd's Register of British and Foreign Shipping.

(Report on Vessel No. 7221 Port Leith)

No. 168

SHIP FORGINGS OR CASTINGS.

I have to report that the undermentioned Iron or Steel Forgings or Castings, manufactured by

The Fire Forge Co. of *Kirkcaldy*

for the Vessel No. *84*, being built by *John Scott & Co.*

of *Kinghorn* have been inspected by me as set forth below, and found

to be, so far as can be seen, *sound forgings.*

The words FORGINGS or CASTINGS, IRON or STEEL, should be struck out as may be required.


Mark on Forgings.

Lloyd's
No. *154*
W.J.D.

W. Darling.
Leith

	STERN FRAME.	RUDDER FRAME.	STEM.
Material*	<i>Scrap iron</i>	<i>Scrap iron</i>	/
How made	<i>Forged & smithed</i>	<i>Forged & smithed</i>	
Dimensions	<i>6 3/4 x 4 1/4</i>	<i>Head 4 3/4 keel 2 3/4</i>	
Progress on Inspection	<i>Forged & finished</i>	<i>Forged & finished</i>	
Dates when Inspected	<i>From 2nd Decr 1892 till 2nd May 1893 three visits</i>		

SKETCHES OF FRAMES SHEWING POSITION AND DESCRIPTION OF WELDS OF FORGINGS, OR PARTICULARS OF TESTS APPLIED TO CASTINGS.

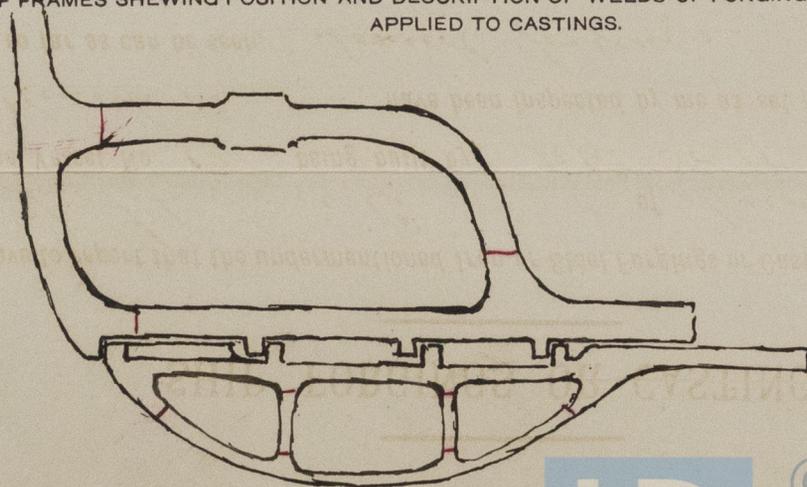

H welds.




© 2019

Lloyd's Register
Foundation

LTH 563-0074

s. s. "Saturnus"
Lth. Report. No: 7221

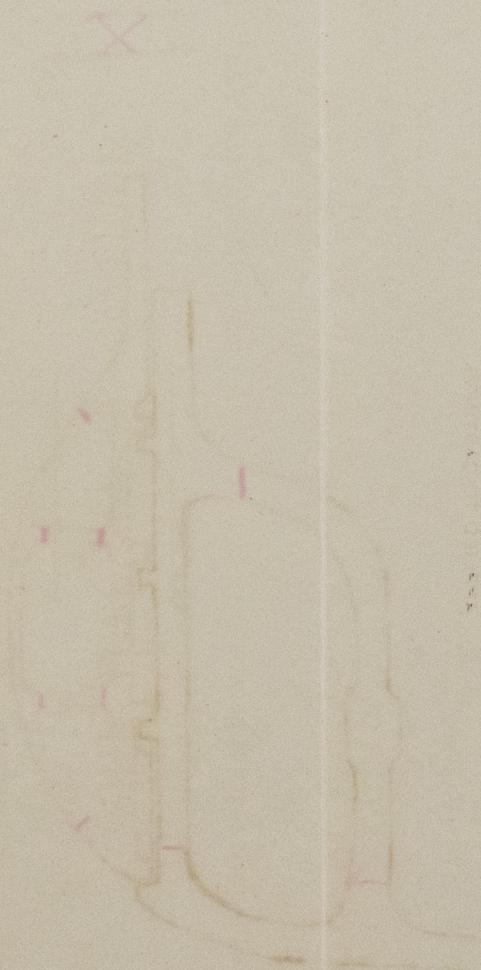

[Faint, illegible handwritten text, likely bleed-through from the reverse side of the page.]

[Faint, illegible handwritten text, likely bleed-through from the reverse side of the page.]




© 2019
Lloyd's Register
Foundation