
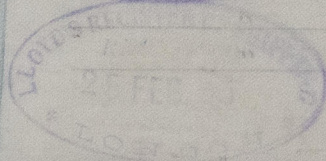
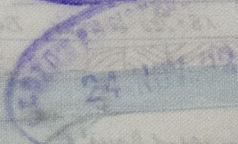


S. S. "Saturnus"

Lth. Rept. No 7221

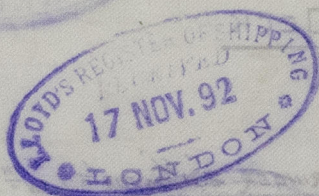


© 2019

Lloyd's Register
Foundation

LTH 563-0076 (1/2)

Lloyd's Register
Foundation

— My tracing shewing alteration —
 — in thickness of Arming Deck as —
 — per letter of 1st Dec —

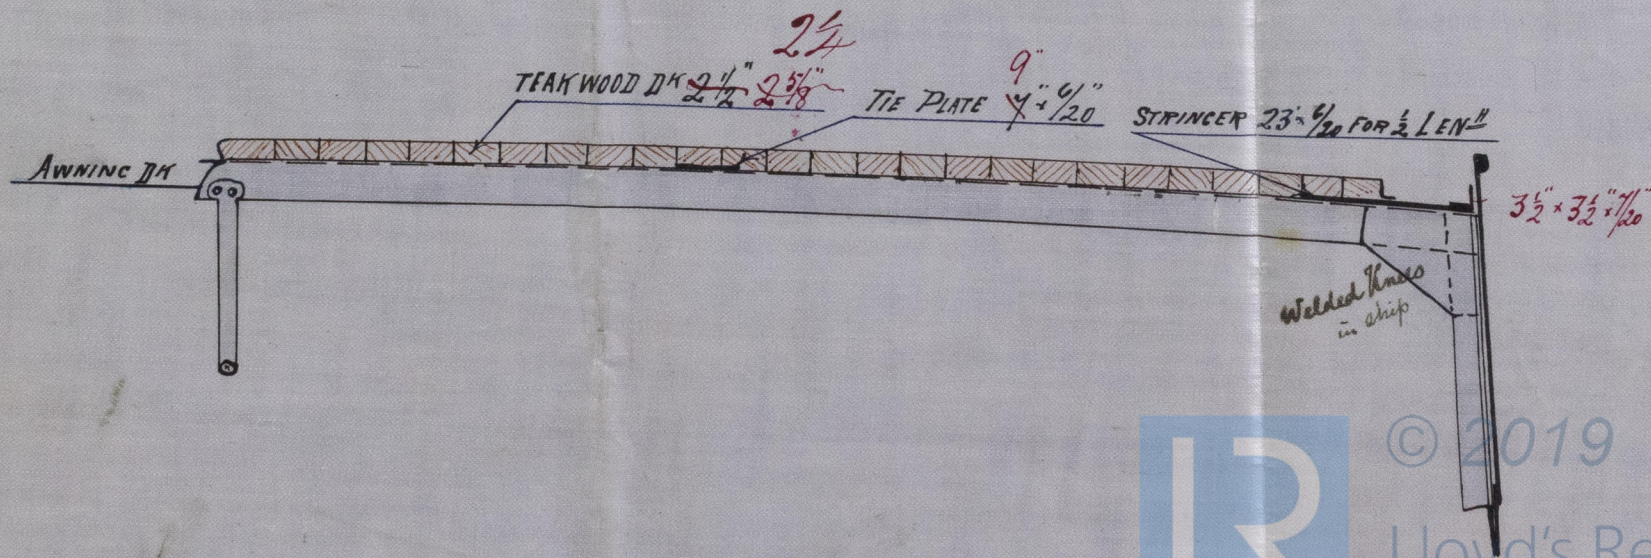

© 2019

Lloyd's Register
 Foundation

(2/2)