

Lloyd's Register of British and Foreign Shipping.

(Report on Vessel No. 7242 Port Leith)

No. 3823 SHIP FORGINGS ~~OR CASTINGS~~.

The words FORGINGS or CASTINGS, IRON or STEEL, should be struck out as may be required.

I have to report that the undermentioned Iron or ~~Steel~~ Forgings or Castings, manufactured by

The Newmystown Forge Co. of Newmystown.

for the Vessel No. 120, being built by Messrs. Ramsay & Ferguson.

of Leith. have been inspected by me as set forth below, and found

to be, so far as can be seen, Sound.

Mark on Forgings.

Lloyd's
No. 3823
FC



Frank Cook.

Glasgow.

10/2/93

	STERN FRAME.	RUDDER FRAME.	STEM.
Material*	<u>Scrap Iron Forged</u> <u>8 1/4 to 1 1/2 in</u> <u>Forging & Smithing</u> <u>15.22/1/92. 6.8.14.24/2/92</u> <u>9.13.24/1/93. 3.7.10/2/93</u>		
How made			
Dimensions			
Progress on Inspection			
Dates when Inspected			

SKETCHES OF FRAMES SHEWING POSITION AND DESCRIPTION OF WELDS OF FORGINGS, OR PARTICULARS OF TESTS APPLIED TO CASTINGS.

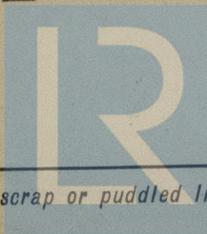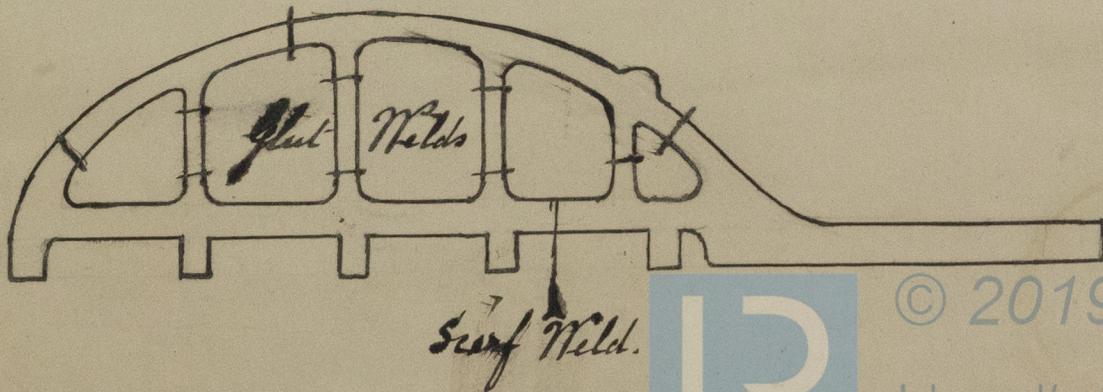


© 2019

Lloyd's Register Foundation

* If of Iron, state whether scrap or puddled Iron.

Bk. "Royal Fortk"

4th. Rept. N: 7242.

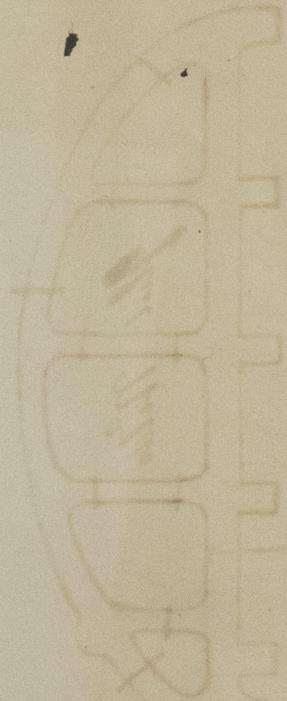







© 2019

Lloyd's Register
Foundation