

Grangemouth Co.

SCALE $\frac{1}{2}$ " INCH = ONE FOOT

TO CLASS 100 A1 AT LLOYDS

- NUMERALS -

— PROPORTIONS

DEPTHS IN LENGTH 12.94

BREADTHS IN LENGTH 7.02

$$79.96 \times 284.33 = 22735.02 + 2841.87 = 25576.89$$

-F.N.- -P.N.- -E.N.-

F.N—

— P. N. —

- E. N. -

S. S. "Dunblane"

Lth. Dept. No: 7505

9. 8. 93.
30. 8. 93.
12. 9. 93
9. 4. 94

$$79.96 \times 284.33 = 22735.02 \quad + \quad 2841.87 = 25576.89$$

- E N - - P N - - E N -

FRAMES $6" \times 3 \times \frac{9}{16}$ FOR $\frac{3}{4}$ " LENGTH TO $\frac{1}{2}$ " AT ENDS. SPACED 24" APART.
 D^2 $5" \times 3 \times \frac{1}{2}$ IN FORE & AFT PEAKS
 D^2 IN WAY OF TANK FLOORS $3 \times 3 \times \frac{9}{16}$ FOR $\frac{3}{4}$ " LENGTH TO $\frac{1}{2}$ " AT ENDS.
 REVERSE FRAMES $5 \frac{1}{2} \times 3 \times \frac{1}{2}$ FOR $\frac{3}{4}$ " TO $\frac{1}{2}$ " FROM TANK WING TO MAIN DECK GUNWALE BAR ON
 EVERY FRAME AND RAYING DECK ALTERNATELY *FOR about 6" length from stern in way of*
 REVERSE FRAMES $5 \frac{1}{2} \times 3 \times \frac{1}{2}$ FROM TANK WING TO QUARTER DECK AND STRINGER NEXT
 BELOW ALTERNATELY AND TO QUARTER DECK ON EVERY FRAME IN AFTER PEAK.
 DOUBLE REVERSE FRAMES $5 \frac{1}{2} \times 3 \times \frac{1}{2}$ IN E & B. SPACE ON DEEP FLOORS, SINGLE $3 \times 3 \times \frac{1}{2}$ ON FLOORS IN TANK & PEAKS
 DEEP REVERSE FRAMES IN LIEU OF WEB FRAMES

RUDDER $2\frac{3}{4}$ AT HEAD. $3\frac{3}{4}$ AT HEEL AND PINTLES

BULKHEADS LOWER HALF $\frac{1}{20}$ UPPER HALF $\frac{1}{20}$ STIFFENERS $5 \times 3 \times \frac{1}{20}$ 30" APART

HORIZONTAL STIFFENERS $4\frac{1}{2}'' \times 3'' \times \frac{9}{16}$ BULB ANGLE 4 FEET APART

STEM 10" x 2 1/2". STERN FRAME 10" x 5 1/2"

L 8 1/2" J

3^a x LUG

Intermediate birds common

Note - The two intermediate transverse W.D. bnds.

m. No. 2 and rafters holds. removed.

See, *Flora* 1. 11. 2.

Off. Top. Cr.

ANGLE 4" x 4" x $\frac{9}{32}$ " TO $\frac{8}{32}$ "

$$3\frac{1}{2} \times 3 \times \frac{8}{20}$$

2/10

21

$3\frac{1}{2} \times 3\frac{1}{2} \times \frac{1}{20}$

GLE 6" x 4" x 9/16 TO 1/2" FRAME 3" x 3" x 3/8 TO 1/2"

54 TREBLE RIVET

14" 12/20" 14" TREBLE RIVETTED LAP BUTTS

RIVETTED LAP BUTTS

INSIDE BUTTS. STRAPS 19" &

PLATES FOR 75 L & 7/32 THICKER

10

© 2020
Lloyd's Register
Foundation

1TH564-0066


S. S. Dunblane

Lth. Regt. No 7505

"Phillis Angel"

now "Coronation"

LT11564-0866

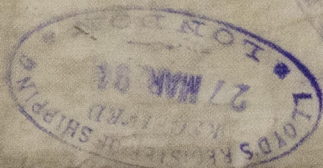

© 2020

Lloyd's Register
Foundation