

Dr. 23. 9. 23



Leith District


2.2. 1920  
Mr. J. J. ...  
1769.7 TONS ID

No. 181

Plan of Pumping Arrangements

Scale 1/8" = 1 foot.

"Phillis Angel"  
"Hutchinson"  
Lth. Repr. No. 7505

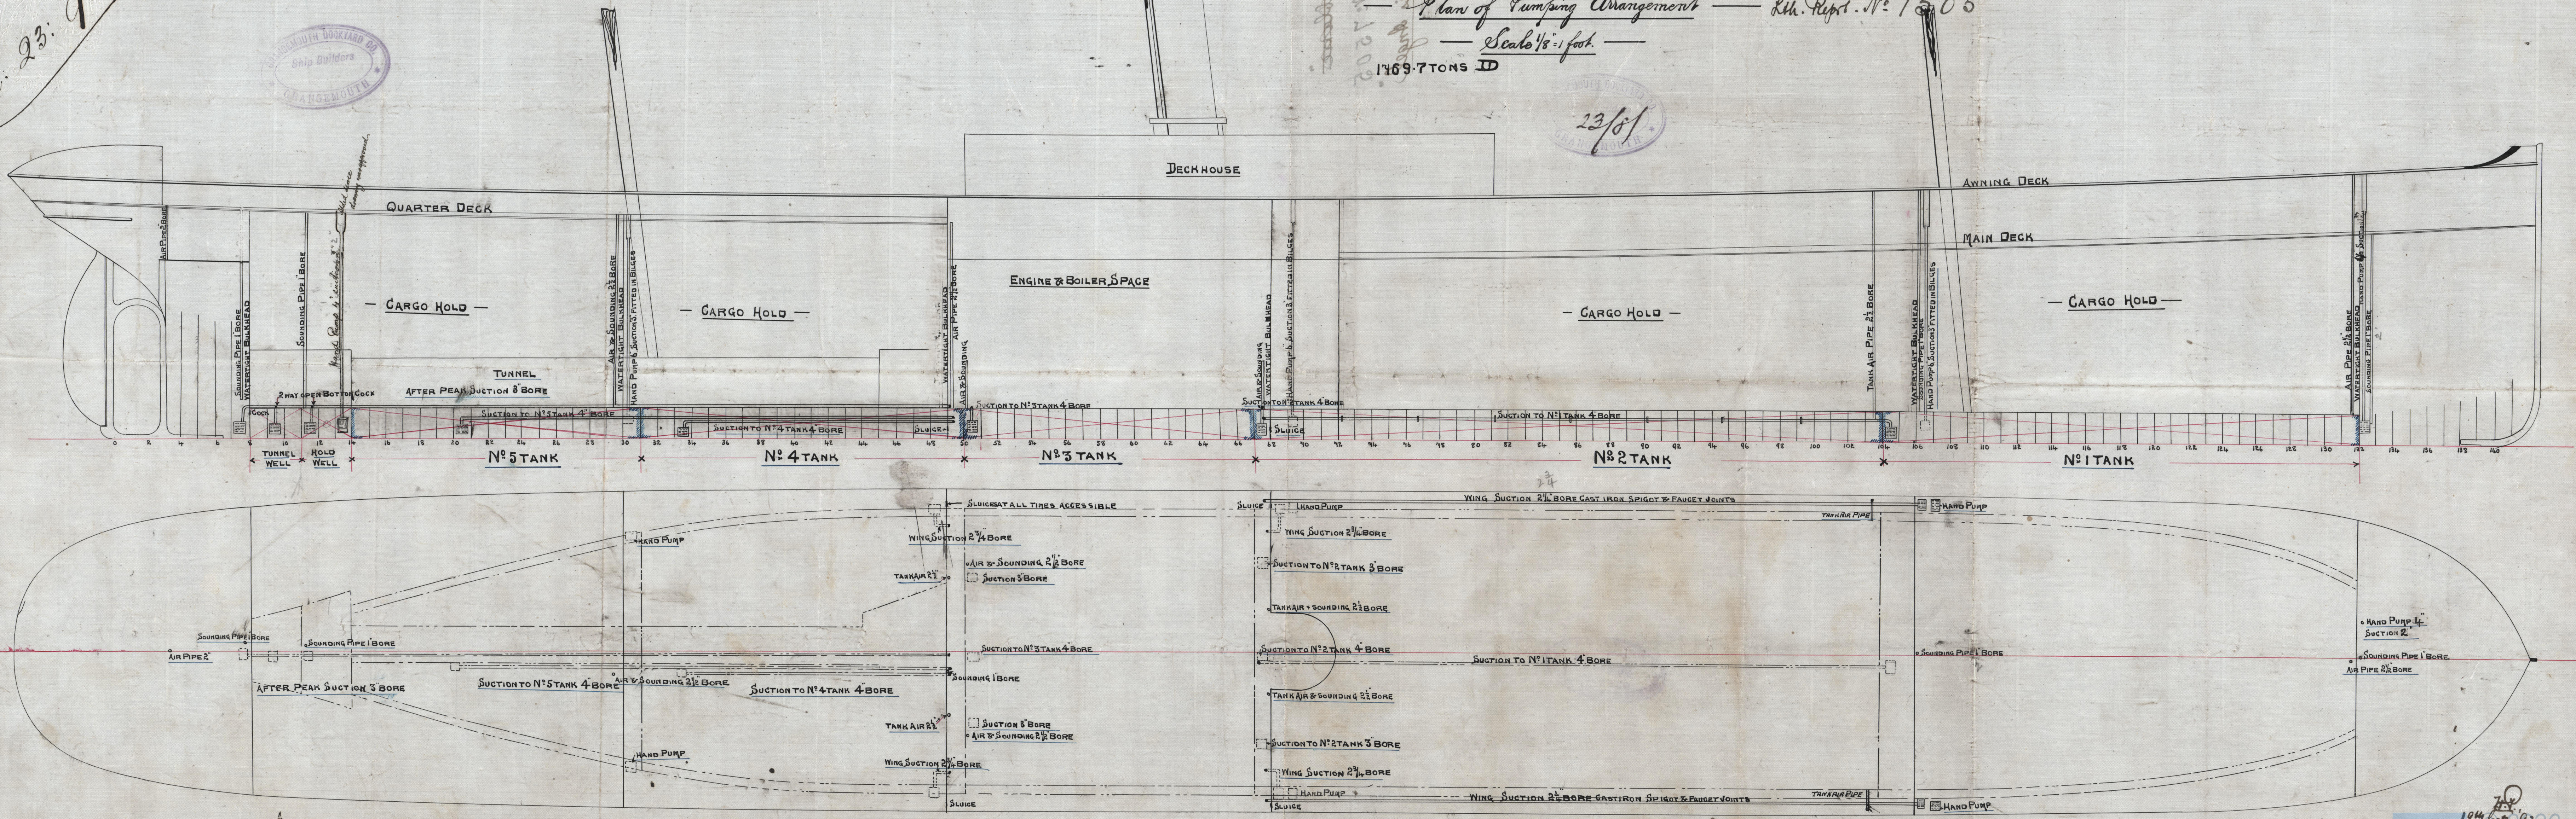

All sluices to be at all times accessible.

Sounding pipes take to Surveyors satisfaction.

J.M.  
21/9/23



