


Nº 130 4131 55º

Steel screw steamer "Sofia" (sister ship of "S. Georgios")

MIDSHIP SECTION

200' 0" x 29' 0" x 16' 0" M<sup>3</sup>  
SCALE 1/2" = 1 FOOT


Est. Rept. Nº 7634.

TO CLASS 100 A.1 LLOYDS-STEEL-

16.4.94  
25.4.94  
20.7.94

ERECTOR'S  
POOP --- 50  
BRIDGE --- 54.6  
FORECASTLE --- 47  
148.6 74

EQUIPMENT  
Equipment Nº (11701-73) 11701-89-12729-6  
CHITS  
1 BOWER ANCHOR 20' STOCKLESS 59 1/2"  
1 STEERIN 20' " " 59 1/2"  
1 KEDGE 20' " " 59 1/2"  
210 FATHOMS 1 1/2" STUD CHAIN CABLE  
60 " 1/2" STEEL CHAIN  
90 " 3/4" HEMP (OR STEEL WIRE)  
90 " 7" HAWKER  
90 " 5" WARP

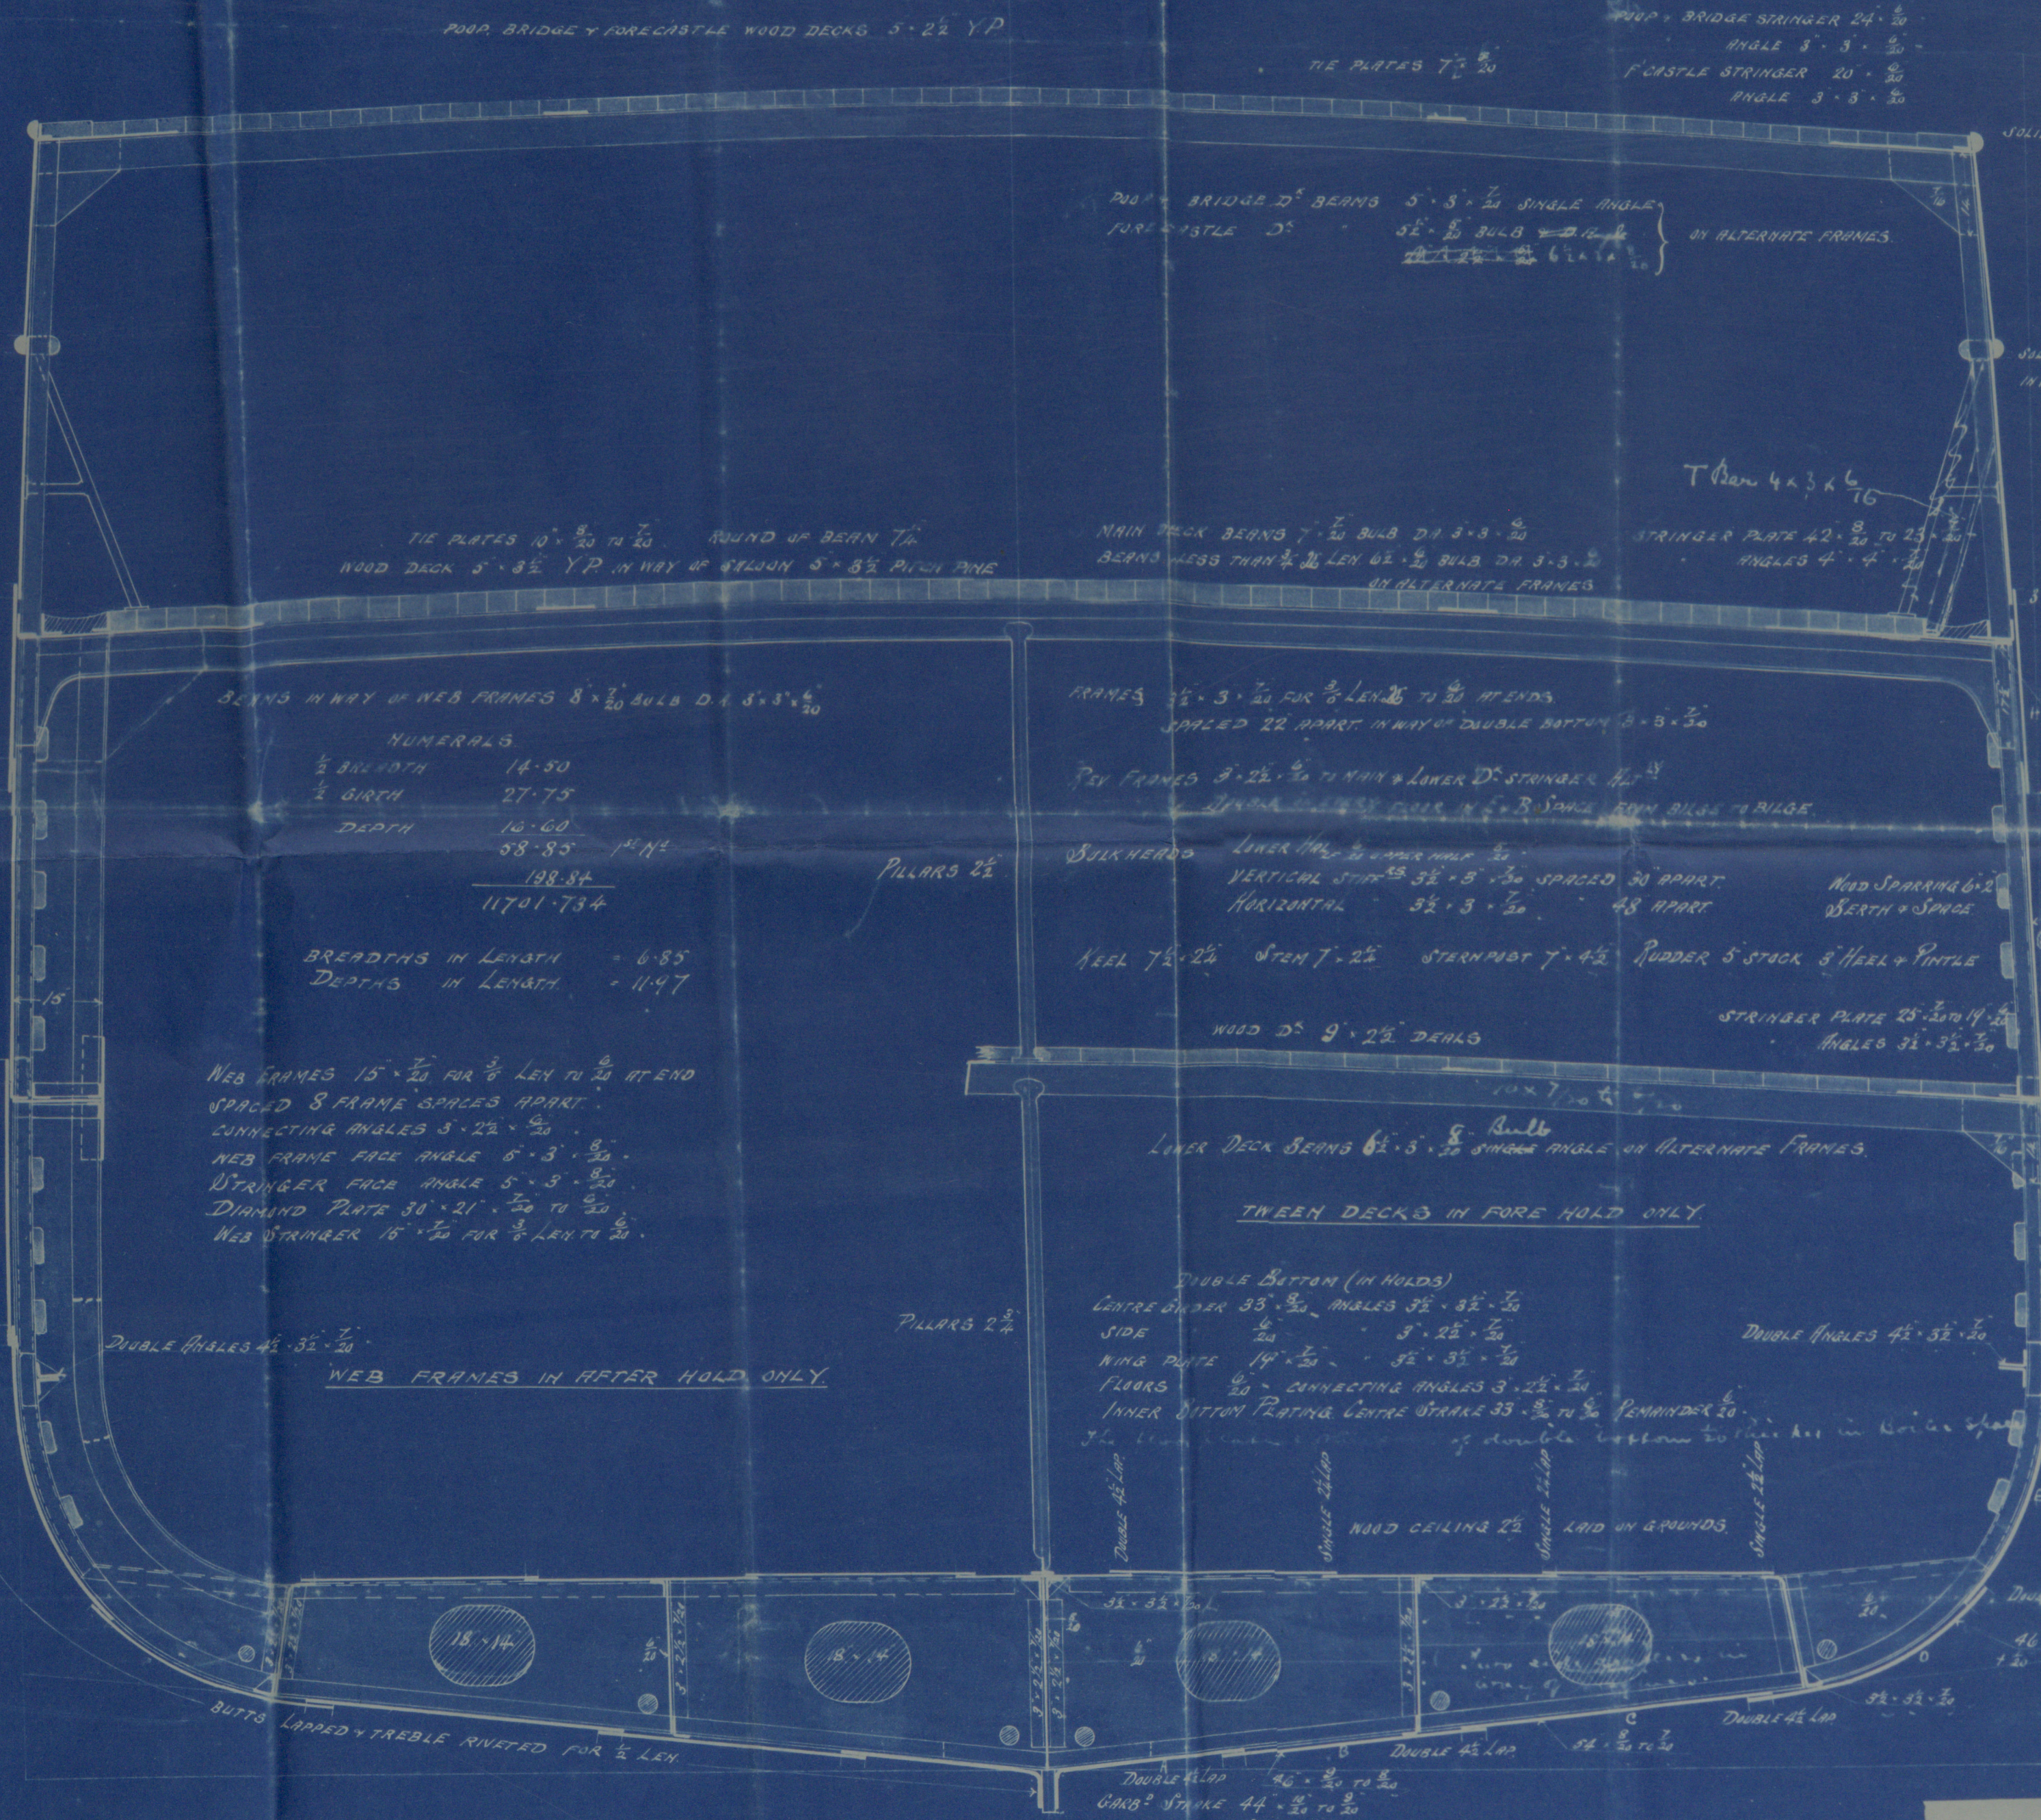

PLATING  
BASS PLATES OVERHANGING SCREW SHAFTS SAME THICKNESS AS STRAKES AND SHIP'S BOW THEY TURN PART -  
BASS PLATES CONNECTED TO STEEL FRAME BOWS THICKNESS AS STRAKES AND SHIP'S BOWS.

PLATING  
BUTTS OF SHEER STRAKES 1/2" THICKER THAN PLATING TABLE IN FOREHOLD BUTT JOINTS INSIDE PLATING TABLE 1/2" WHERE OVER WIDTH 4" 1/2" THICKER LAR BUTTS OF OUTSIDE PLATING TABLE RIVETED FOR 3' LEN. DOUBLE AT ENDS. MAIN DECK STRIKER PLATE LAPPED + DOUBLE RIVETED FOR 3' LEN. DOUBLE BUTT JOINTS.

DOUBLE BUTT JOINT  
BUTTS + EDGES OF MIDDLE LINE STRAKES AS RISE + RISE. DOUBLE RIVETED. PENETRATOR SINGLE RIVETED. BUTTS OF MAIN PLATE LAPPED + DOUBLE RIVETED. BUTTS OF CENTRE UNDER LAPPED + DOUBLE RIVETED.

PLATING  
SHELL PLATES 7' SPACES AND MORE LAPPED + RIVETED.

AFT END

14/94

See 16th April 94.





S. S. "Sofia"  
(sister ship of S. S. "Georgios")

Lth. Rept. No 7634



© 2020

Lloyd's Register  
Foundation

LTH564 - 0219