

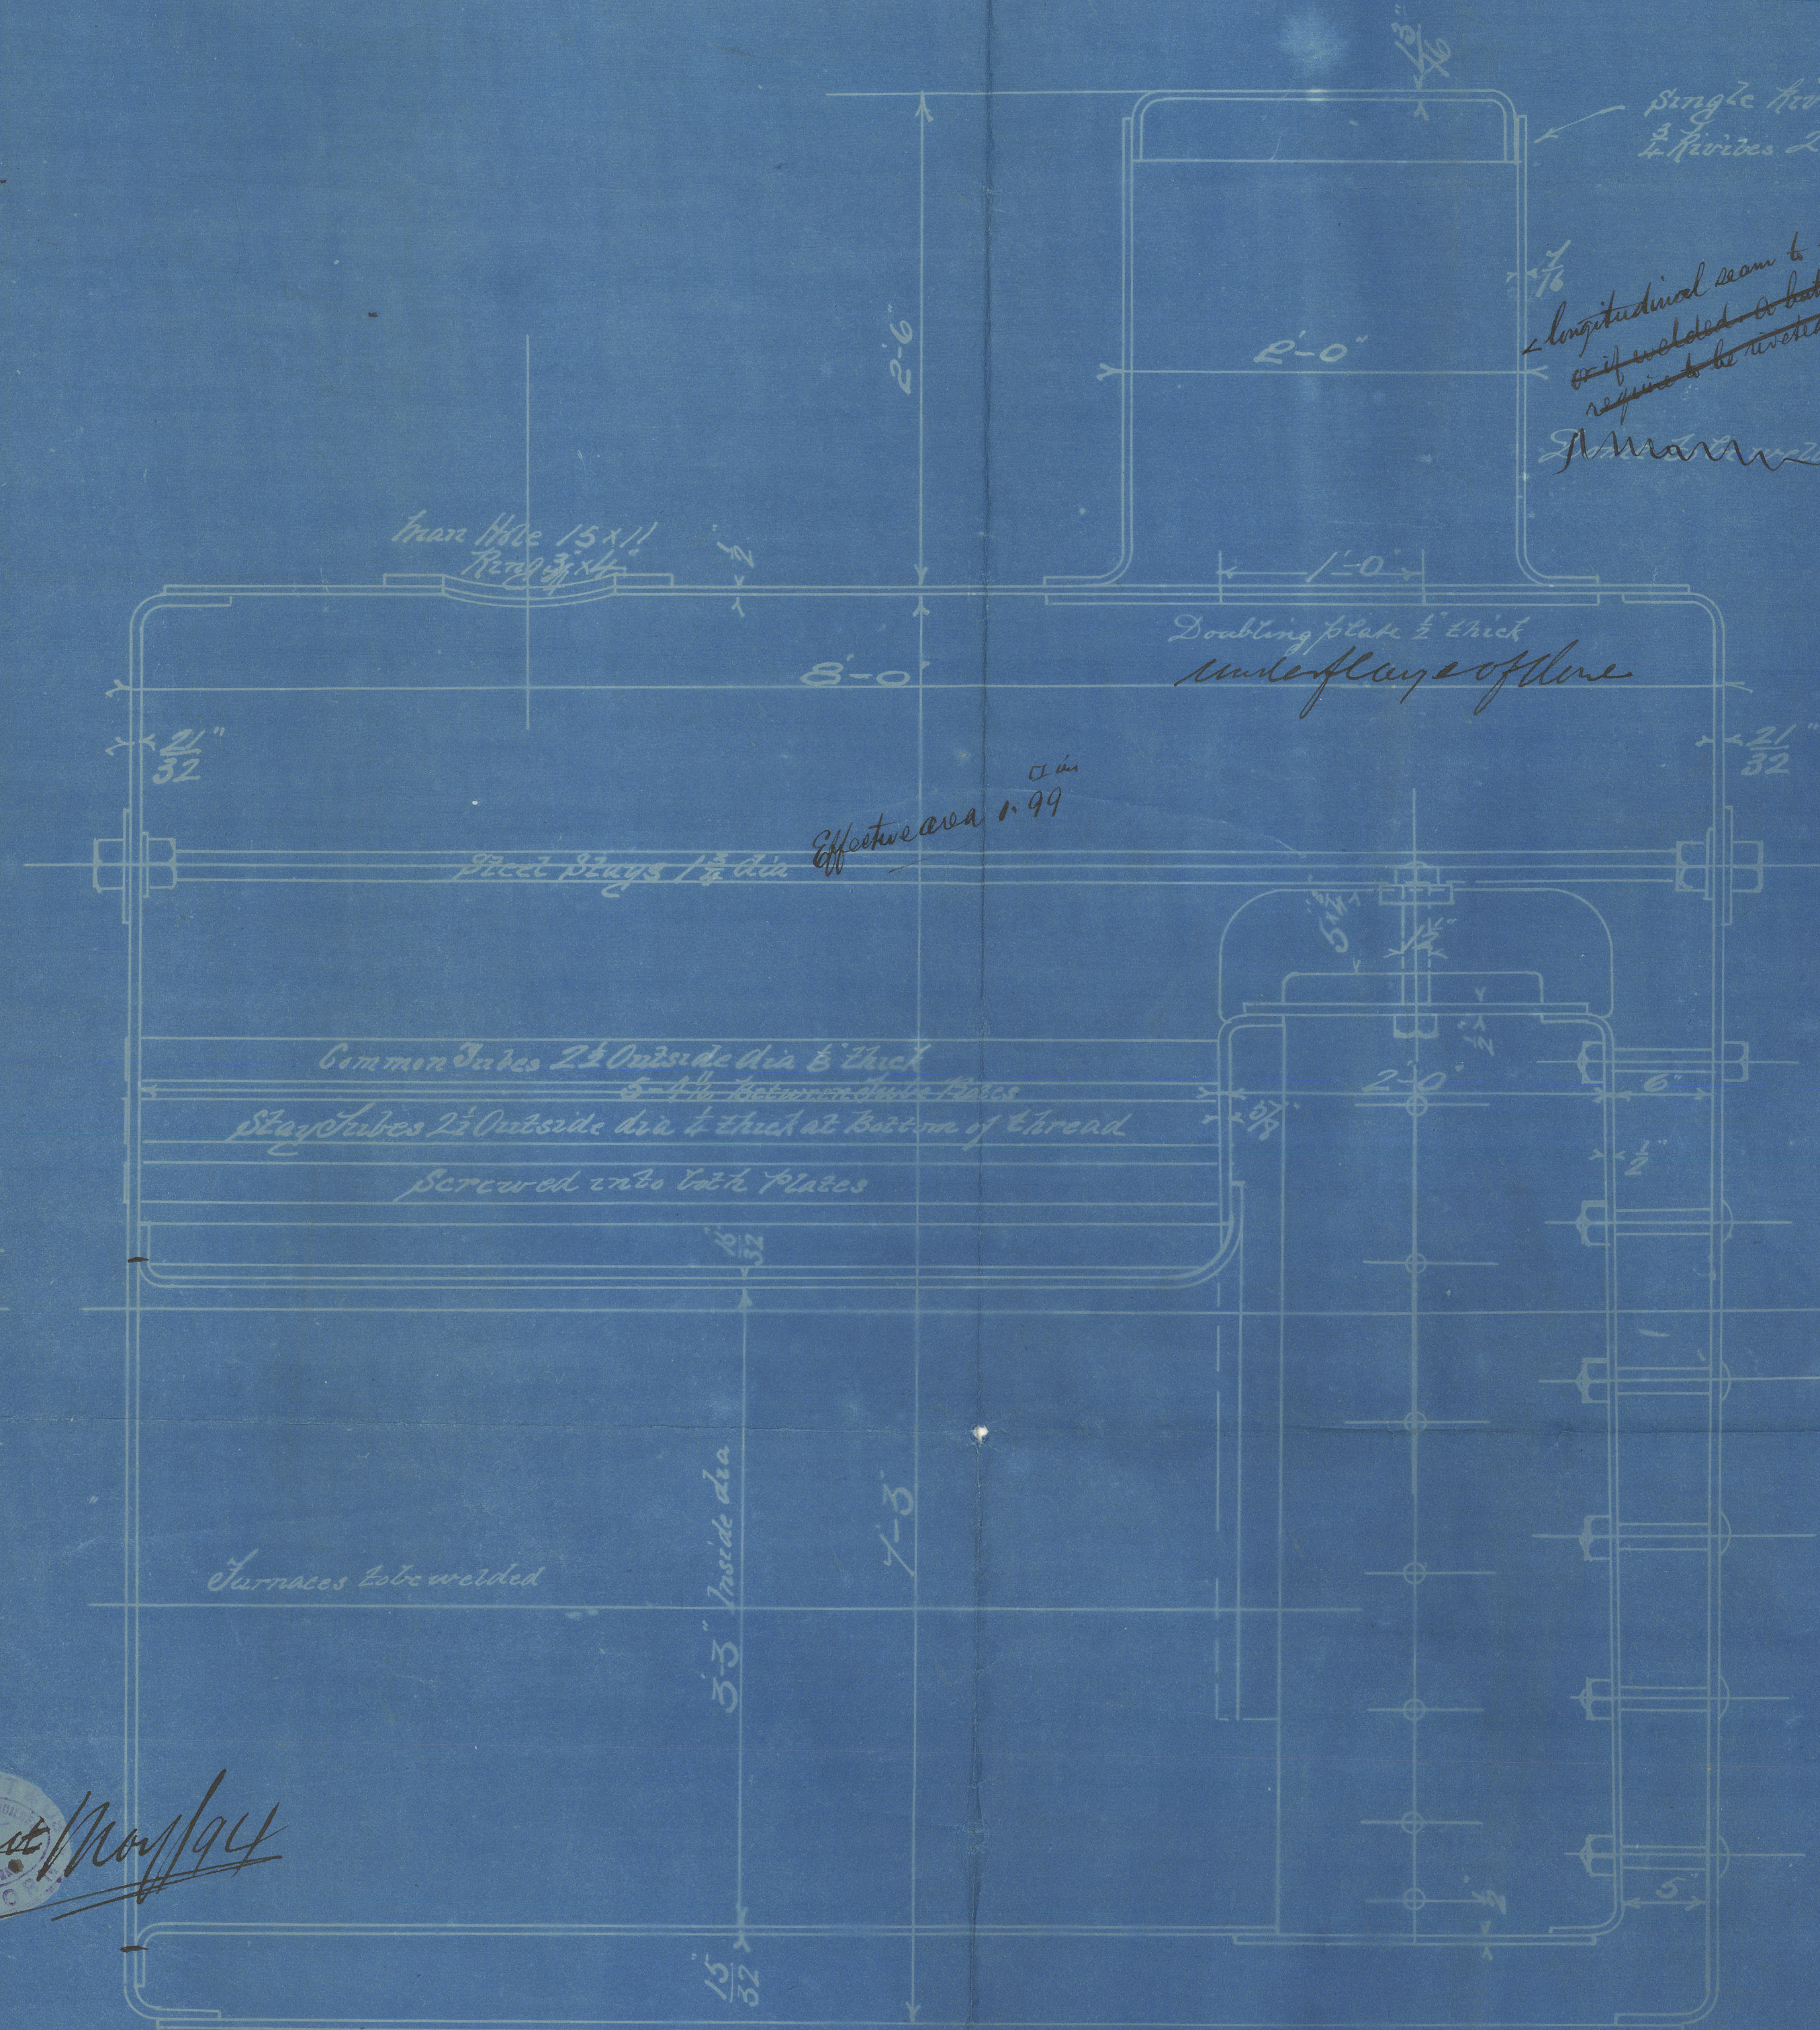



Chr. H. 6. 94

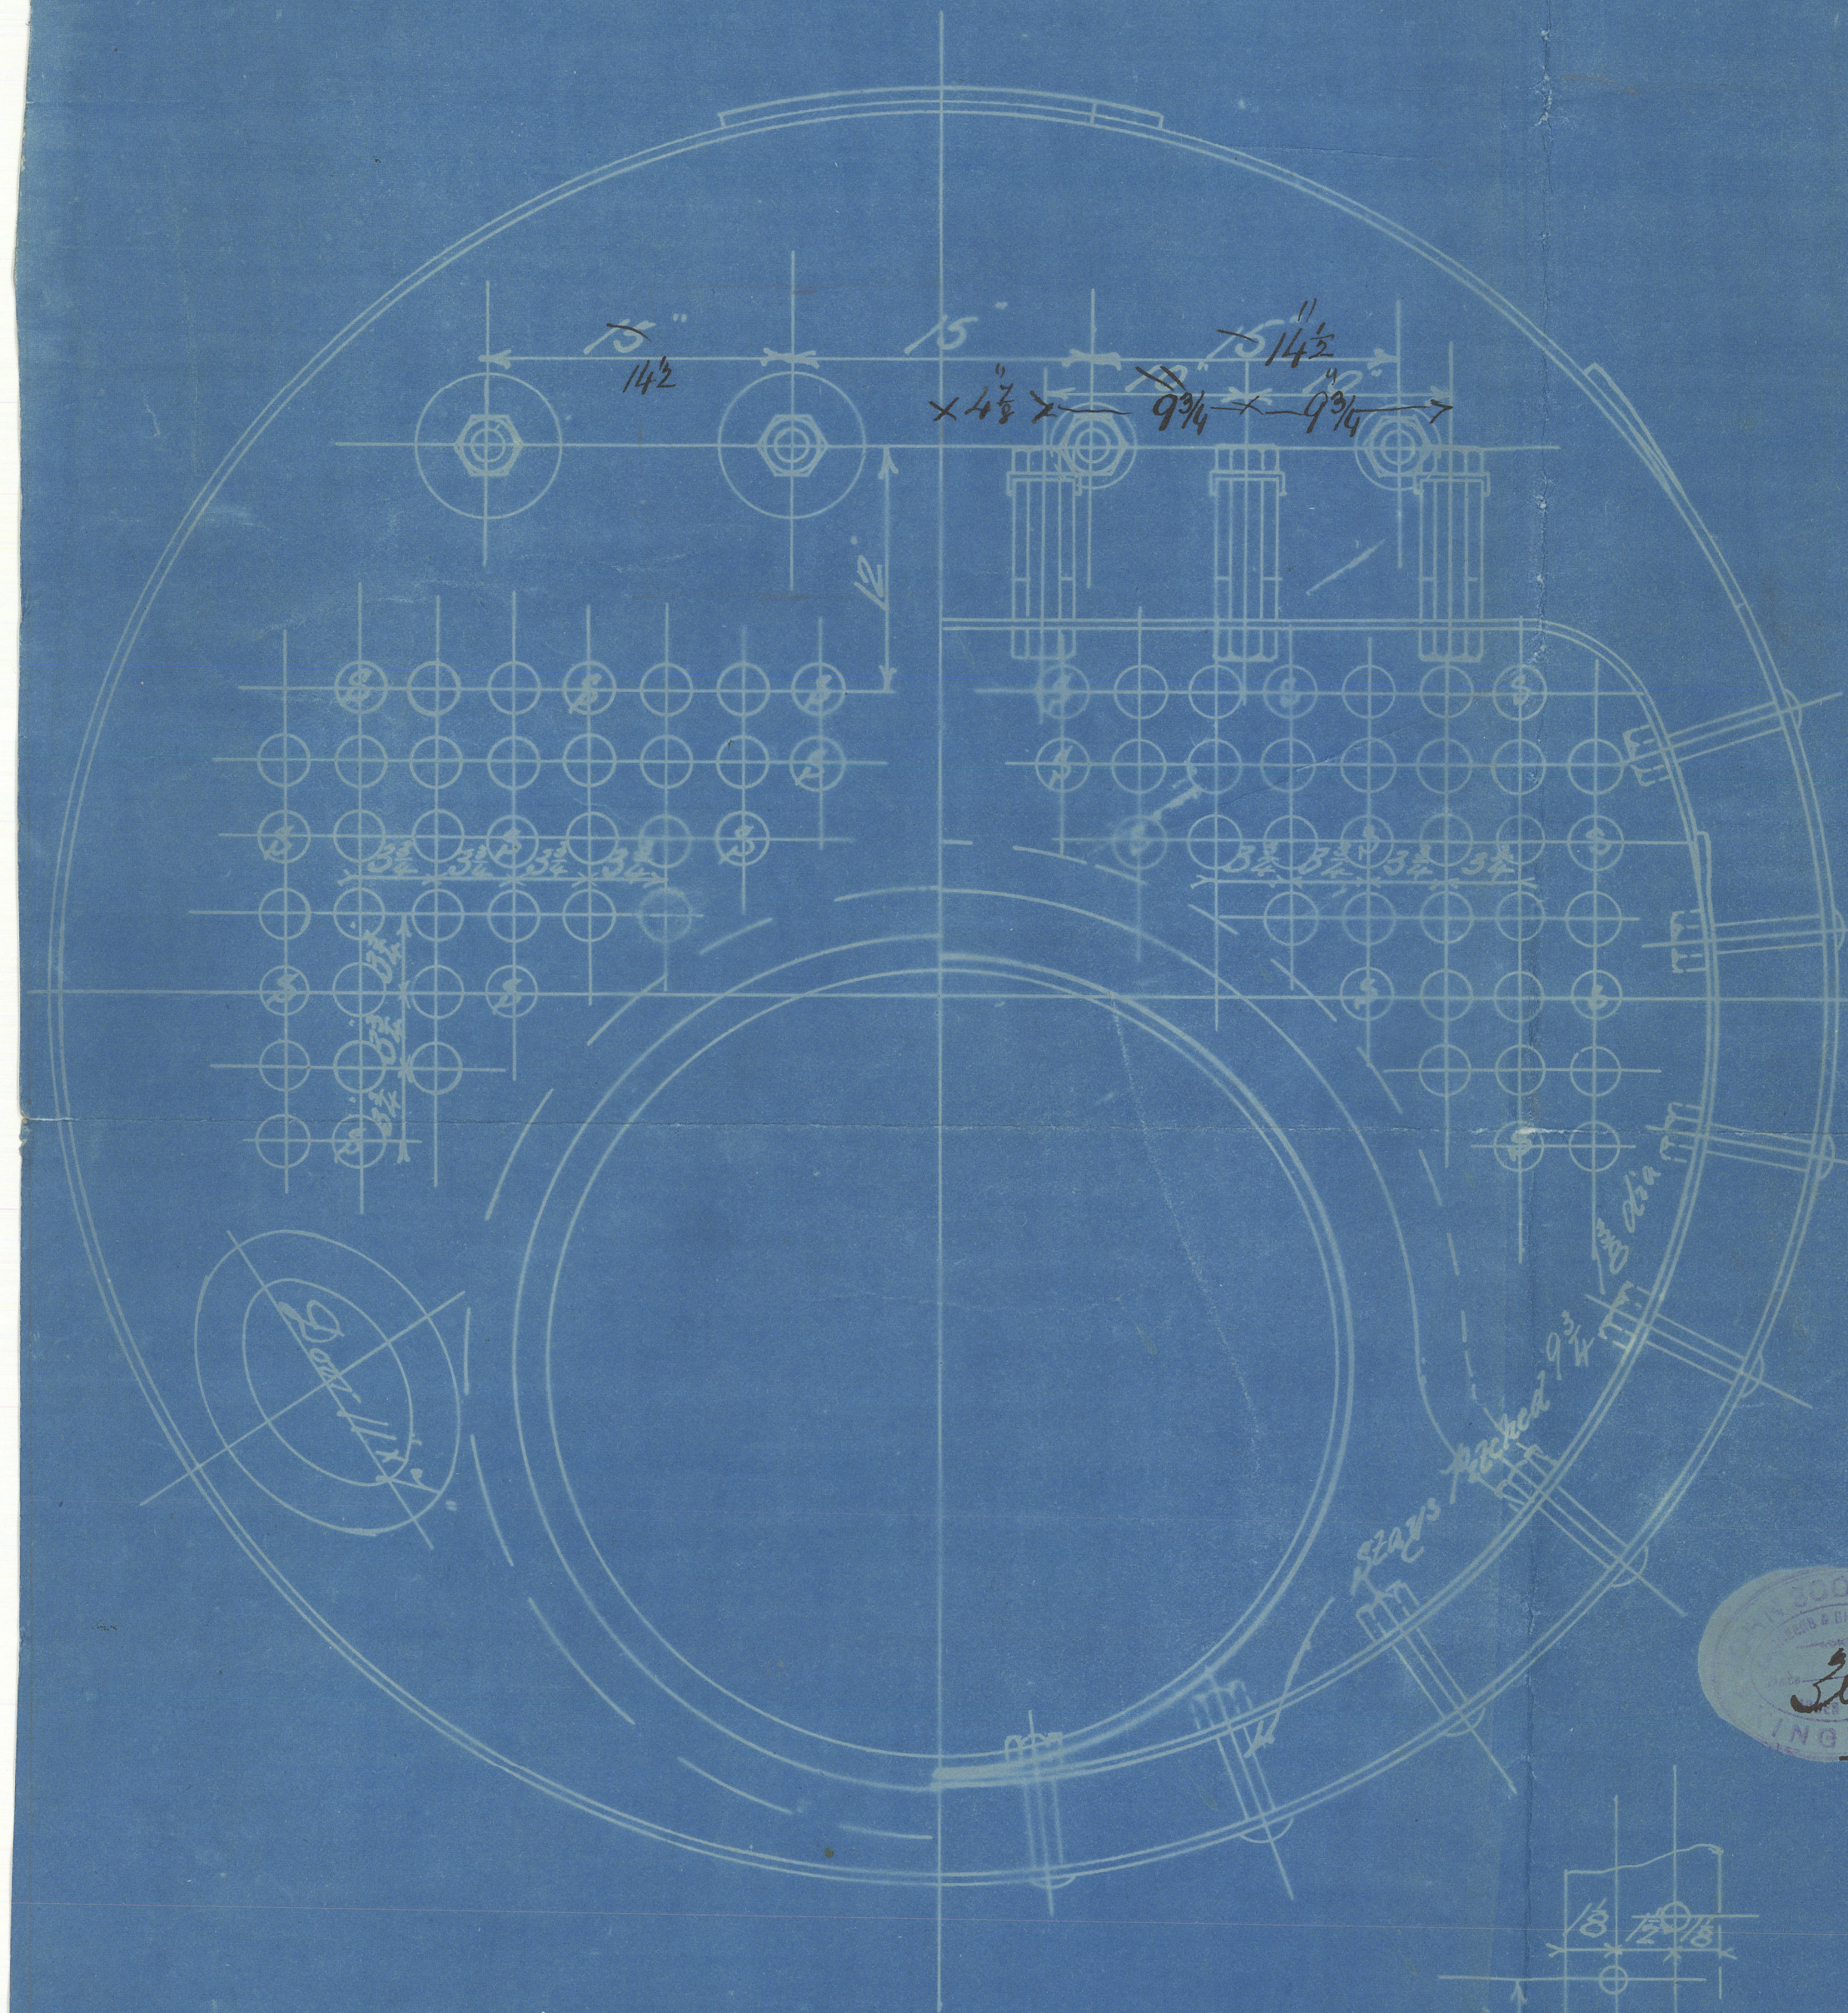

Single Riveted Landing
2 Rivets 2 1/2 inch
Longitudinal seam to be riveted same as lap joint
if welded to both stay pipes
required to be riveted over the weld
M.A.

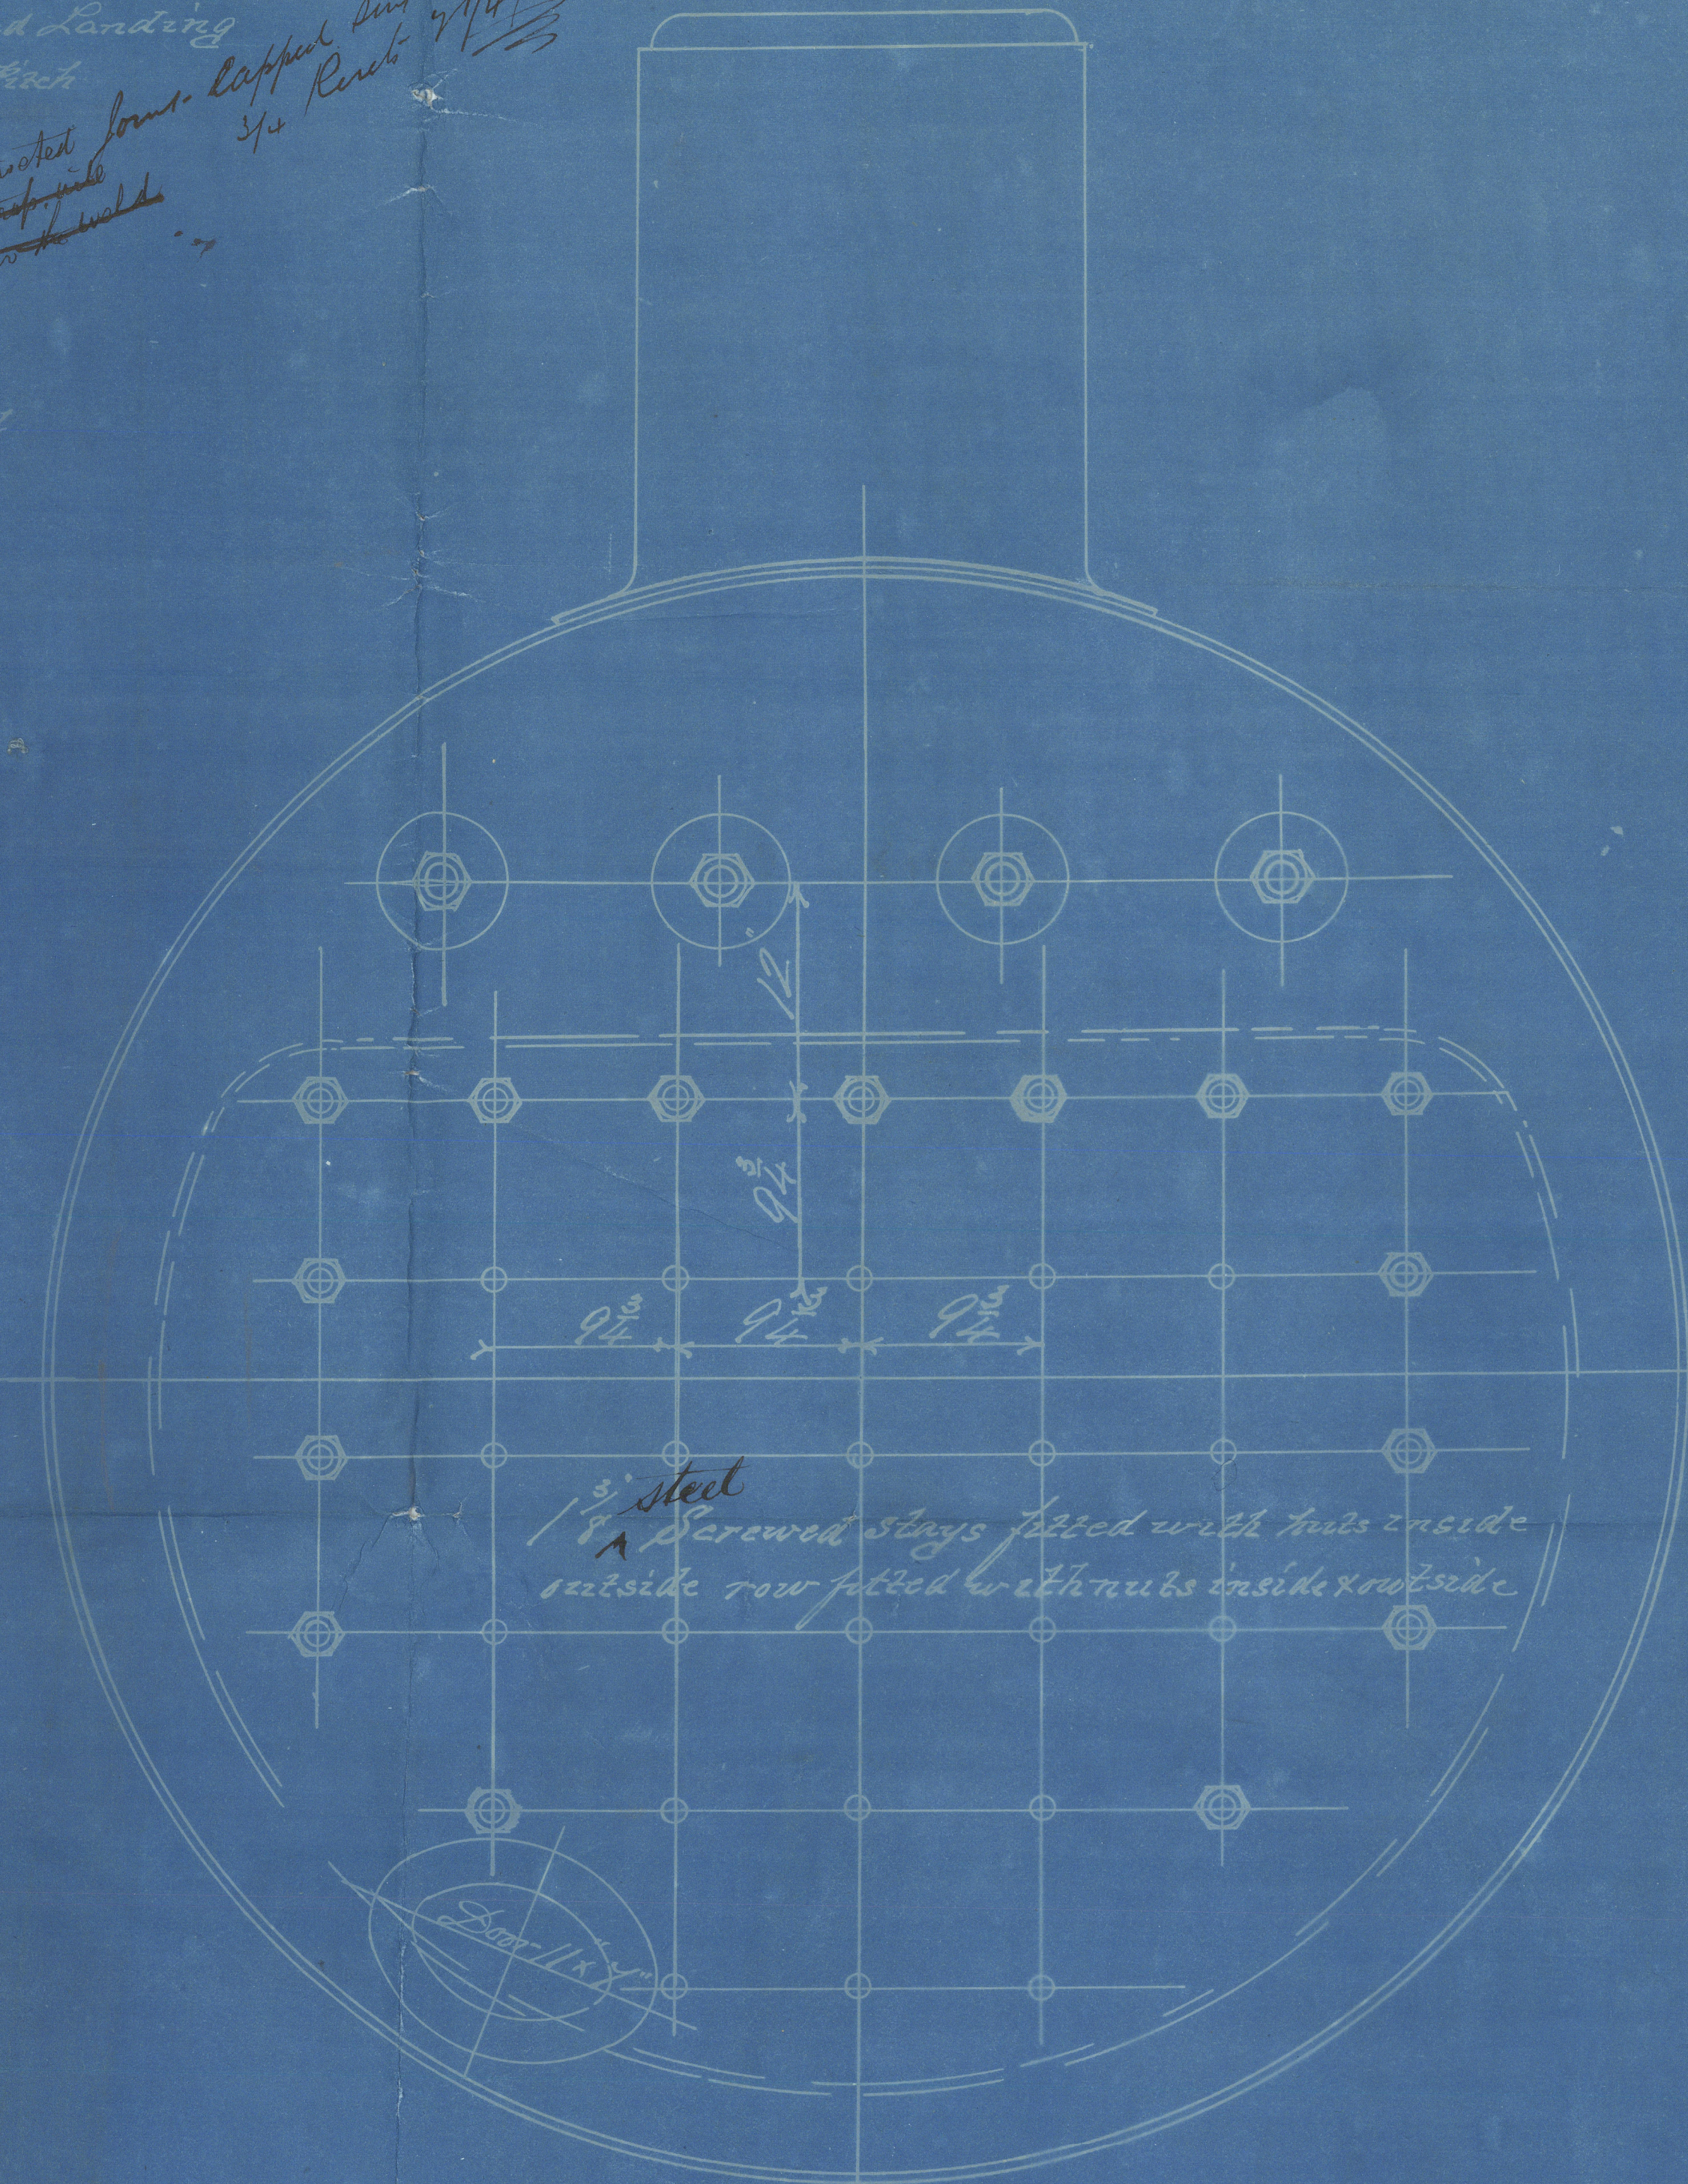

30th May 1914

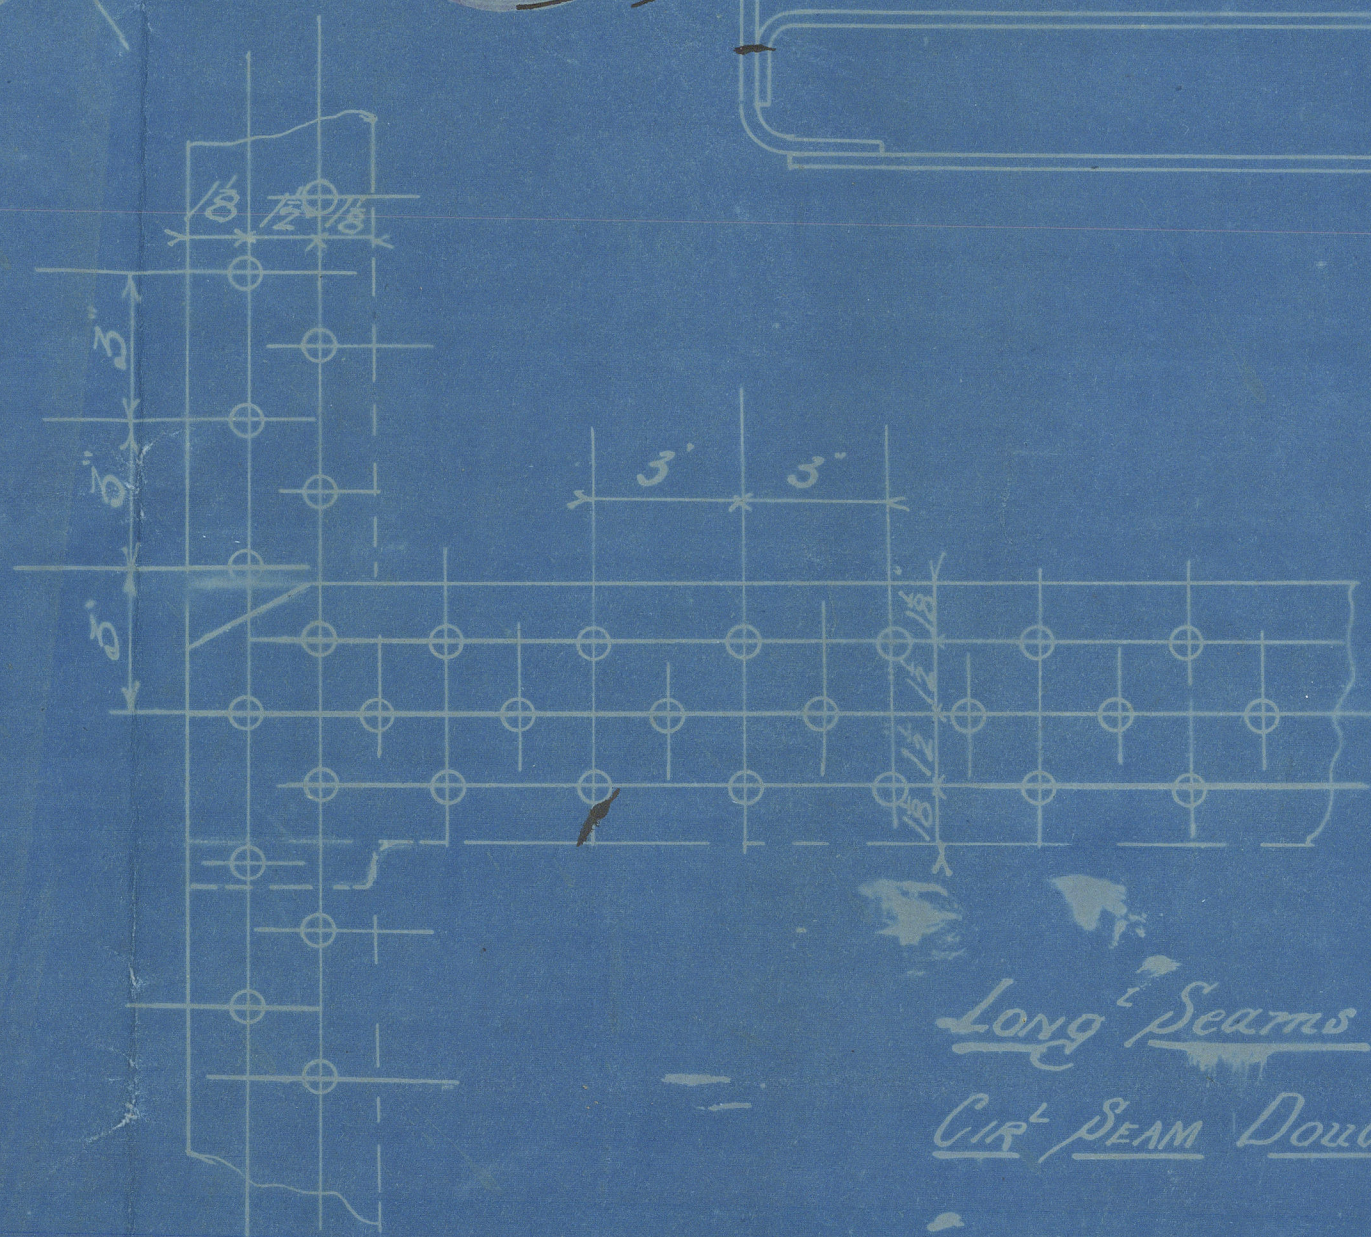

Steel throughout
except tubes.

Working Pressure 80 lbs per sq in
Tested to 160 lbs per sq in


M.A.
1.6.94

Long Seams Double Riveted Lap joint 2 Rivets 2 1/2 inch when finished Pitch 5
Circ Seam Double Riveted 2 Rivets 2 1/2 inch

31/5/1914

DONKEY BOILER N° 89 & 90
Scale 1/2" = 1 Foot

Enclosure
for Lloyds
Leith Report 7880

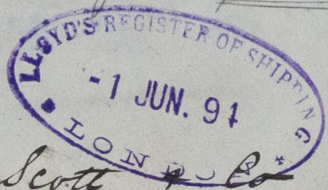

J. Scott & Co

Houlley Boiler
for

S.S. No 89 & 90

No. 89

No 341
Hyd test
160 lbs
M.R. 14.1.95

No. 90

No. 343
Hyd test
160 lbs
J.L. 22.1.95

LT 565-0094



© 2021

Lloyd's Register
Foundation