

Lloyd's Register of British and Foreign Shipping.

(Report on Vessel No. 7880 Port Leith)

No. _____ SHIP FORGINGS OR CASTINGS.

I have to report that the undermentioned Iron or Steel Forgings or Castings, manufactured by

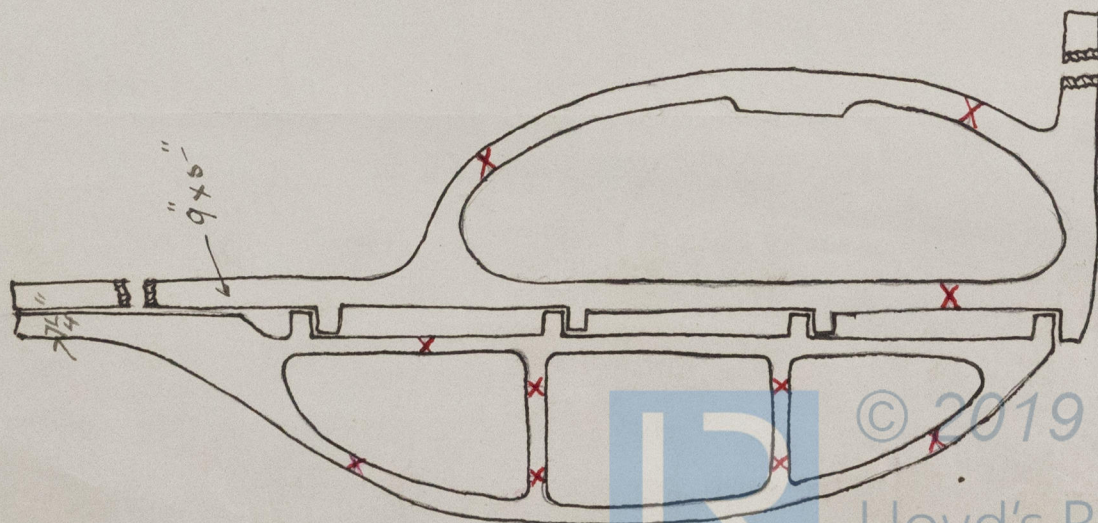
The Life Forge Coy of Sanclari town
 for the Vessel No. 90, being built by Imp^r L. Scott & Co
 of Slingshorn have been inspected by me as set forth below, and found
 to be, so far as can be seen, sound.—

Mark on Forgings.

 Lloyd's
 No. _____

Thomas Field
Leith

| | STERN FRAME. | RUDDER FRAME. | STEM. |
|--------------------------|-----------------------------|-----------------------------|-----------------------------|
| Material* - - - | <u>Scrap Iron</u> | <u>Scrap Iron</u> | <u>Scrap iron</u> |
| How made - - - | <u>Forged & smithed</u> | <u>Forged & smithed</u> | <u>Forged & smithed</u> |
| Dimensions - - - | <u>9" x 5"</u> | <u>7 1/4" x 3 1/2"</u> | <u>9" x 2 1/2"</u> |
| Progress on Inspection - | <u>Rough & finished</u> | <u>Rough & finished</u> | <u>Forged</u> |
| Dates when Inspected | <u>22/1/95</u> | <u>24/4/95</u> | <u>29/6/94, 13/8/94</u> |

 SKETCHES OF FRAMES SHEWING POSITION AND DESCRIPTION OF WELDS OF FORGINGS, OR PARTICULARS OF TESTS
 APPLIED TO CASTINGS.


Lth. Repot. N^o 7880

© 2019

Lloyd's Register
Foundation