



(Lister Ship to L.S. "Benshaw" Lth. Rept. No. 7742.)

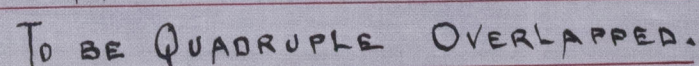

S. S. "Benhead"
 Lth. Report. No. 7880.

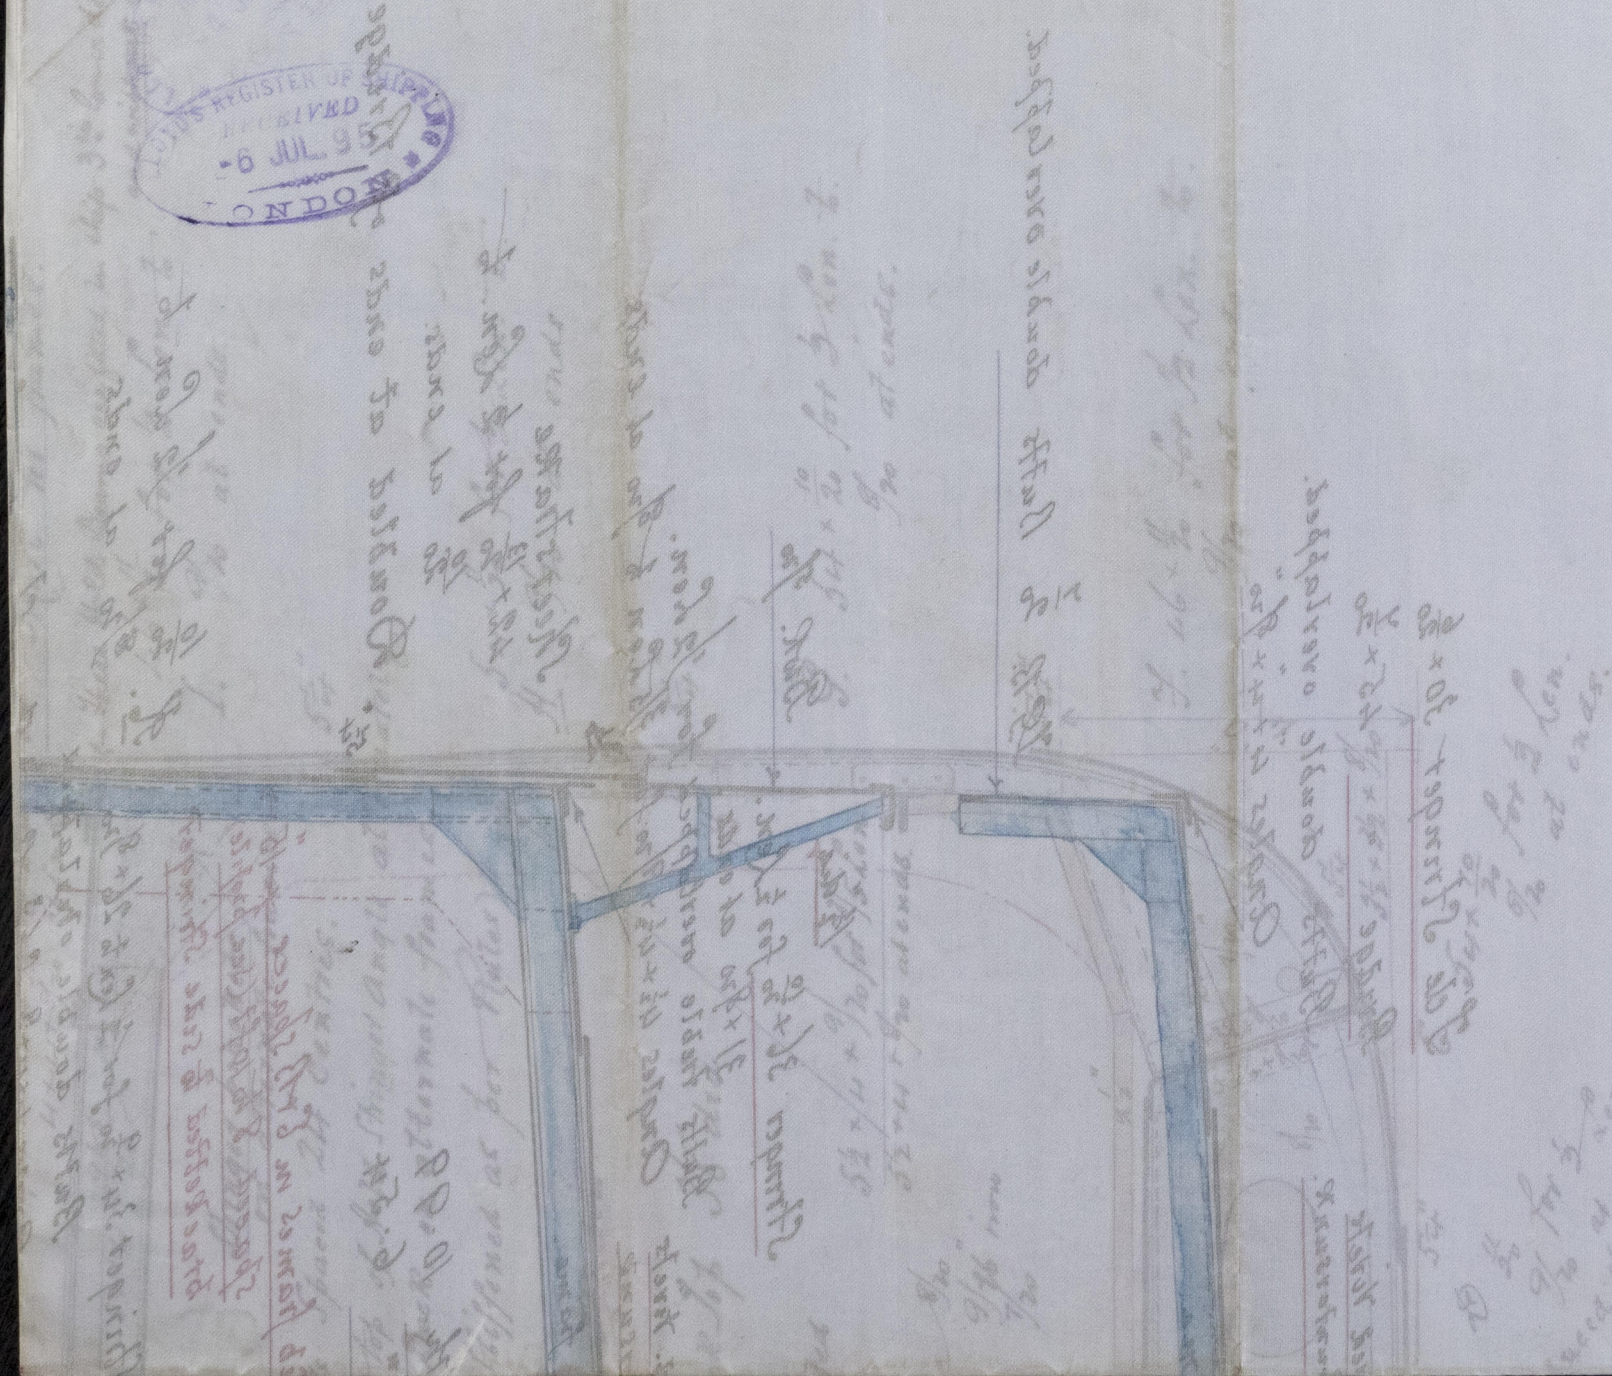

All BUTTS of SHELL PLATING.

FROM B STRAKE TO SHEERSTRAKE. (INCLUDE.)

TO BE TREBLE OVERLAPPED FOR WHOLE LENGTH.

BOTTOM PLATING WERE OVER RICE BRACKETS.


Mr. Report No.

"Benhead"

April 25



© 2019

Lloyd's Register
 Foundation