

19.1.95  
Proportions  
5.61 breadth  
6.93 depth

S. P. 11-92

Midship Section

Length R.P. 66' Breadth 18' Depth 9'0"

1/2 Breadth	9.00	1/2 Breadth mooy of R. Q. D. 9.00	
1/2 Depth	17.12	1/2 Depth	19.82
Depth	9.37	Depth	12.52
1st Numeral	35.49	1st Numeral	40.84
	65		65
	174.45		204.20
	2129.4		2450.4
	2306.85	2nd Numeral	2654.60
	3389	Equip. Numeral	

Class

A.1. Steel Steam Lighter

N<sup>o</sup> 92

Longitudinal Section & Deck Plans



of Steam Packet Vessel

Length L.P. 66 ft. Breadth 18'0" Depth 9'0"

Scale 1/4" = 1 foot

S.S. Lighter "Raith"

Rev. Rept. N<sup>o</sup>

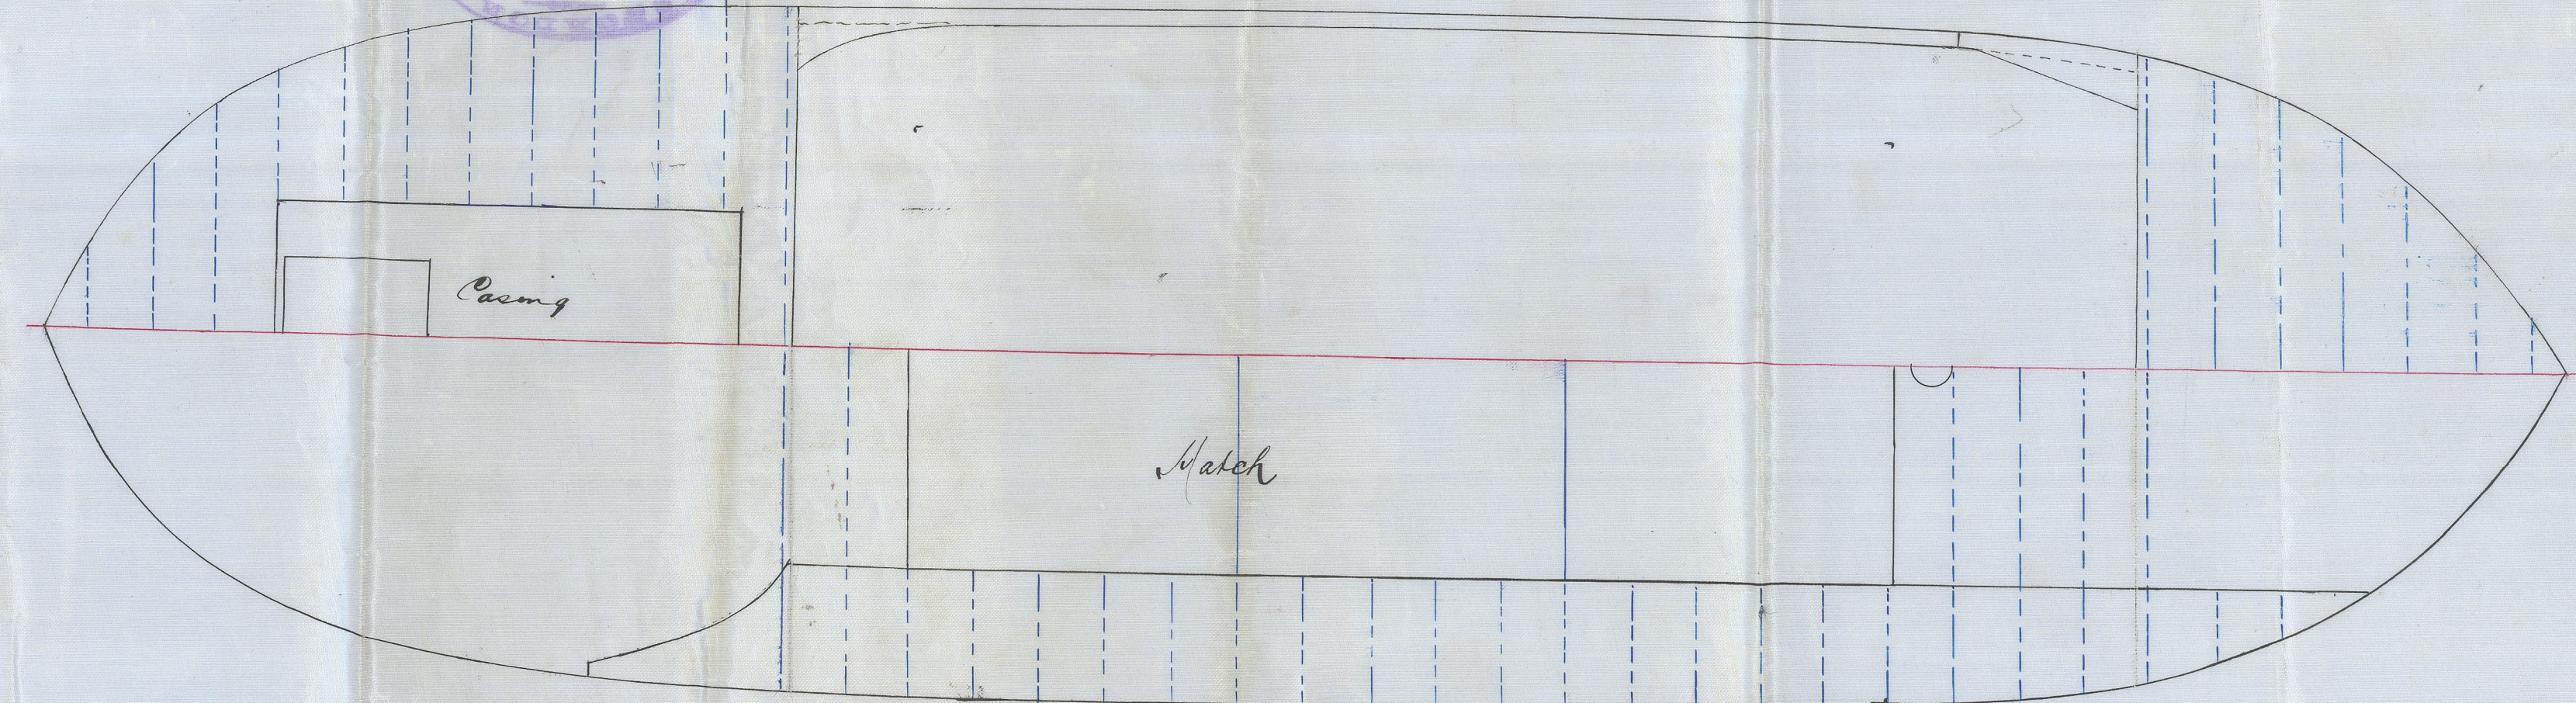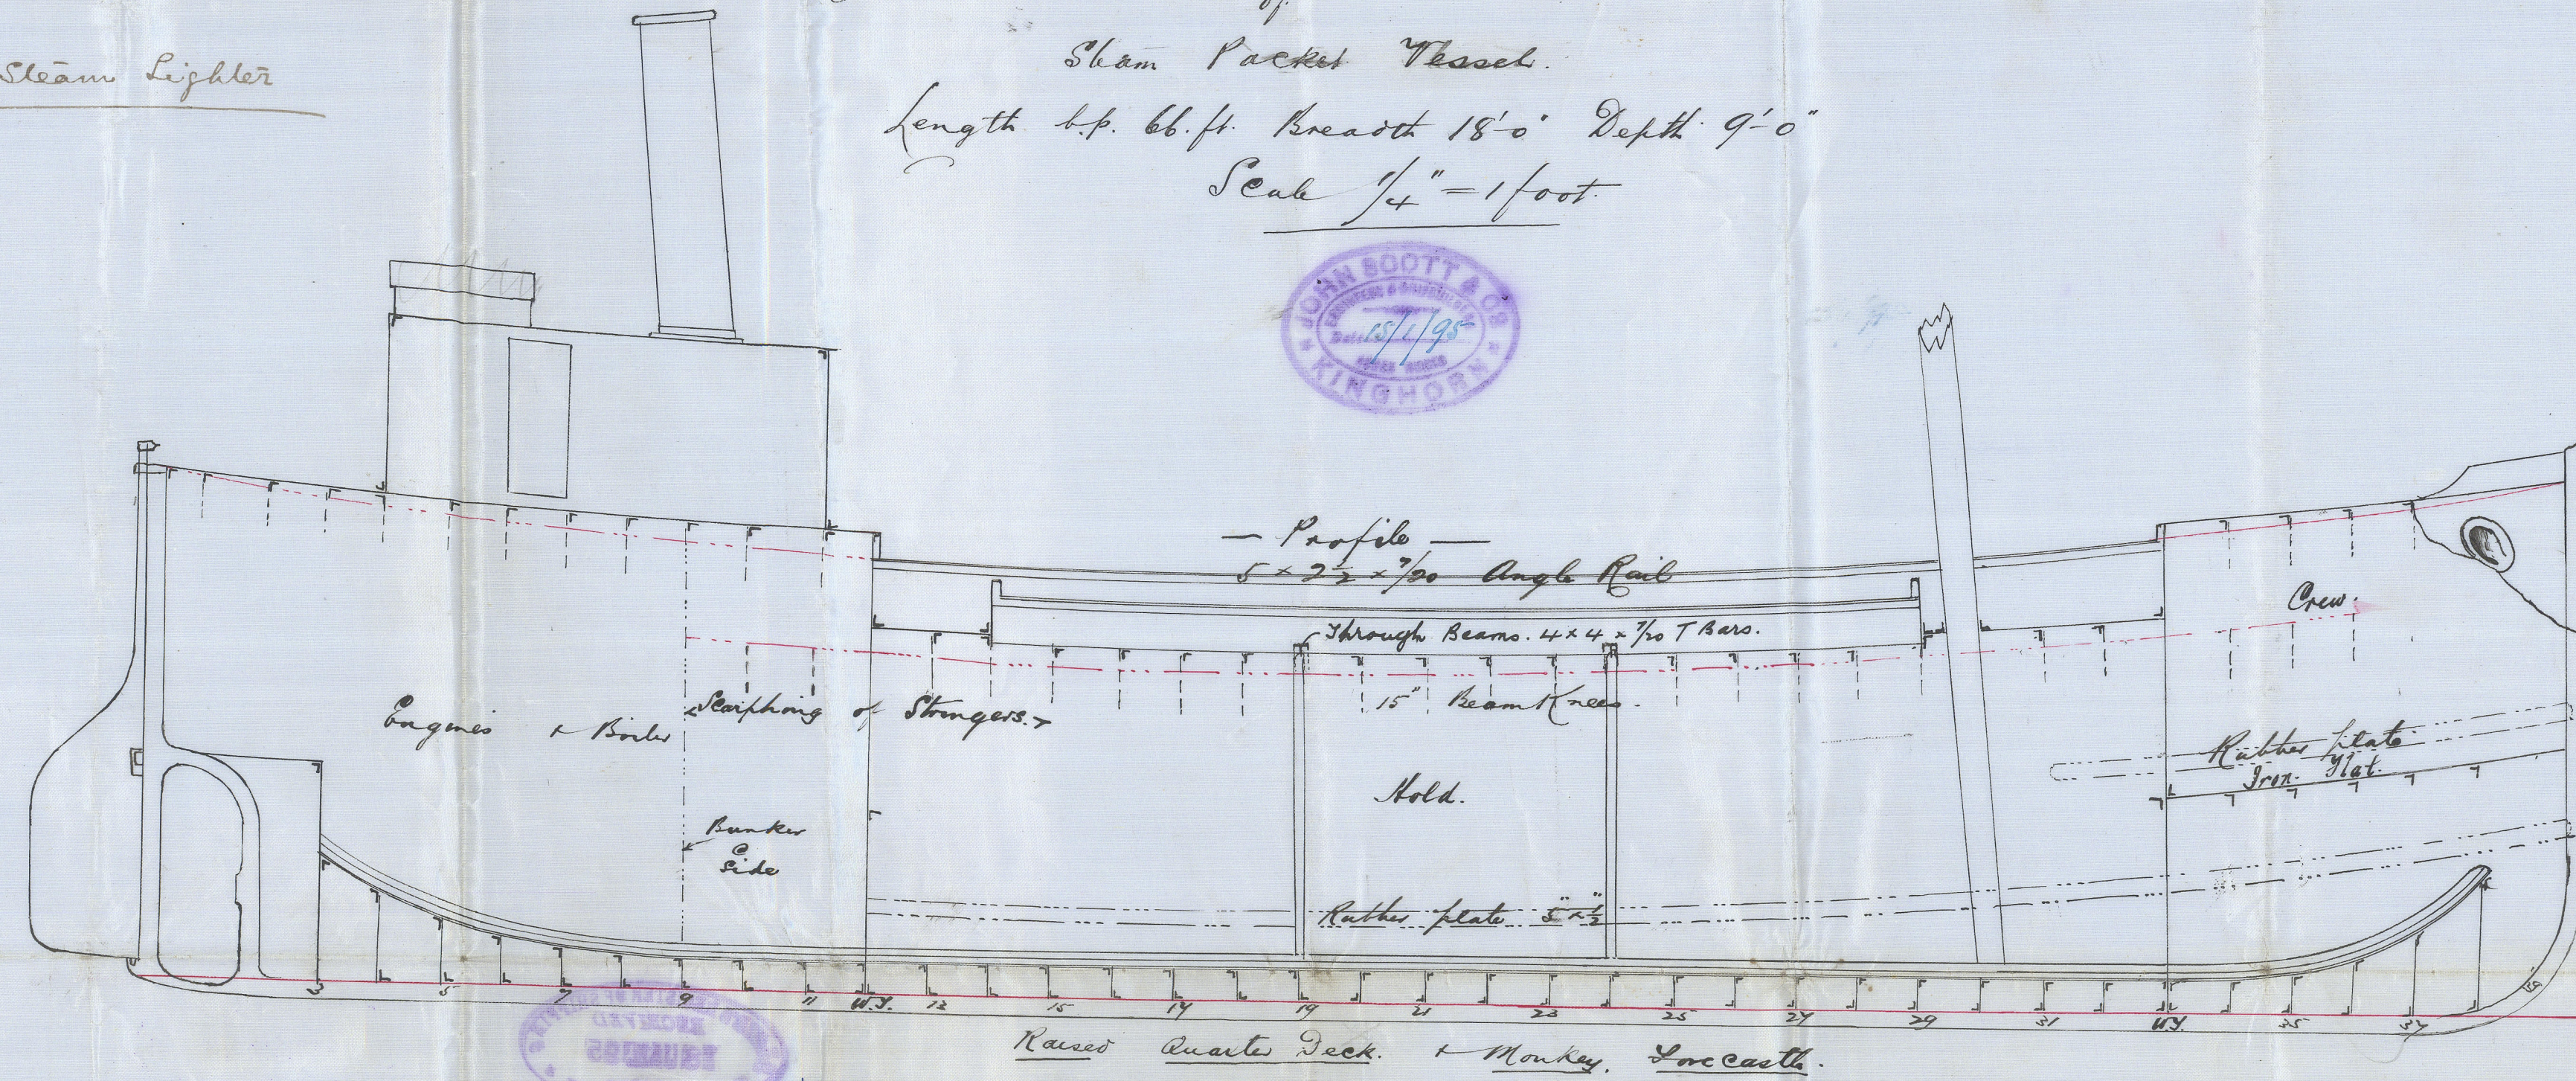


Particulars

Frames 3 x 3 1/2 x 7/16 spaced 20" apart throughout.  
R.P. Frames 3 1/4 x 3 1/4 x 7/16 extending to Deck & tops of Bilge alternately  
Floors 11 x 7/16  
Keel 5 x 1 3/8 Stem 5 x 1 3/8 Stern post 5 1/2 x 3 1/4  
Rudder 1/4 lead 2 1/8 Pintled 2"  
Plating All shell plating overlapped double butts  
Backheads 7/16 Stiffeners 3 x 2 1/2 x 7/16 angles spaced 30"  
Equipment 1 Bower 4 cutts & 1/2 stock  
1 Kedge 2  
30 fms 3/4 chain cable  
30 " 1/16 steam chain  
1 trap 60 fms 5/16 manilla  
90 fms 3/16 45 fms 2 1/2

6 x 3 1/2 x 7/16 Bull angle  
3 x 3 x 7/16

Ceiling 2 1/2

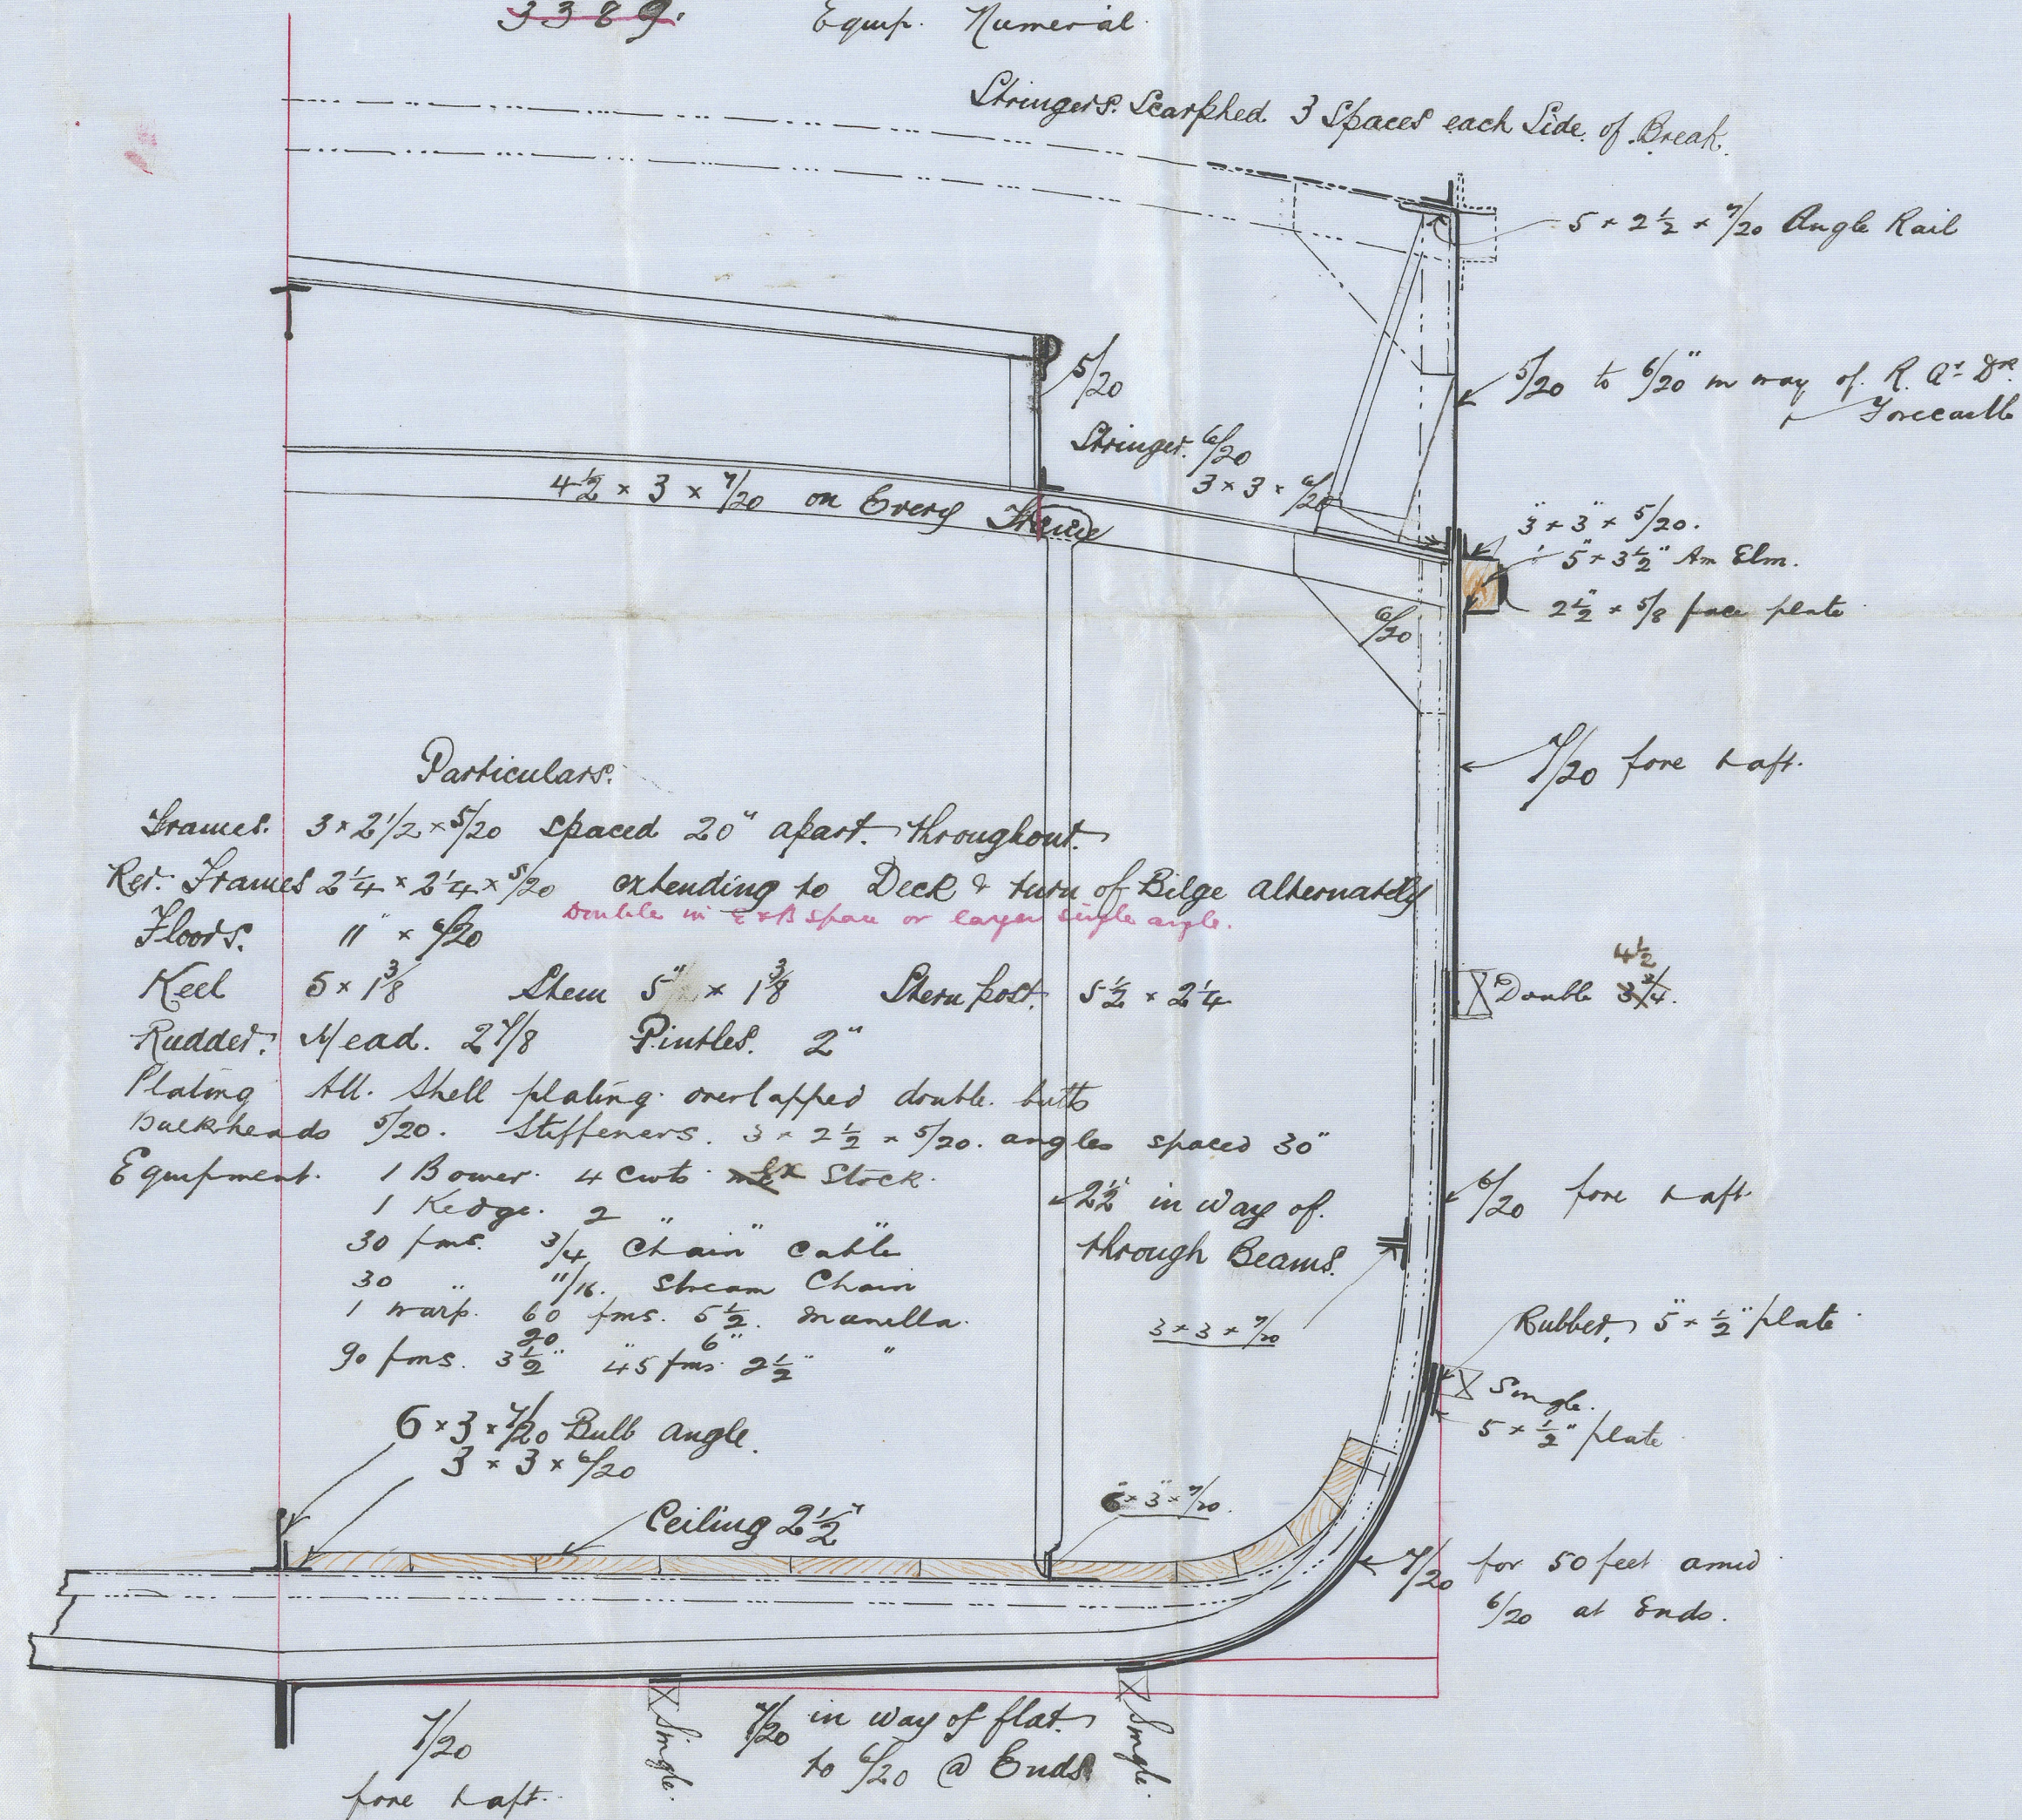

18M  
19/1/95



174 Jan 95  
2.2.1905




S. S. Lighter "Raith"

Lth. Rept. No: 7889



LTH565-0112

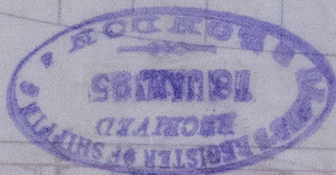

© 2021

Lloyd's Register  
Foundation