


S. S. "Minnie"
Lth. Rept. No 7903

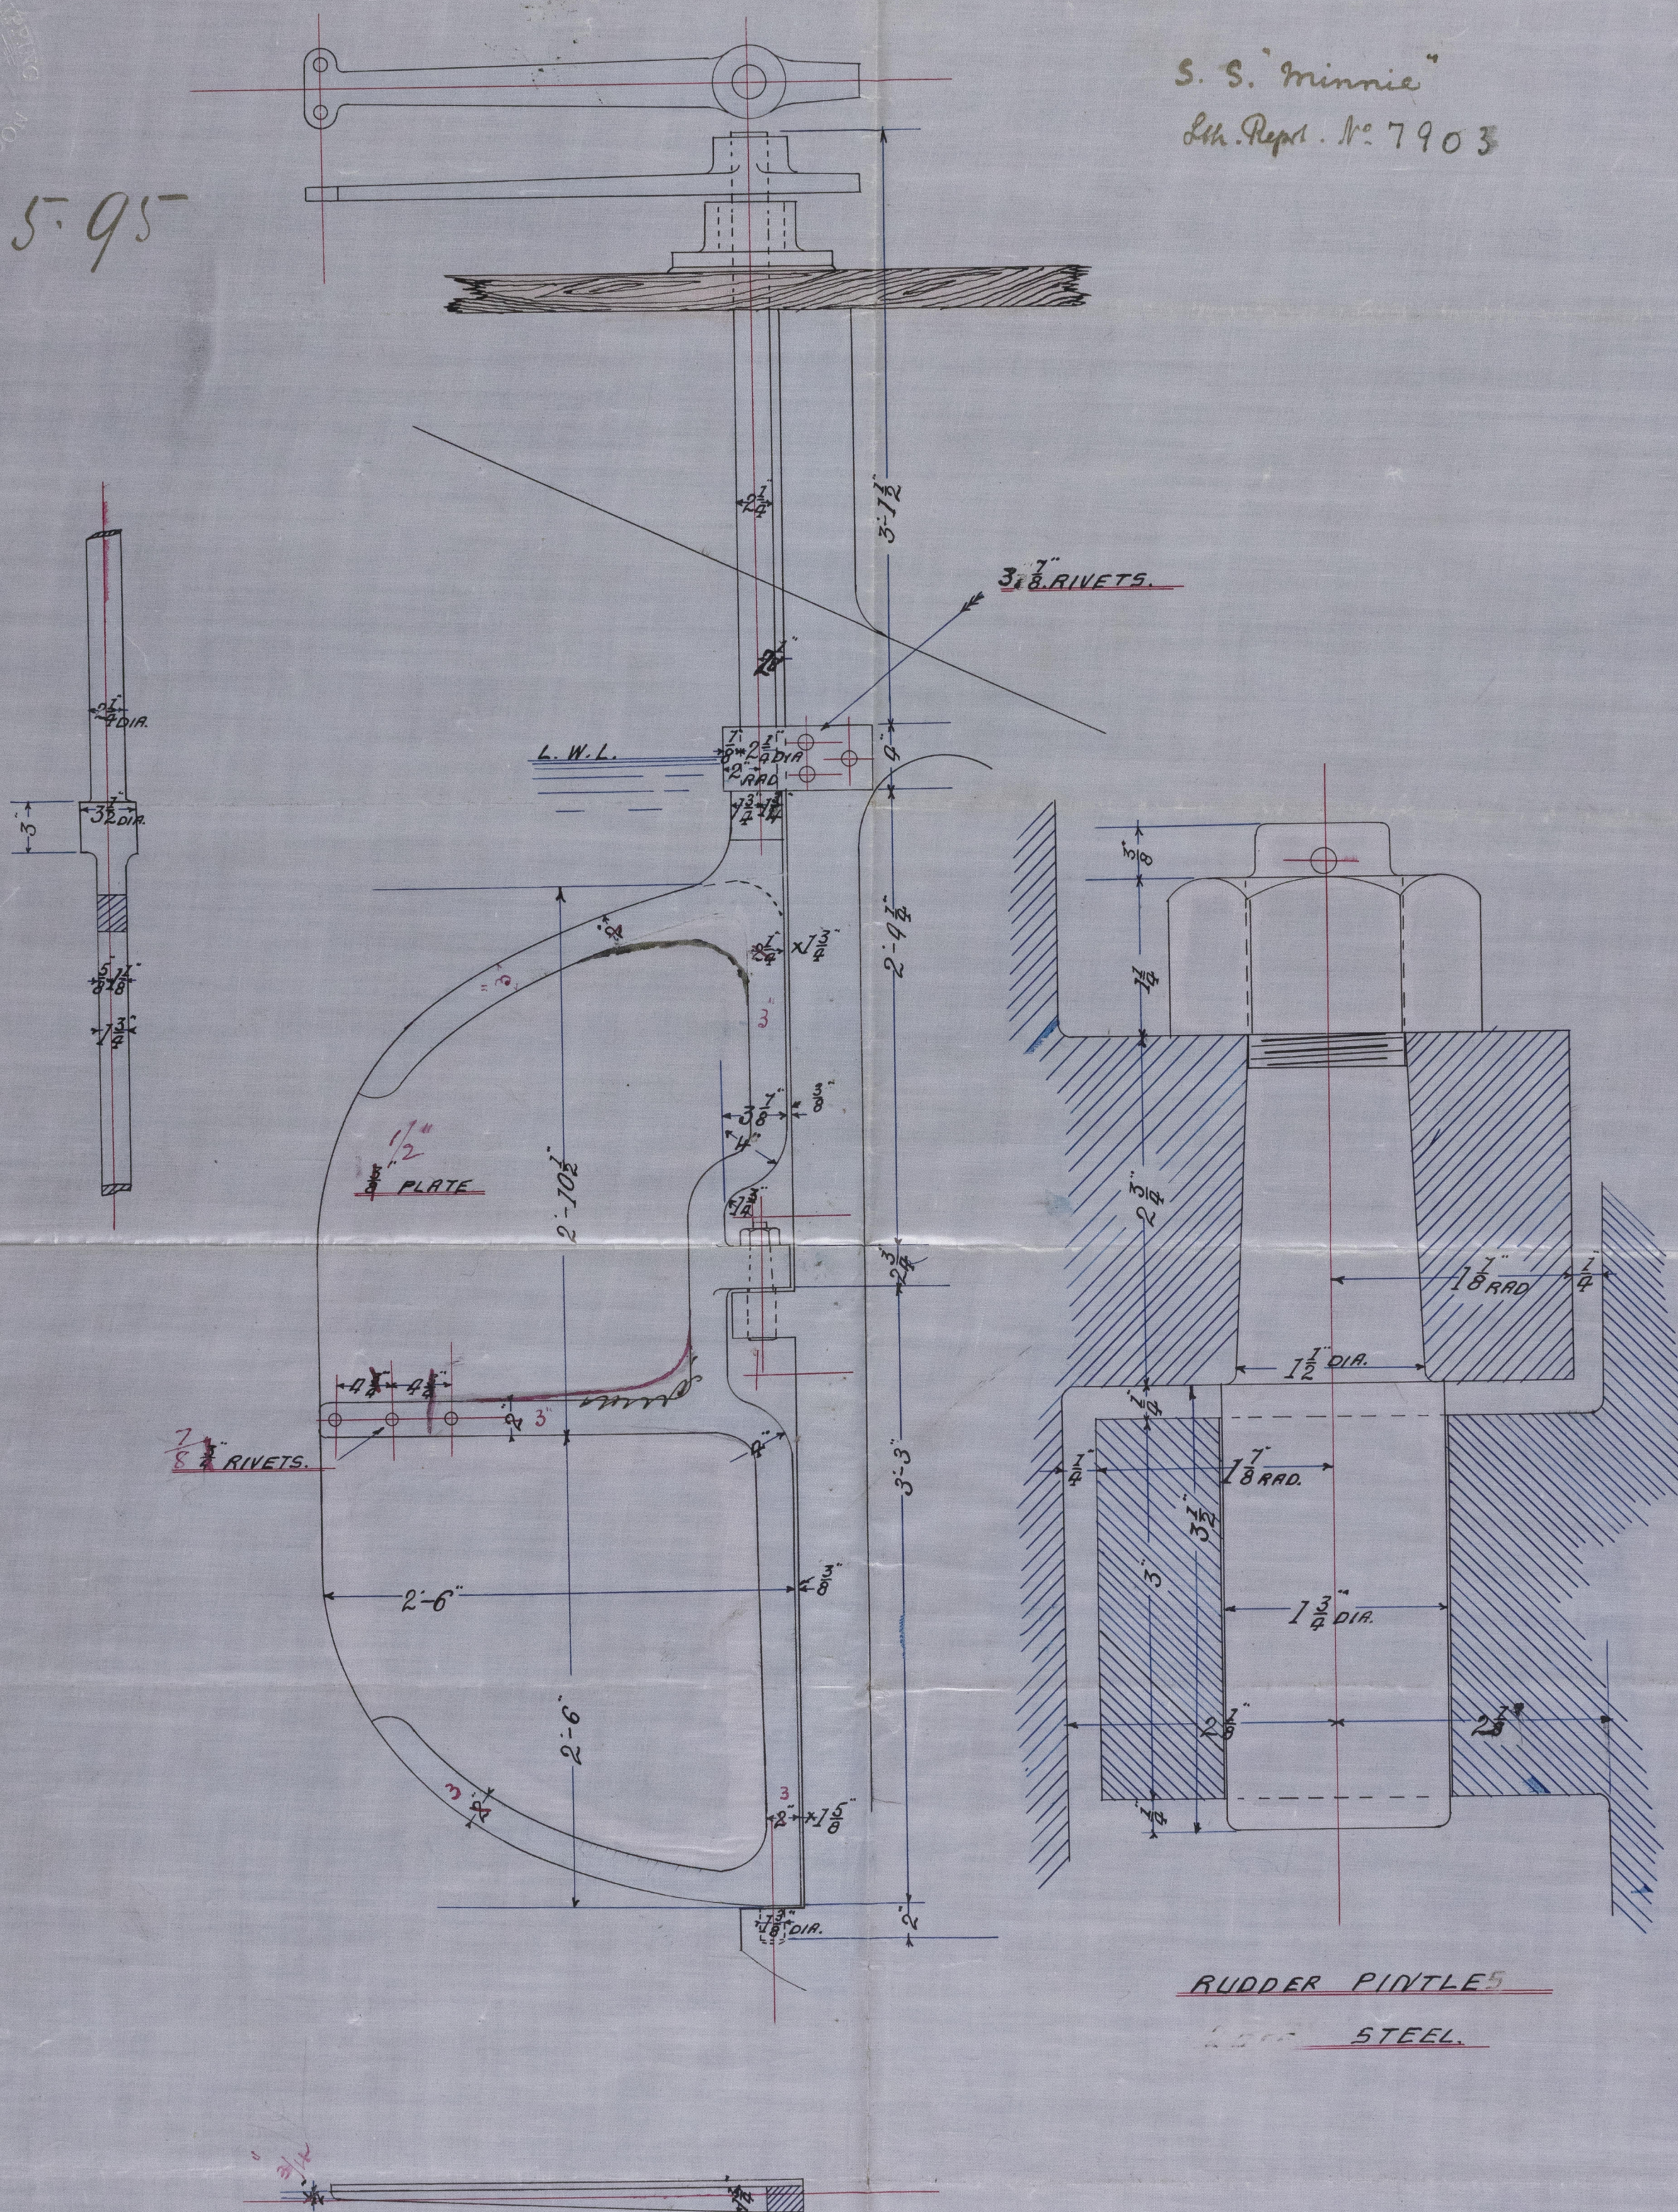

RUDDER PIVTLES

STEEL

Rudder

FOR

FOR
STEEL SCREW TUG FOR MANCHESTER SHIP CANAL


UFGFEE 14th 35-63

SCALE $1\frac{1}{2}'' = 1 \text{ FOOT.}$

22/5/95

S. S. Minnie

Estm. Repert. № 7903

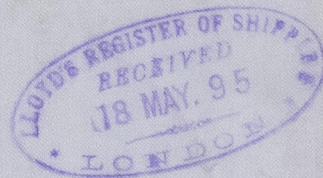

© 2019

Lloyd's Register
Foundation

