

Lloyd's Register of British and Foreign Shipping.

(Report on Vessel No. 7924 Port *Leith*)

No. 2450 SHIP FORGINGS OR CASTINGS.

The words FORGINGS or CASTINGS, IRON or STEEL, should be struck out as may be required.

I have to report that the undermentioned Iron ~~or Steel~~ Forgings ~~or Castings~~,
manufactured by *Messrs John Spencer & Co*
of *Durham* for the Vessel No. *36*, being built
by *J Brown & Co* of *Leith*
have been inspected by me as set forth below, and found to be, so far as can be seen,
Sound



Mark on Forgings.

Lloyd's
No. 44896
JB

John C Craig
Newcastle

	STERN FRAME.	RUDDER FRAME.	STEM.
Material*	<i>Scrap Iron</i>	/	
How made	<i>Forged</i>		
Dimensions	<i>4 1/2 - 1 3/4</i>		
Progress on Inspection	<i>Forged & Smoothed</i>		
Date when Inspected	<i>April 7-19-22-26/95</i>		

SKETCHES OF FRAMES SHOWING POSITION AND DESCRIPTION OF WELDS OF FORGINGS, OR PARTICULARS OF TESTS APPLIED TO CASTINGS.

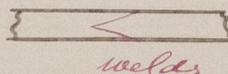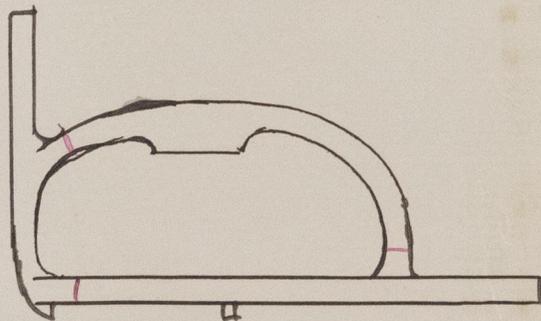

© 2019

Lloyd's Register
Foundation

S. S. "Gwenie"
Lth. Dept. No. 7924



© 2019

Lloyd's Register
Foundation