

14.5.95

Lth. Rept. No. 7943

Line Fishing Steamer No 19. "East Neuk"

to class 9A - "For Fishing Purposes"

Length of keel 90 ft

Over all 98 "

Breadth 19 ft 2 in Moulded

Depth top of keel 10 ft 9 in

" top of Floor top of Beam 10 ft 3 in

Keel American Elm 11 x 11

Keelson Pitch Pine 10 x 10

Timber and Space 1 ft 3 in

All Oak, Sided to 5 in

Floor 11 in Bilge 7 in top 5 in

Clamps Sided to 5 in

Plank Pitch Pine bottom 2 1/2 in

Bilge 3 1/2 top side 2 1/2, Beelling 3 1/2 in

Bilge Plank inside 2 1/2 3

Ceiling 1 3/4 Pitch Pine

Beam Clamp 50 9 x 4

Deck Beams 7 x 8 ends 5 1/2 x 6 Oak and P.P.

Decks Pitch Pine 6 x 2 3/8

Fastenings Bolts and Spikes (Through bolts at butts 4 in every 3rd timber)

Stem Post and deadwood 15 16 16 16

Keelson 12 16


Planking 7/8

Knees Bolts 1/8 Galvanized

Iron Beams and Fore & Aft from

Boiler & Engine room

Knees on every beam wood & iron
8 pairs long rider knees on each side.

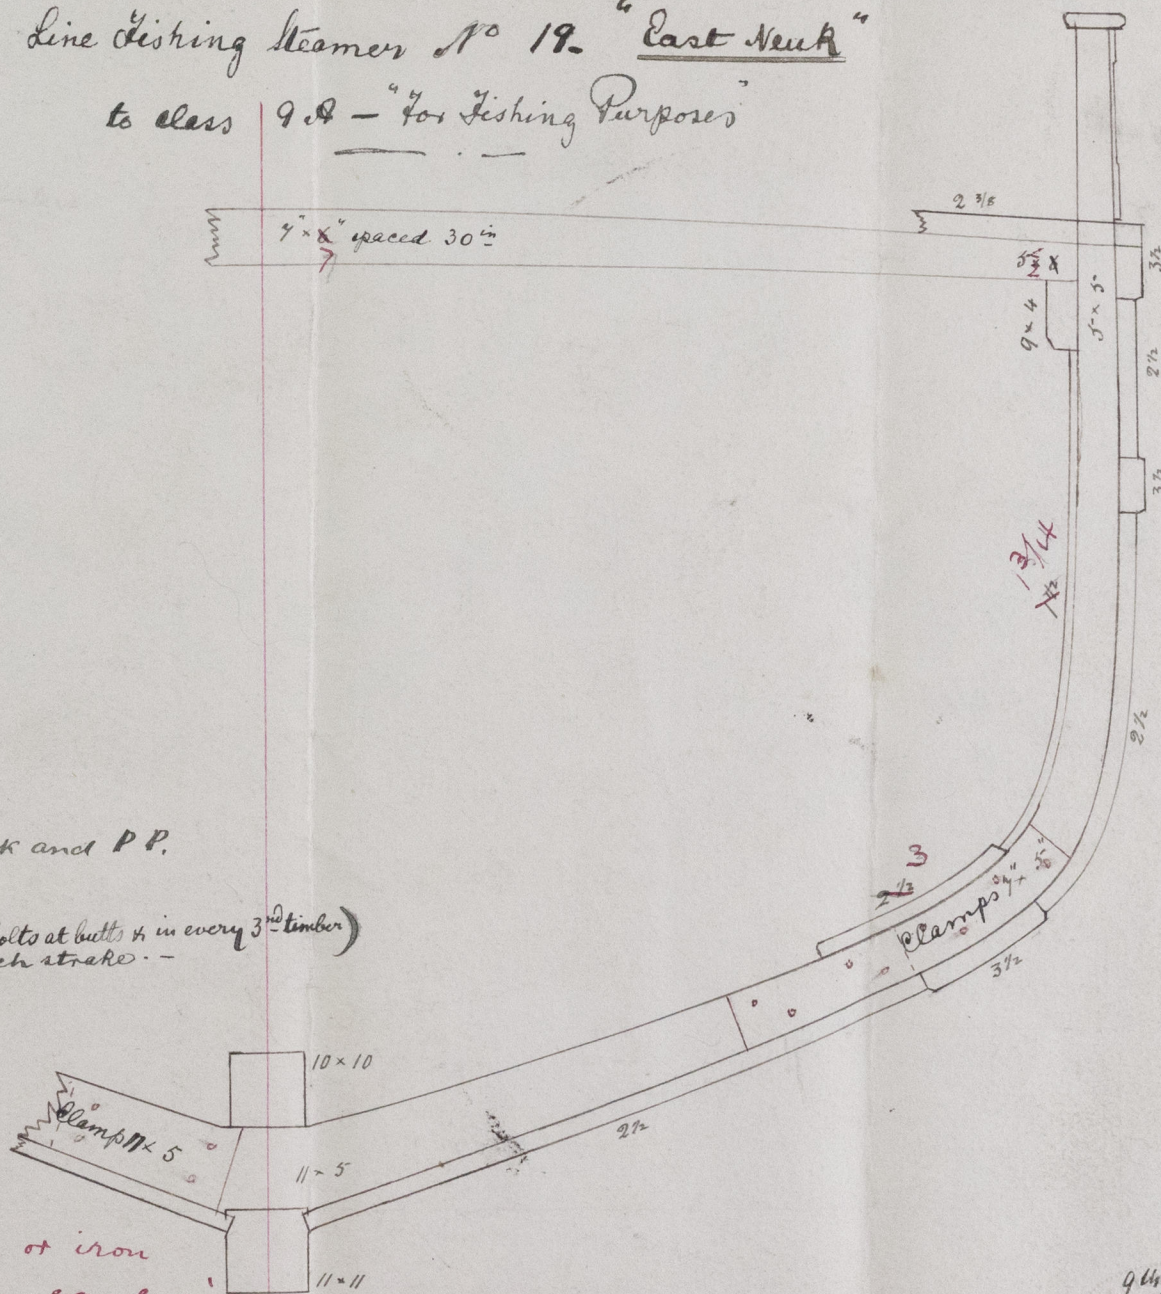


9th May 95

© 2019
From William Jarvis
Shipbuilder
Lloyd's Register
Foundation
14/5/95

Screw Fishing Steamer

"East Neuk"

Lth. Regt. No 7943.

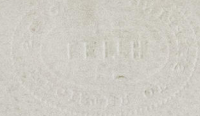

© 2019

