


S. S. "Clio"

LM. Rept No 7963

11.6.95

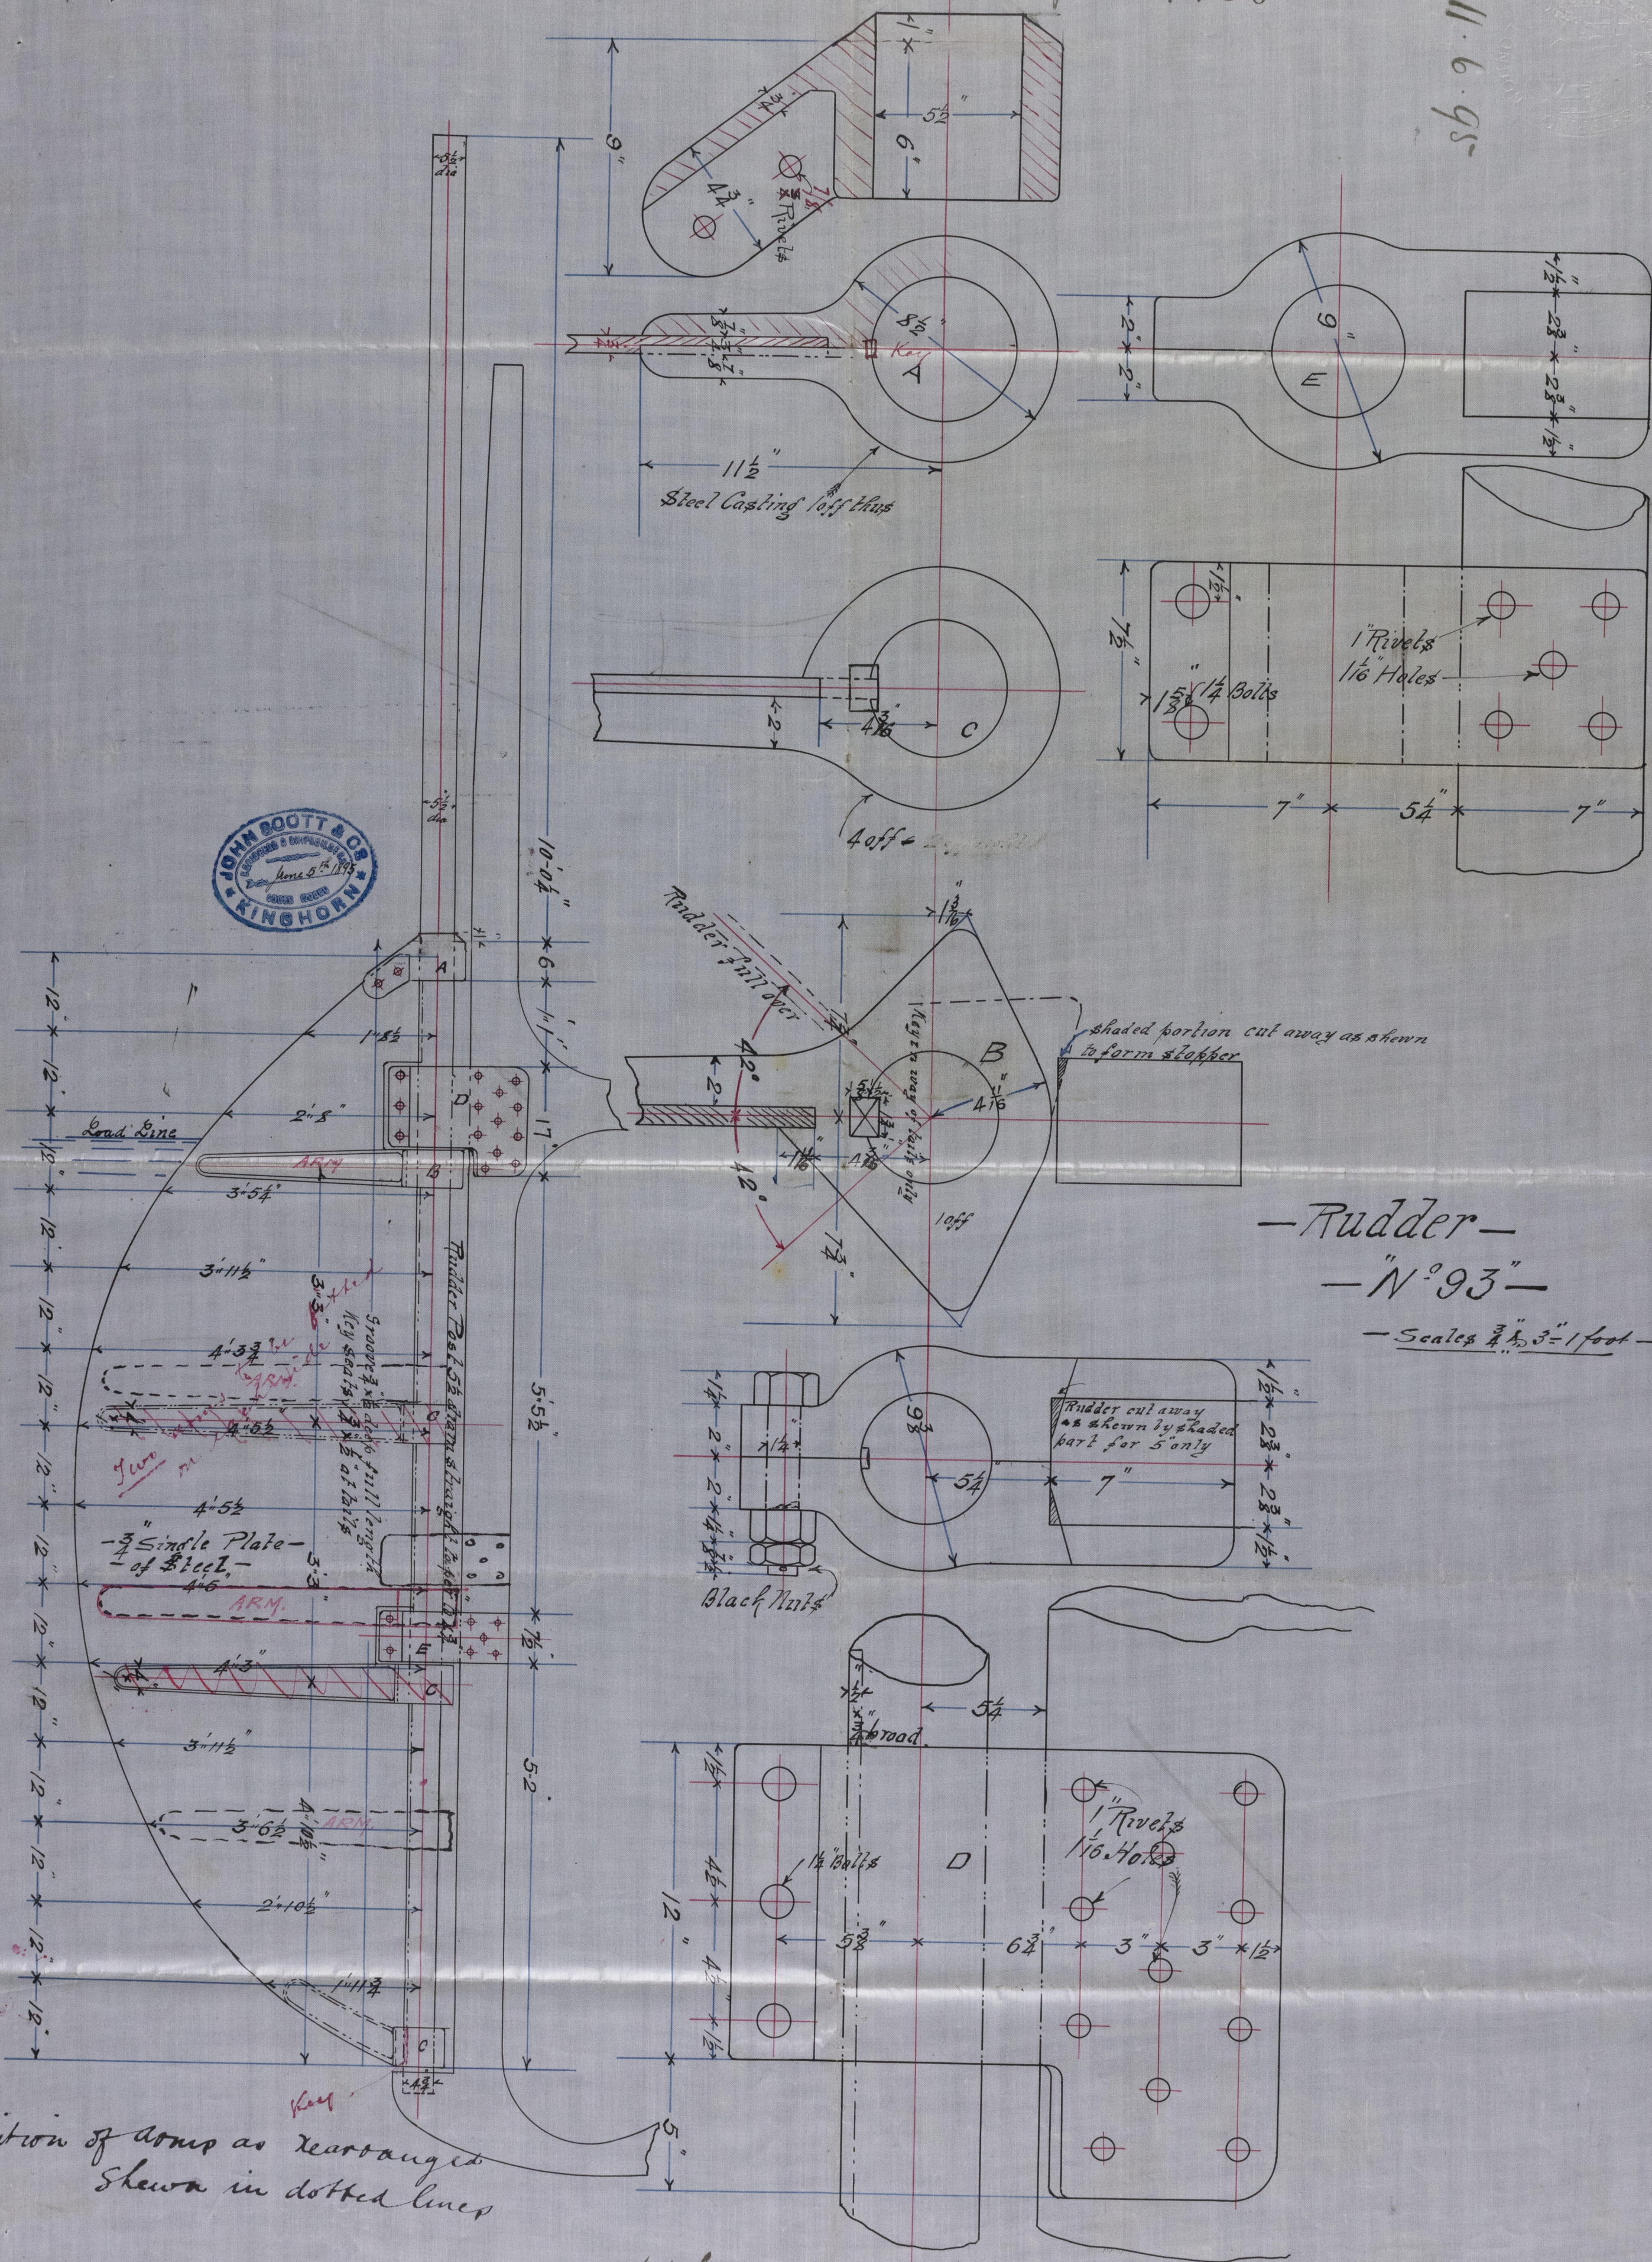

Position of Arms as rearranged  
shown in dotted lines

10/6/95



© 2004 Lloyd's Register  
Foundation



5. 5 "Clio"

Lth. Report. No 7963

1000

© 2019

Lloyd's Register  
Foundation