



— Scale $\frac{1}{8}"$ = one foot —

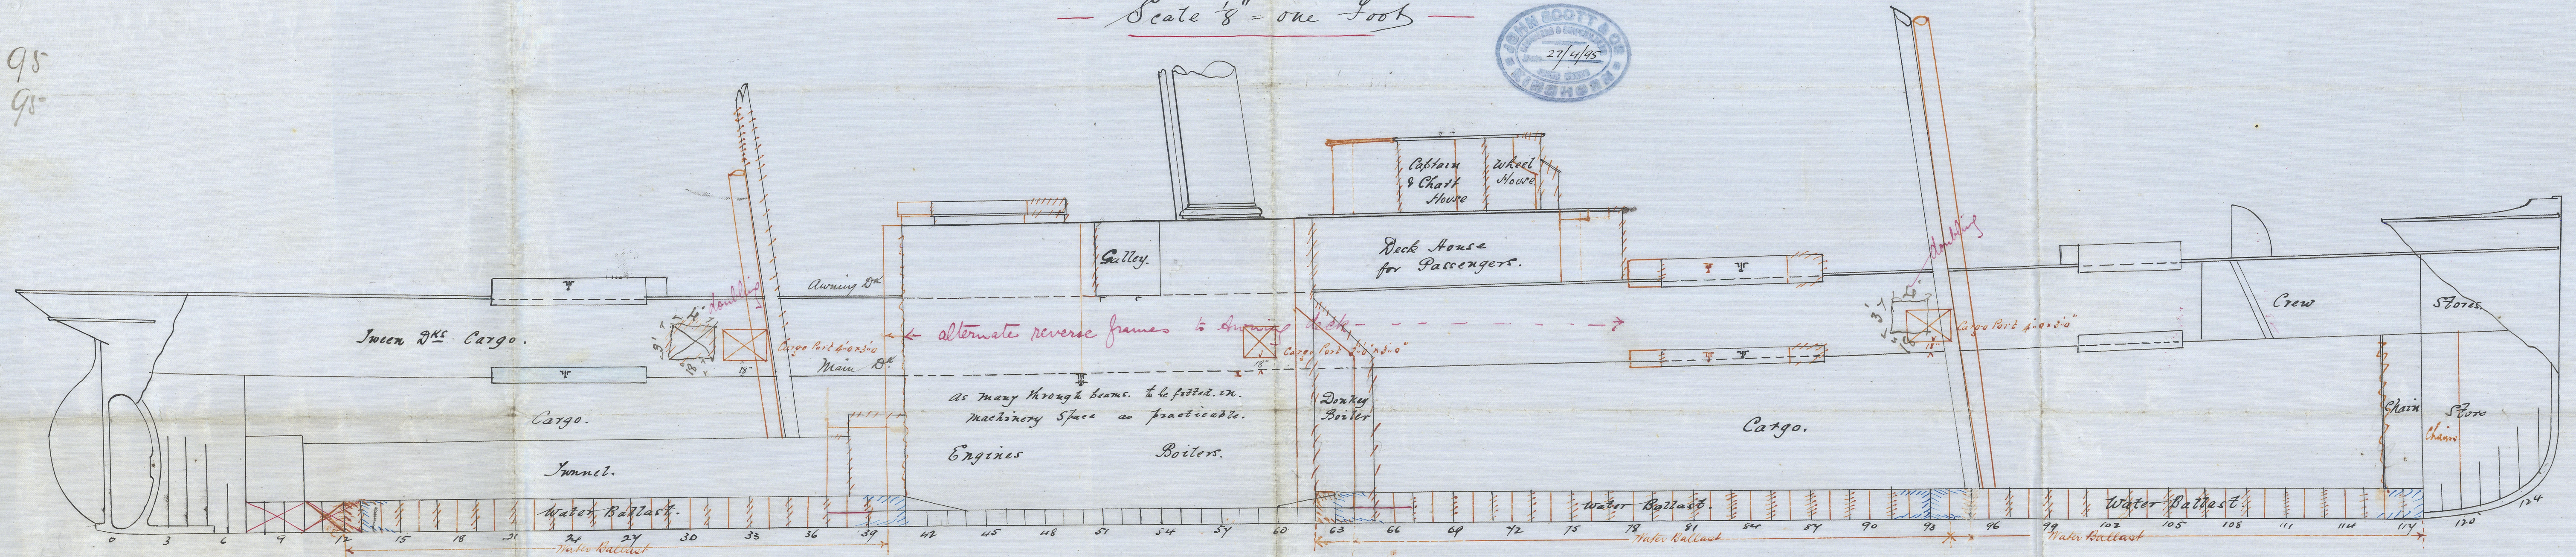

- Alterations in brown correct

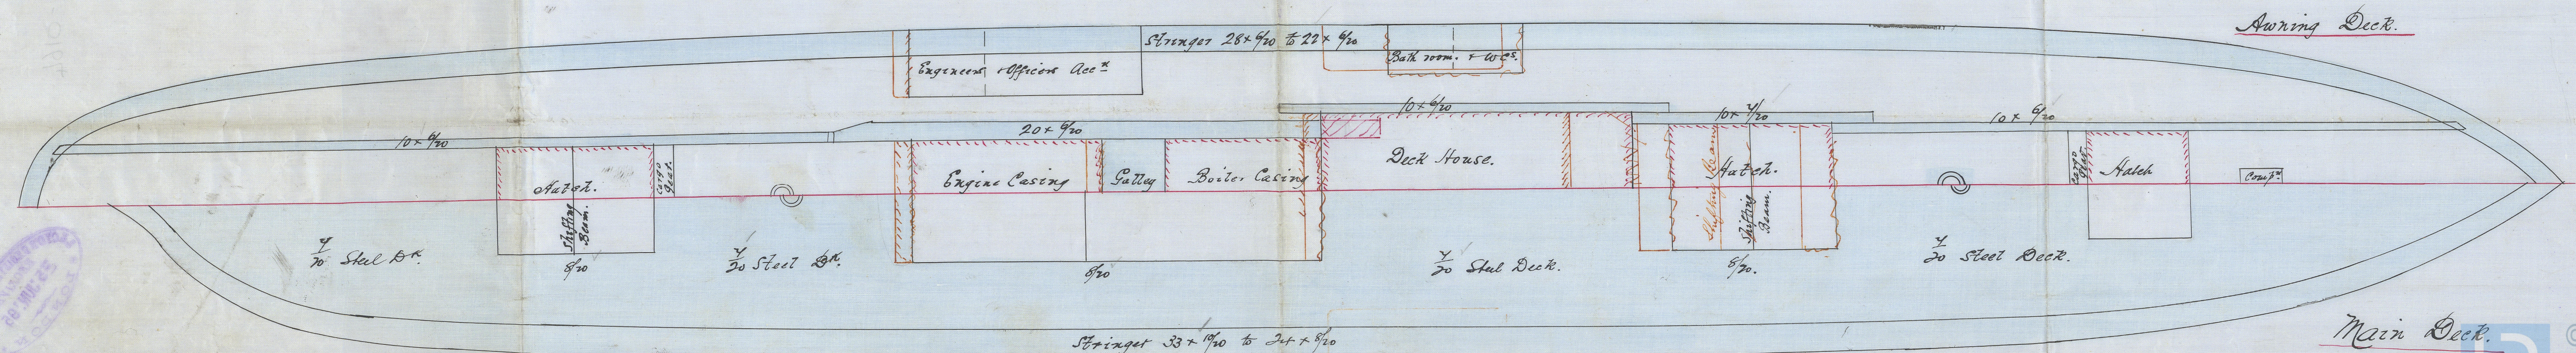

Marr Decr.

2021 30th April 95

loyd's Register

Foundation

S. S. "Cliv"

Ltr. Rept. No 7963



Awning Deck

Mast Deck



© 2021

Lloyd's Register
Foundation