

Lloyd's Register of British and Foreign Shipping.

Lith (Report on Vessel No. *8047* Port *Lith*)

No. *3055 a* SHIP FORGINGS OR CASTINGS.

I have to report that the undermentioned Iron or ~~Steel~~ Forgings or Castings, manufactured by *Wm Tho Ray* of *Pallin* for the Vessel No. *185*, being built by *The Grangemouth Dockyard Co.* of *Grangemouth* have been inspected by me as set forth below, and found to be, so far as can be seen, *sound*.

The words FORGINGS or CASTINGS, IRON or STEEL, should be struck out as may be required.

Mark on Forgings.

Lloyd's
No. *3055 a*
W.C.



Wm Cameron

Sundland

19-11-95

	STERN FRAME.	RUDDER FRAME.	STEM.
Material*	<i>Scrap iron</i>	<i>Scrap iron</i>	<i>Scrap iron</i>
How made	<i>Forged</i>	<i>Forged</i>	<i>Forged</i>
Dimensions	<i>10" x 5 1/2"</i>	<i>4 3/4" x 3 3/4"</i>	<i>10" x 2 1/2"</i>
Progress on Inspection	<i>Forged & smithed</i>	<i>Forged & smithed</i>	<i>Forged</i>
Date when Inspected	<i>July 1st to Aug 20/95</i>	<i>Sept 5th to Oct 19/95</i>	<i>Aug 20/95</i>

SKETCHES OF FRAMES SHOWING POSITION AND DESCRIPTION OF WELDS OF FORGINGS, OR PARTICULARS OF TESTS APPLIED TO CASTINGS.

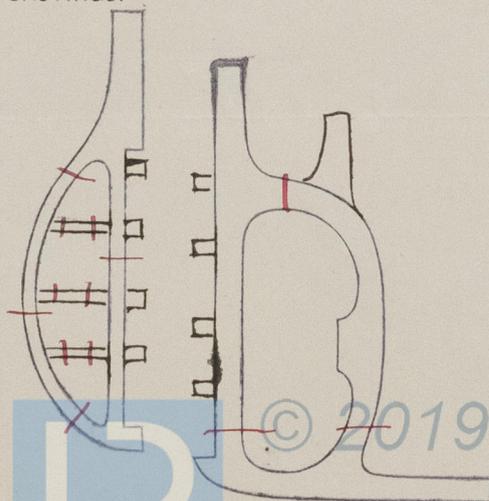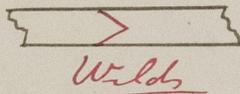

Fee (if any chargeable) £ : :

To be paid at _____

* If of Iron, state whether scrap or puddled Iron.

S. S. "Nanshan"
Lth. Rept. N: 8047



© 2019

Lloyd's Register
Foundation