

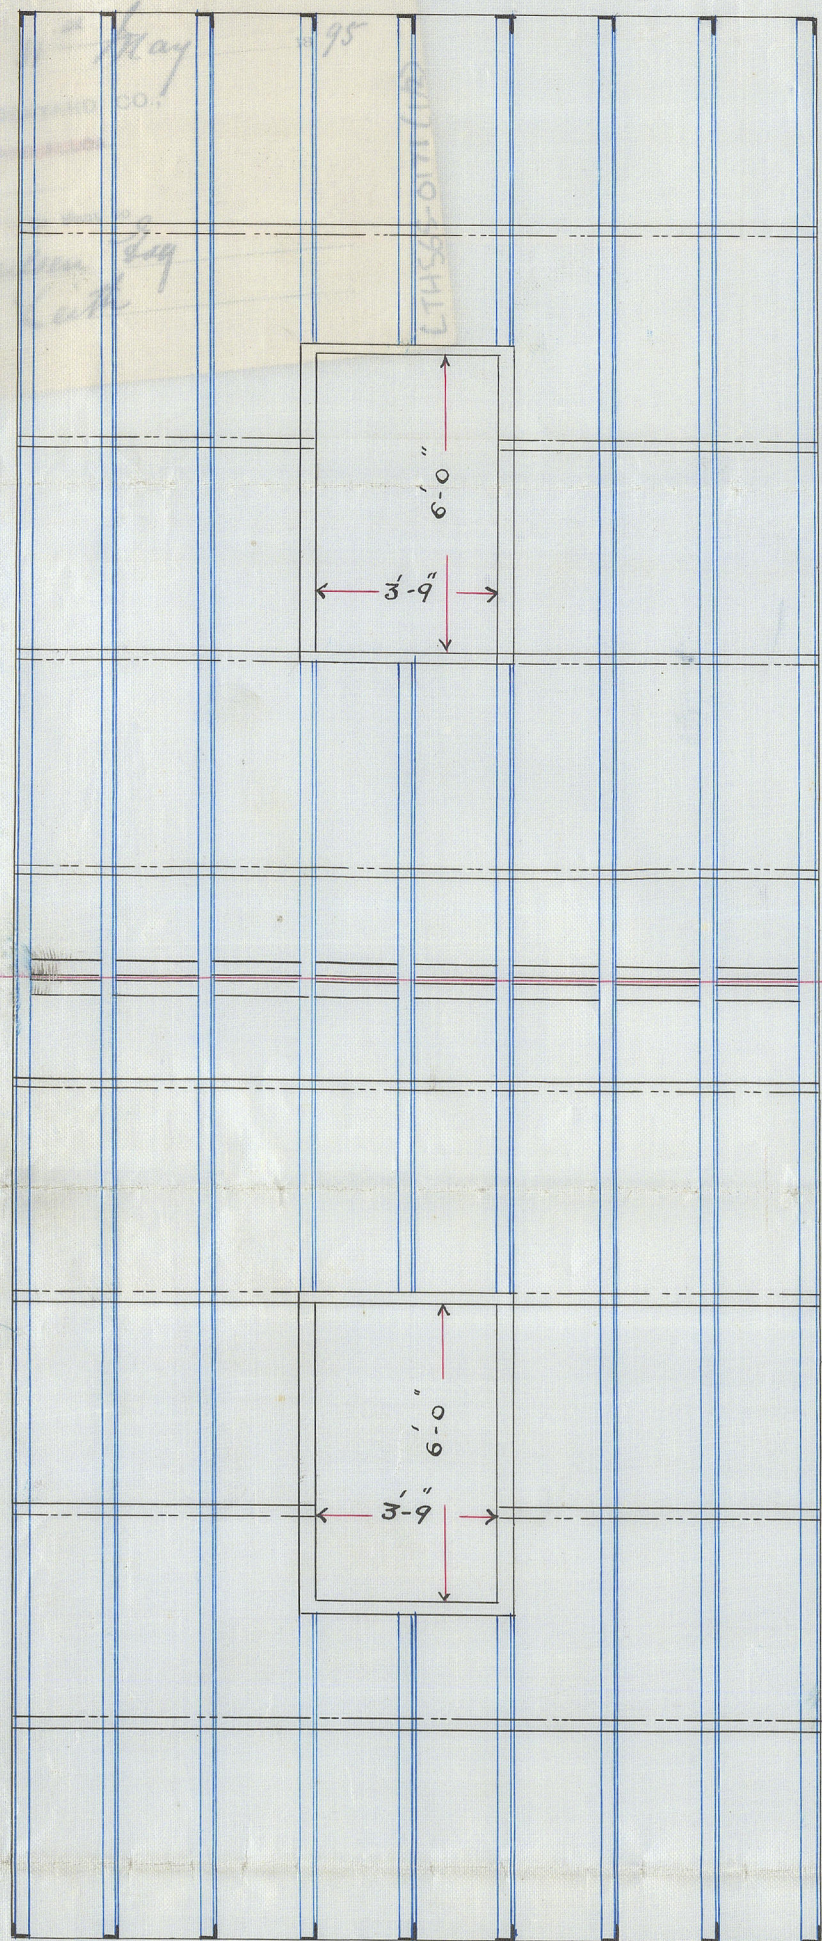
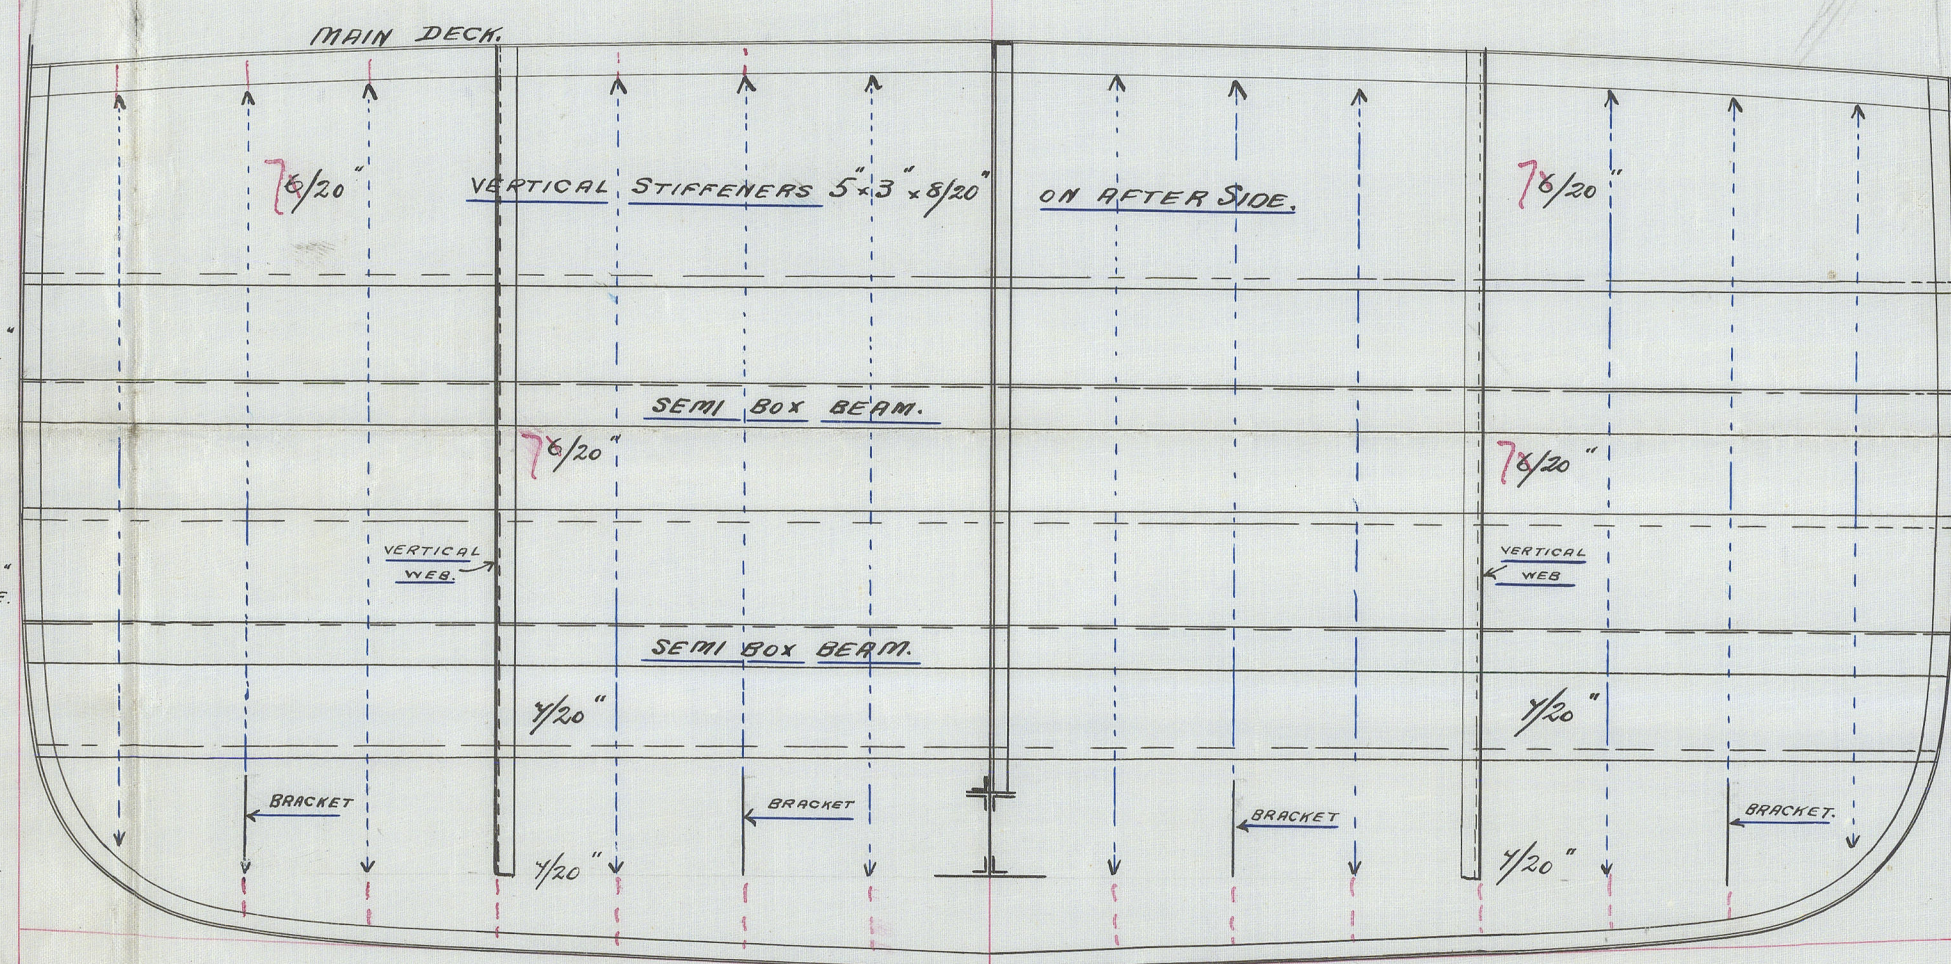
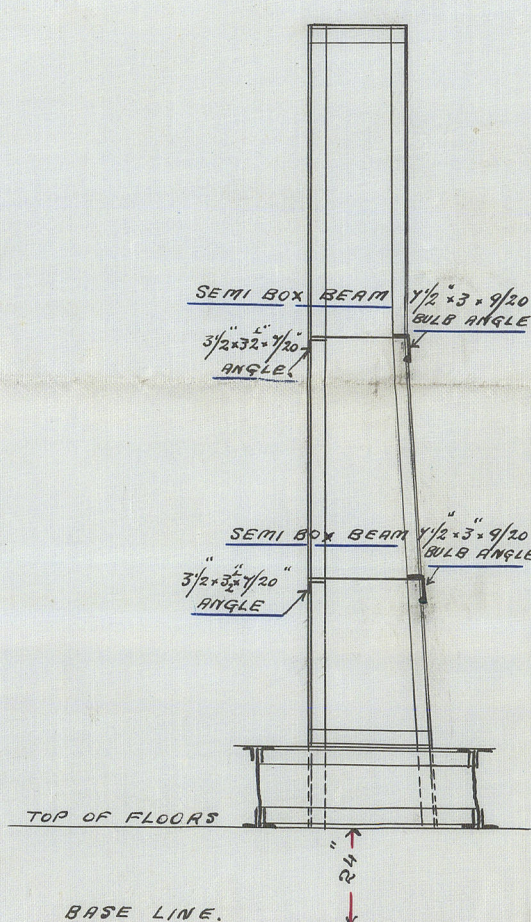



6.6.95

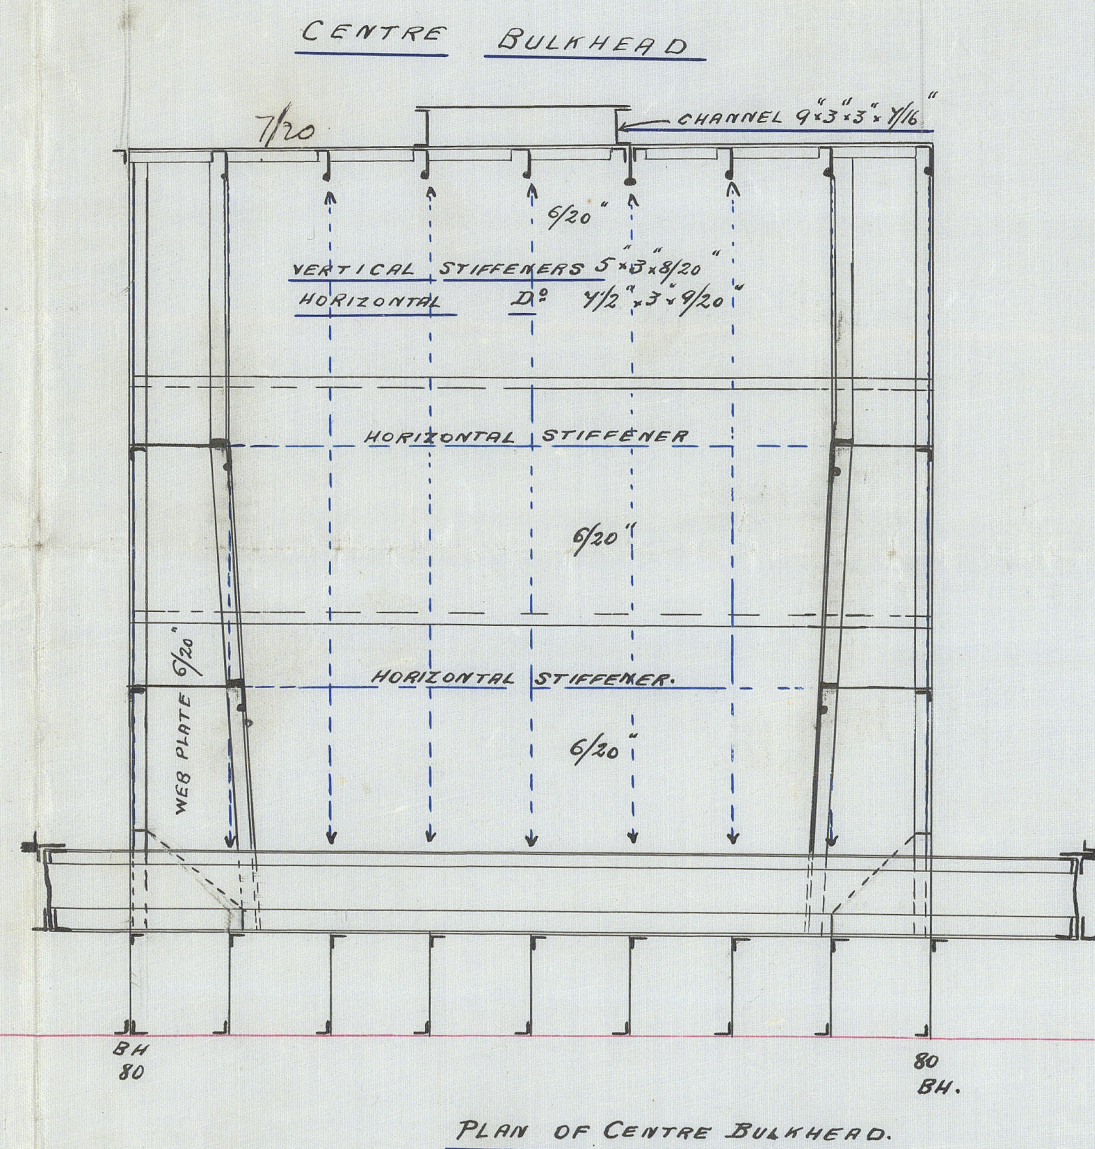

PLAN OF IRON DECK ON DEEP BALLAST TANK.

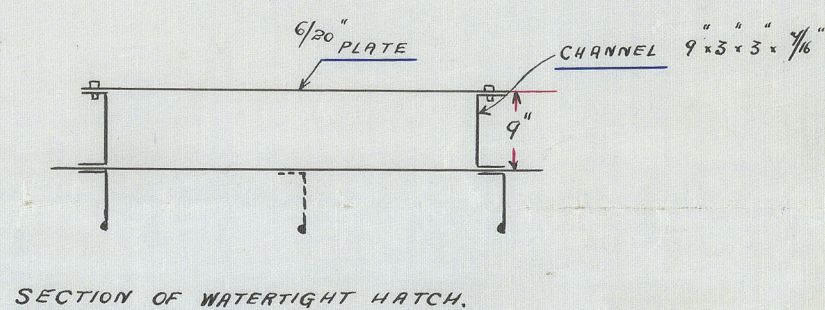


SECTION OF BULKHEAD AT FRAMES 80 & 88.

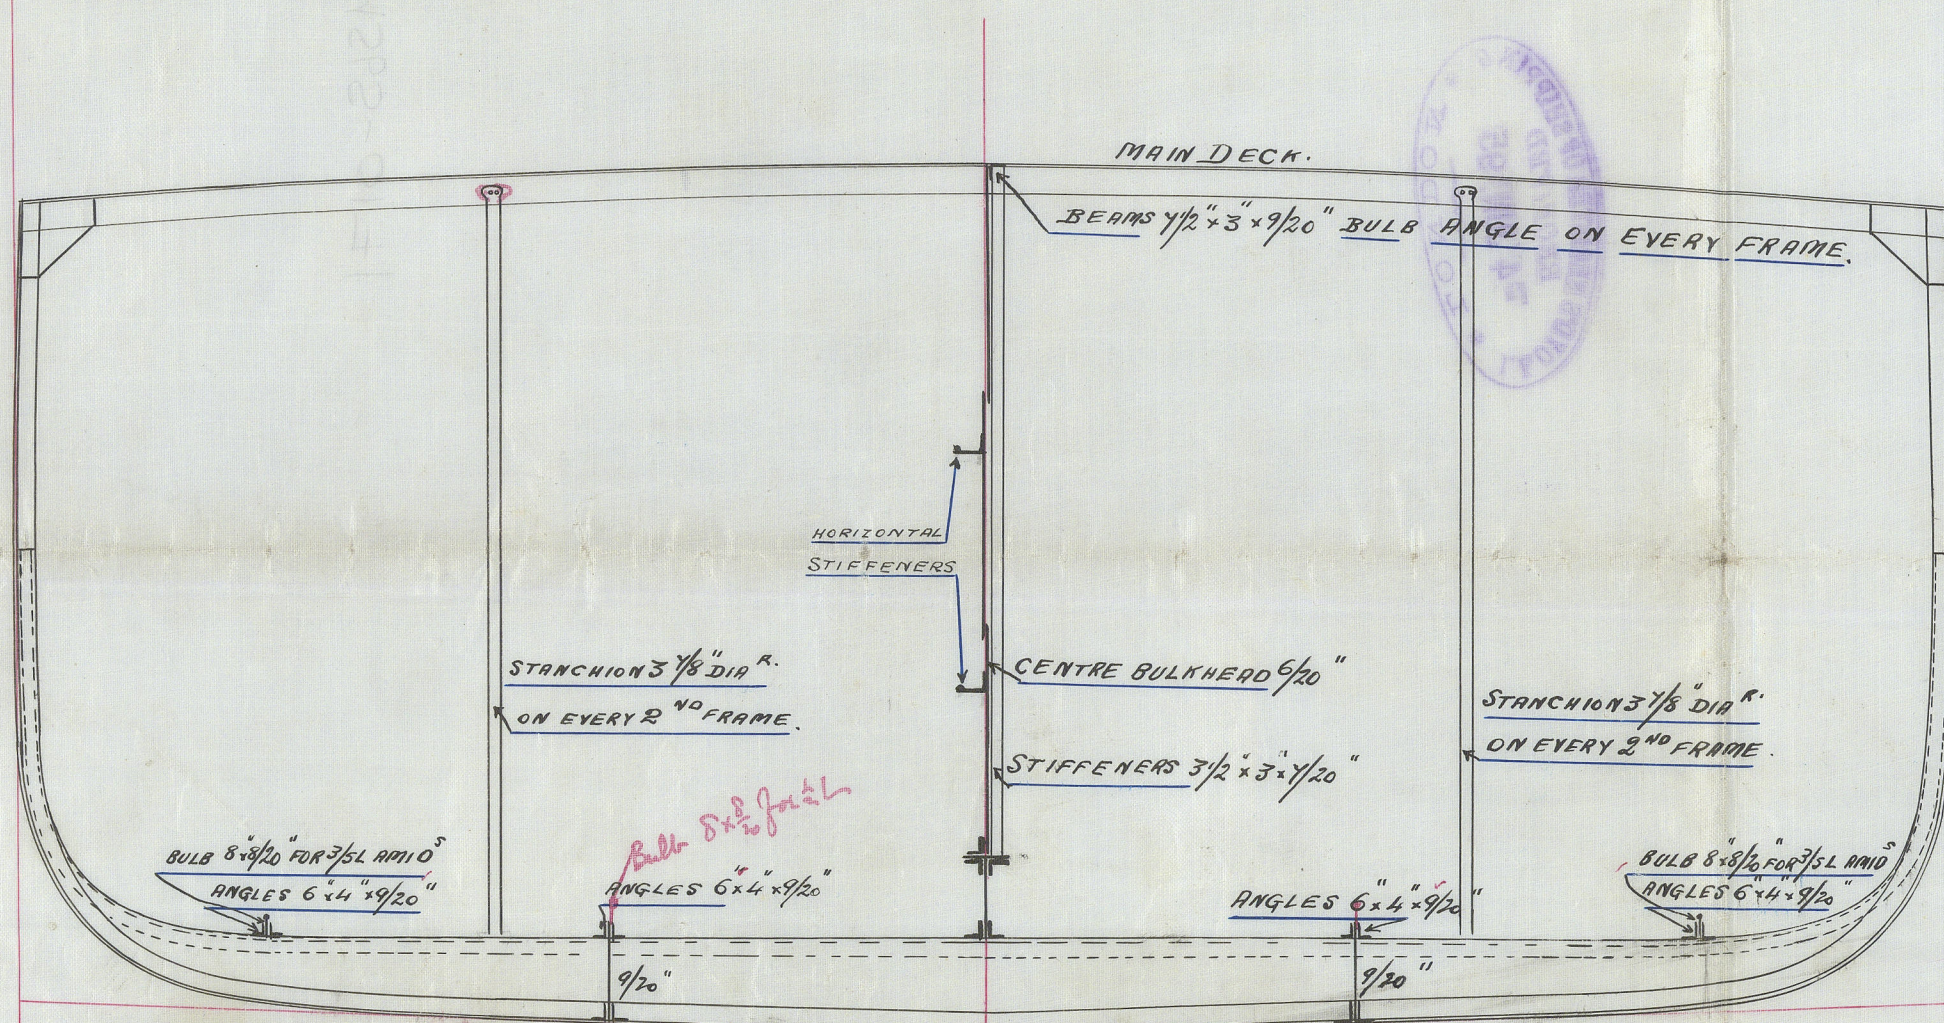

SECTION OF BALLAST TANK.

N<sup>o</sup> 185. "Nanshan"  
SKETCH SHEWING ARRANGEMENT OF BALLAST TANK.  
SCALE 1/4" = ONE FOOT.

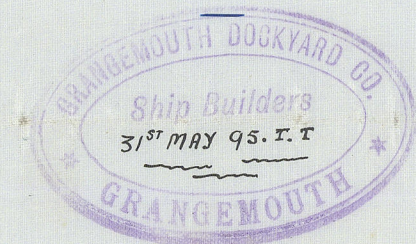

576/95



31<sup>st</sup> May

18 95

GRANGEMOUTH DOCKYARD CO.,  
GRANGEMOUTH ~~AND ALLOA~~.

This Enclosure is to be Sent to

Ships No.

185-

Wm Paulsen Esq  
Leith


Tracing No.

115

LT4565-0171 (1/2)



Lth. Repert 1: 8047

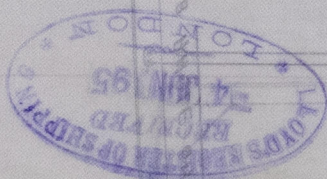

© 2021

Lloyd's Register  
Foundation