



"Nanshan"

Lith. Repr. No 8047




SCALE  $\frac{1}{8}" =$  ONE FOOT.

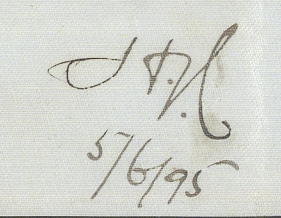

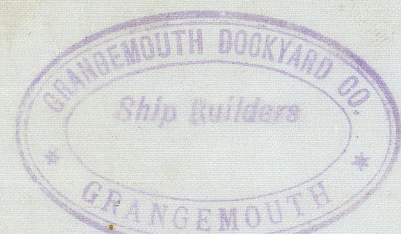

S. S. "Nanshan"  
L.H. Rept. No. 8047

2/10/22  
74/5

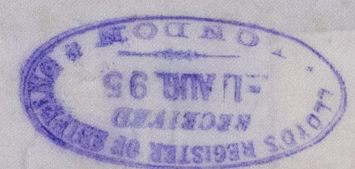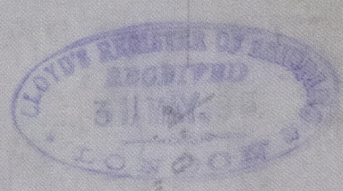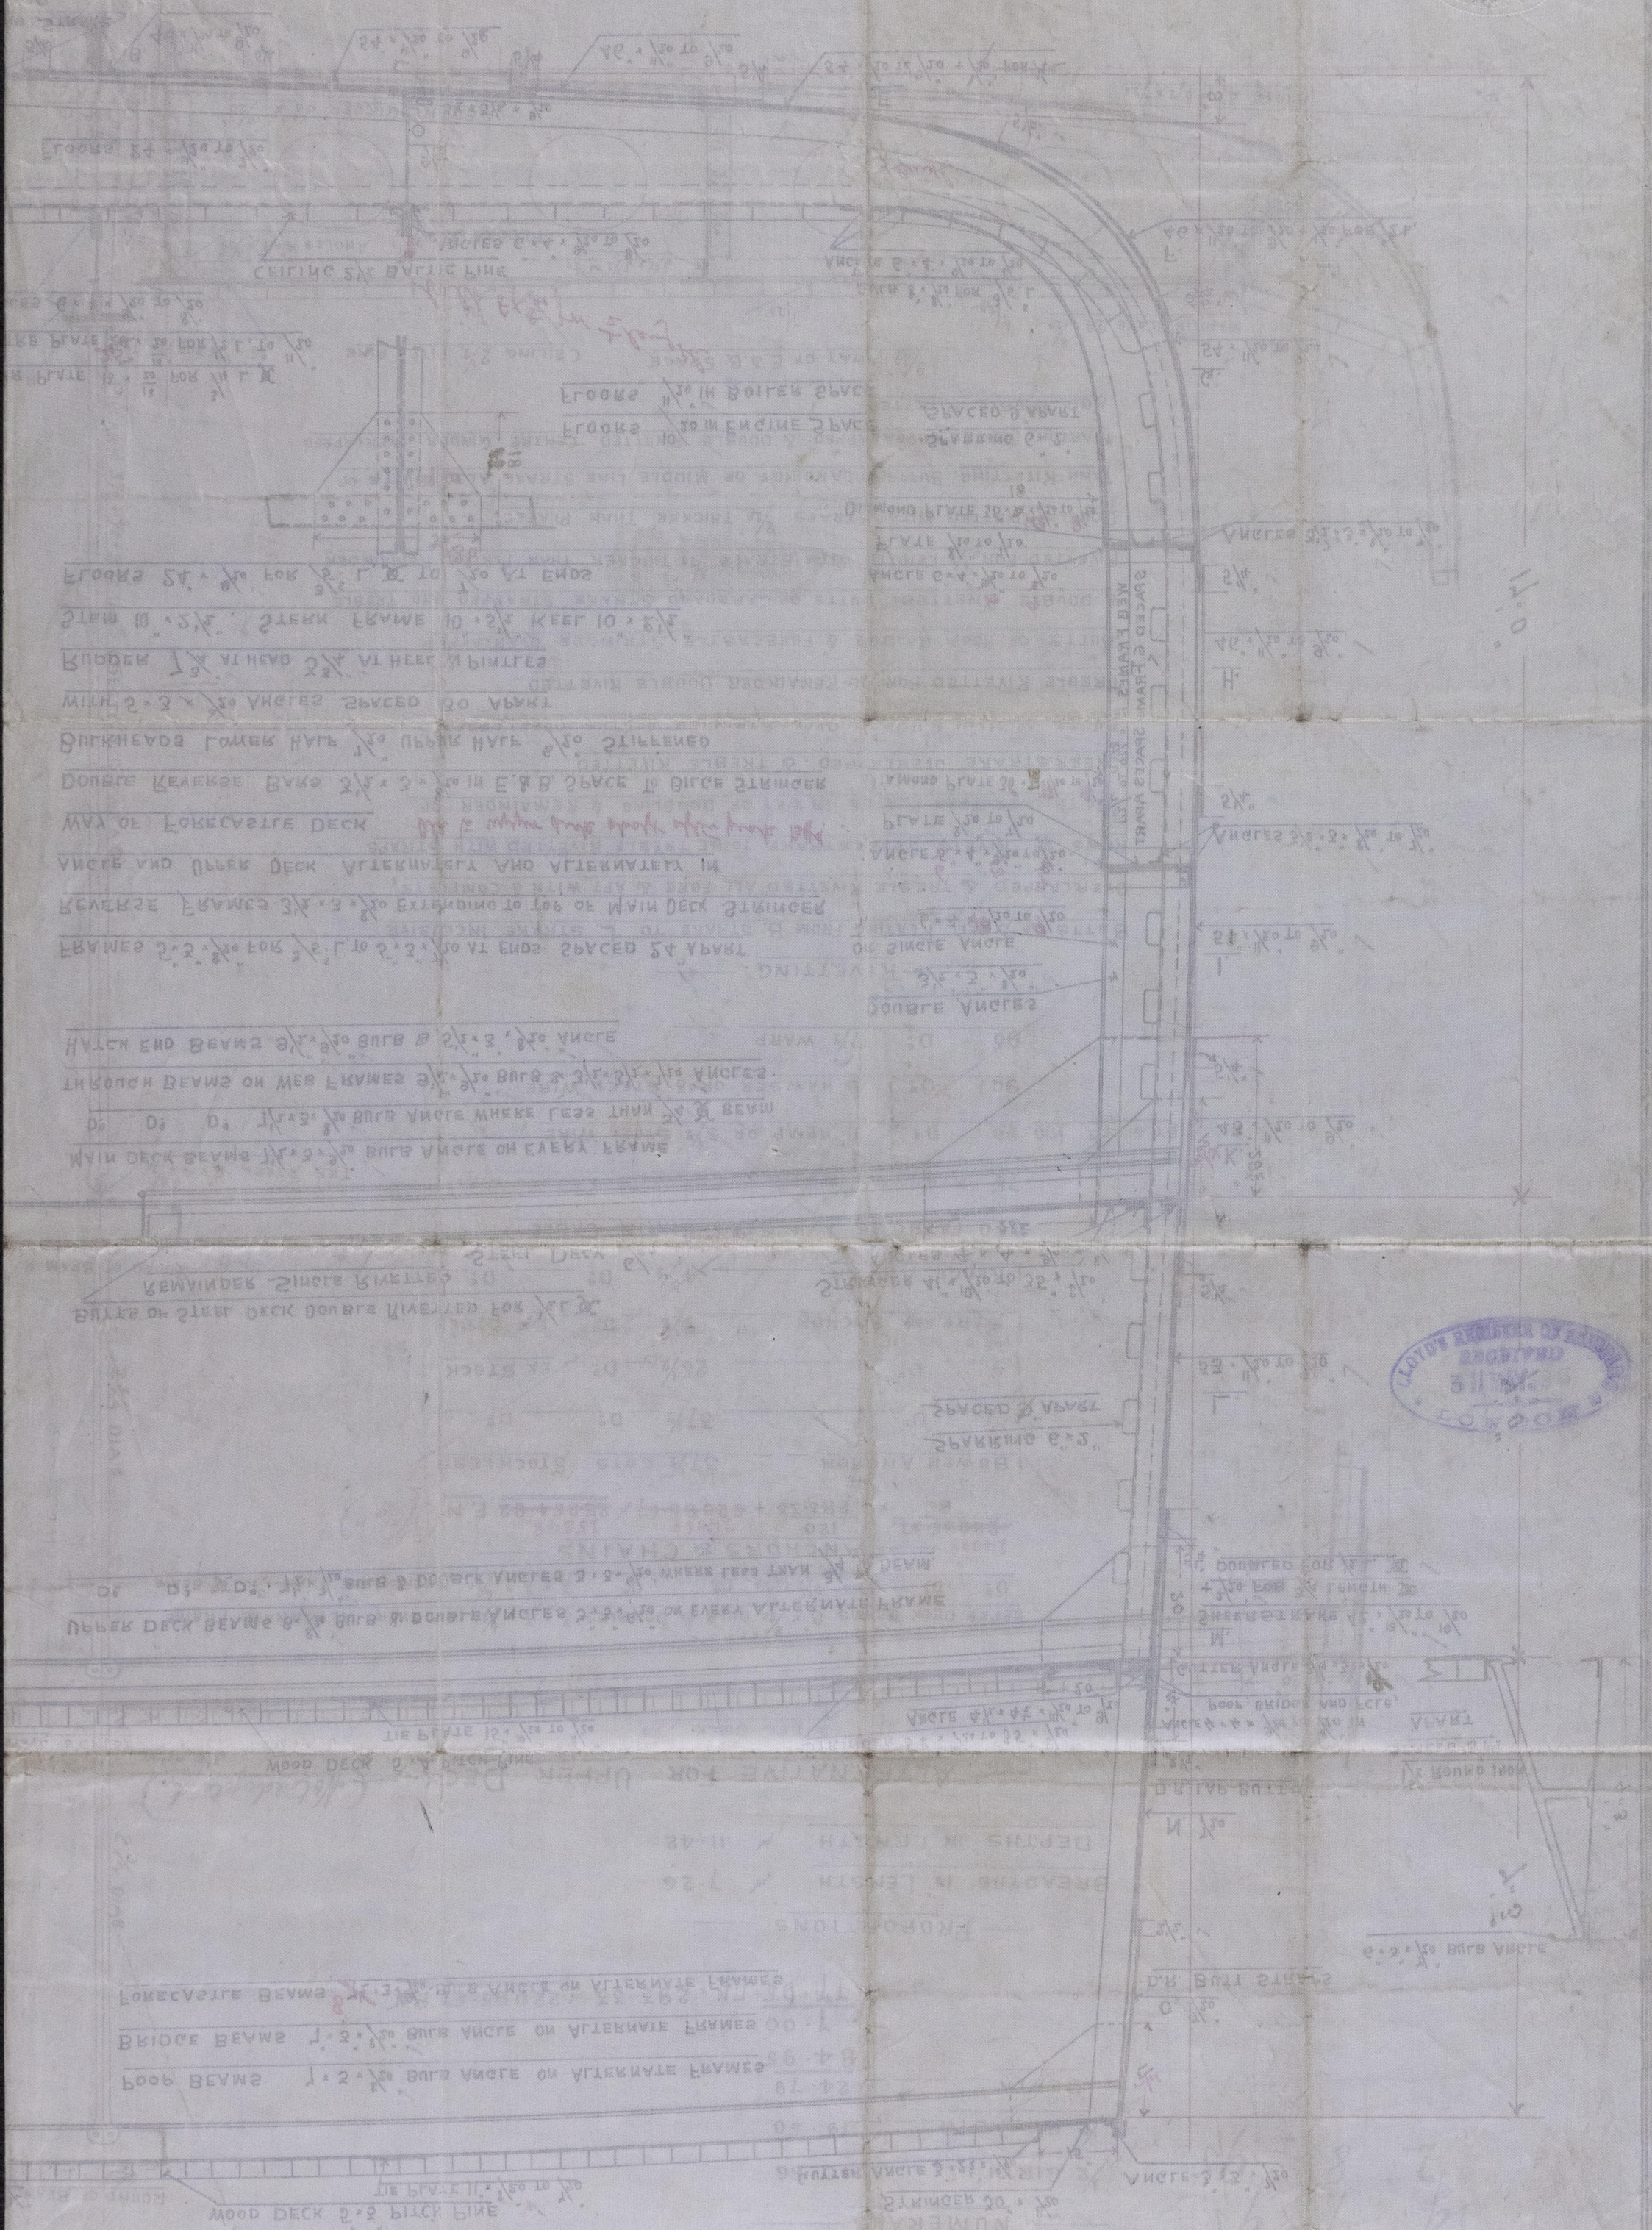



LTH565-0175 (1/2)

28 ~~th~~<sup>th</sup> May

18 95

GRANGEMOUTH DOCKYARD CO.

GRANGEMOUTH ~~AND ALLOA.~~

This Enclosure is to be Sent to

Ships No.

185

Wm Paulsen Esq

Tracing No.

III,

Leith