


4.9.95


Bilge and Tank Pumping Arrangement
Engine No. 205.
Scale $\frac{1}{2}$ " = 1 foot.

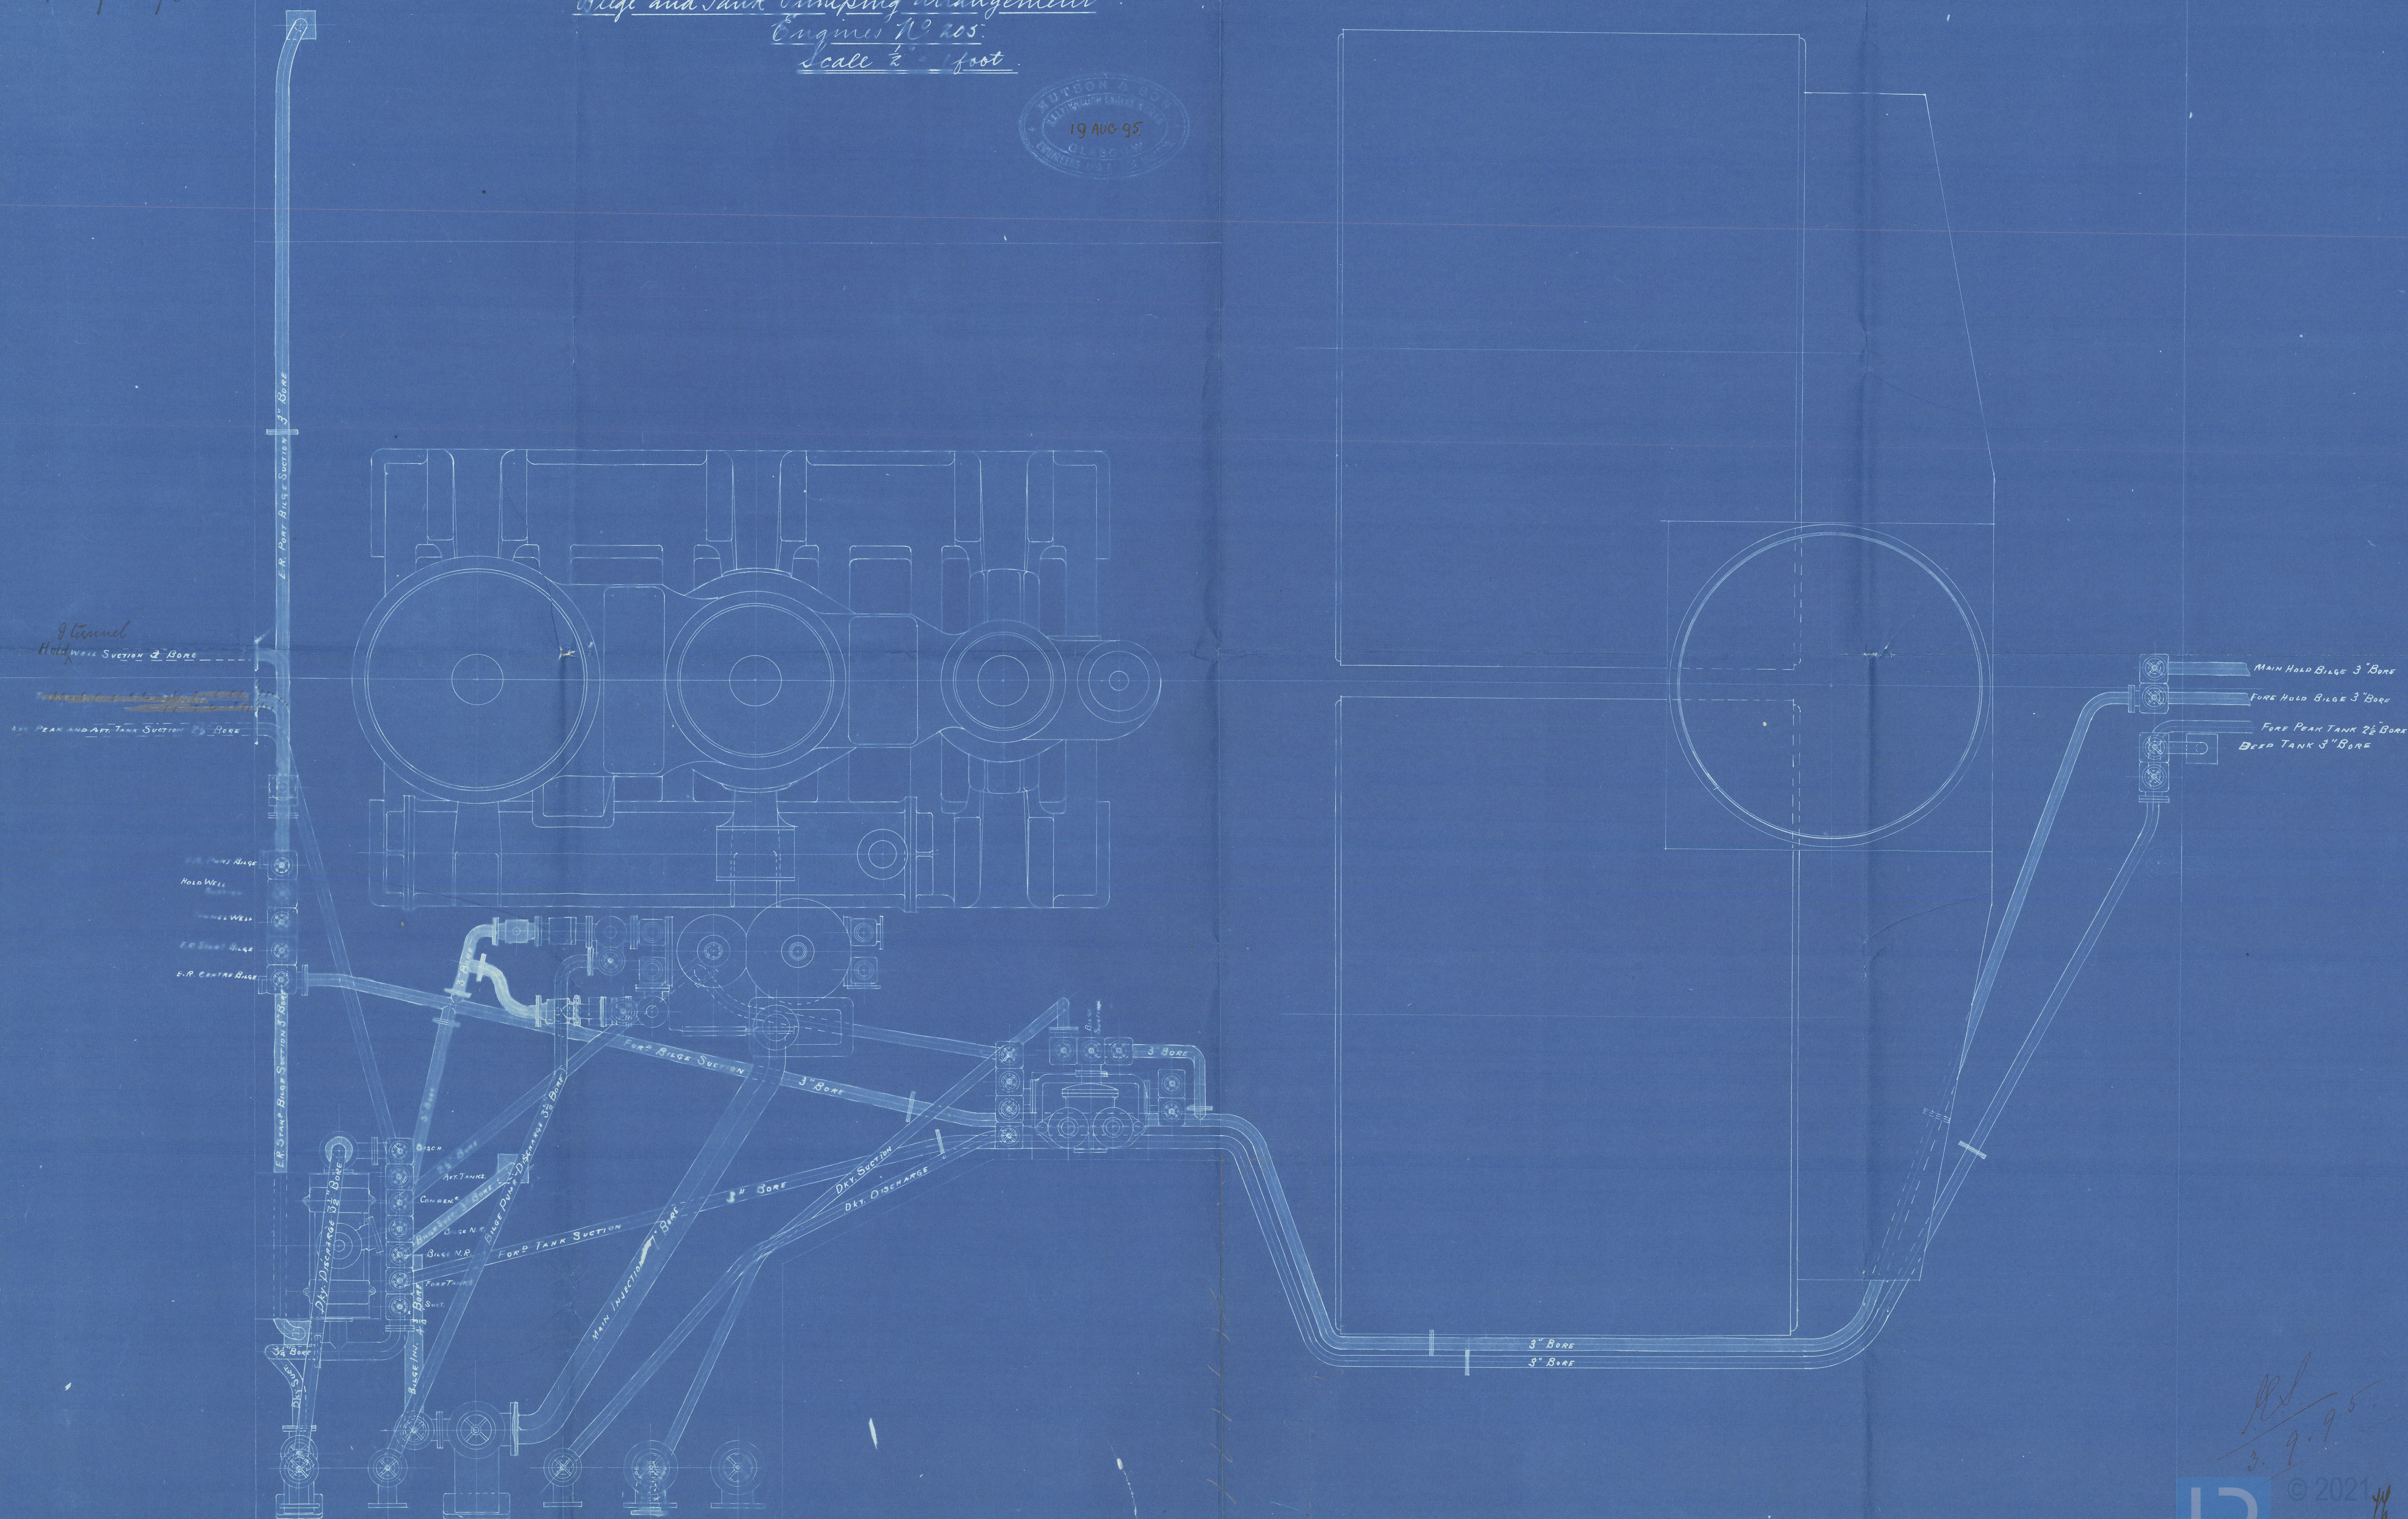

S. S. "Kanshan"

Pumping arrangement.

Leak Report 8042

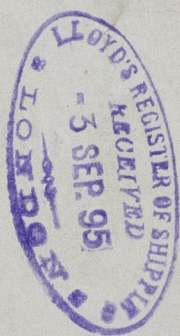

© 2021

Lloyd's Register
Foundation