



25.6.95


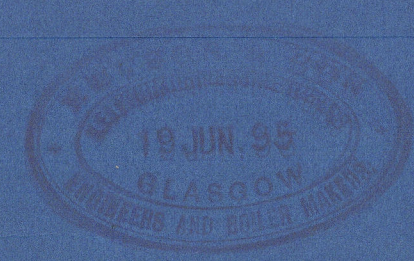


Boilers No. 361 & 2
Pressure 160 lbs
Scale 1" = 1 ft.

25.6.95

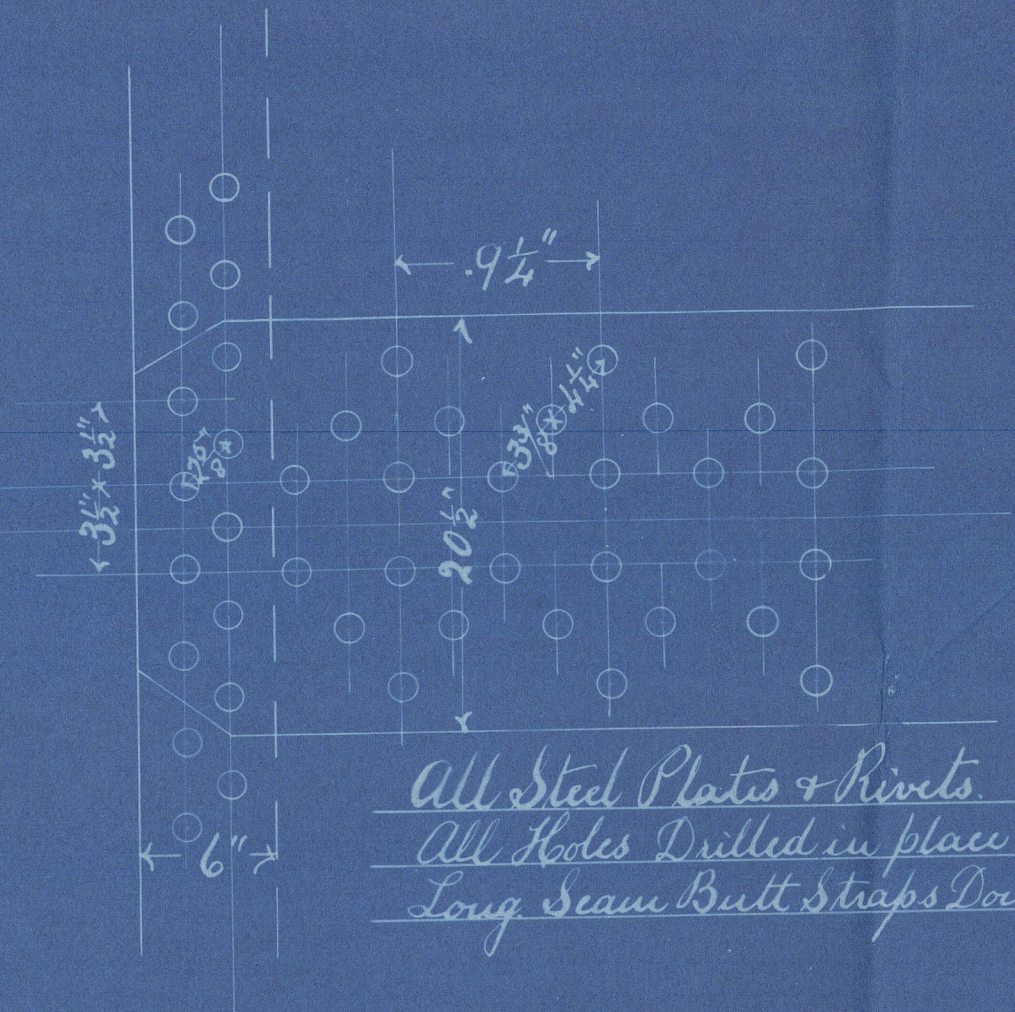

All Steel Plates & Rivets
All Holes Drilled in place 1 1/2" dia.
Long Seam Butt Straps Double 3/32" thick

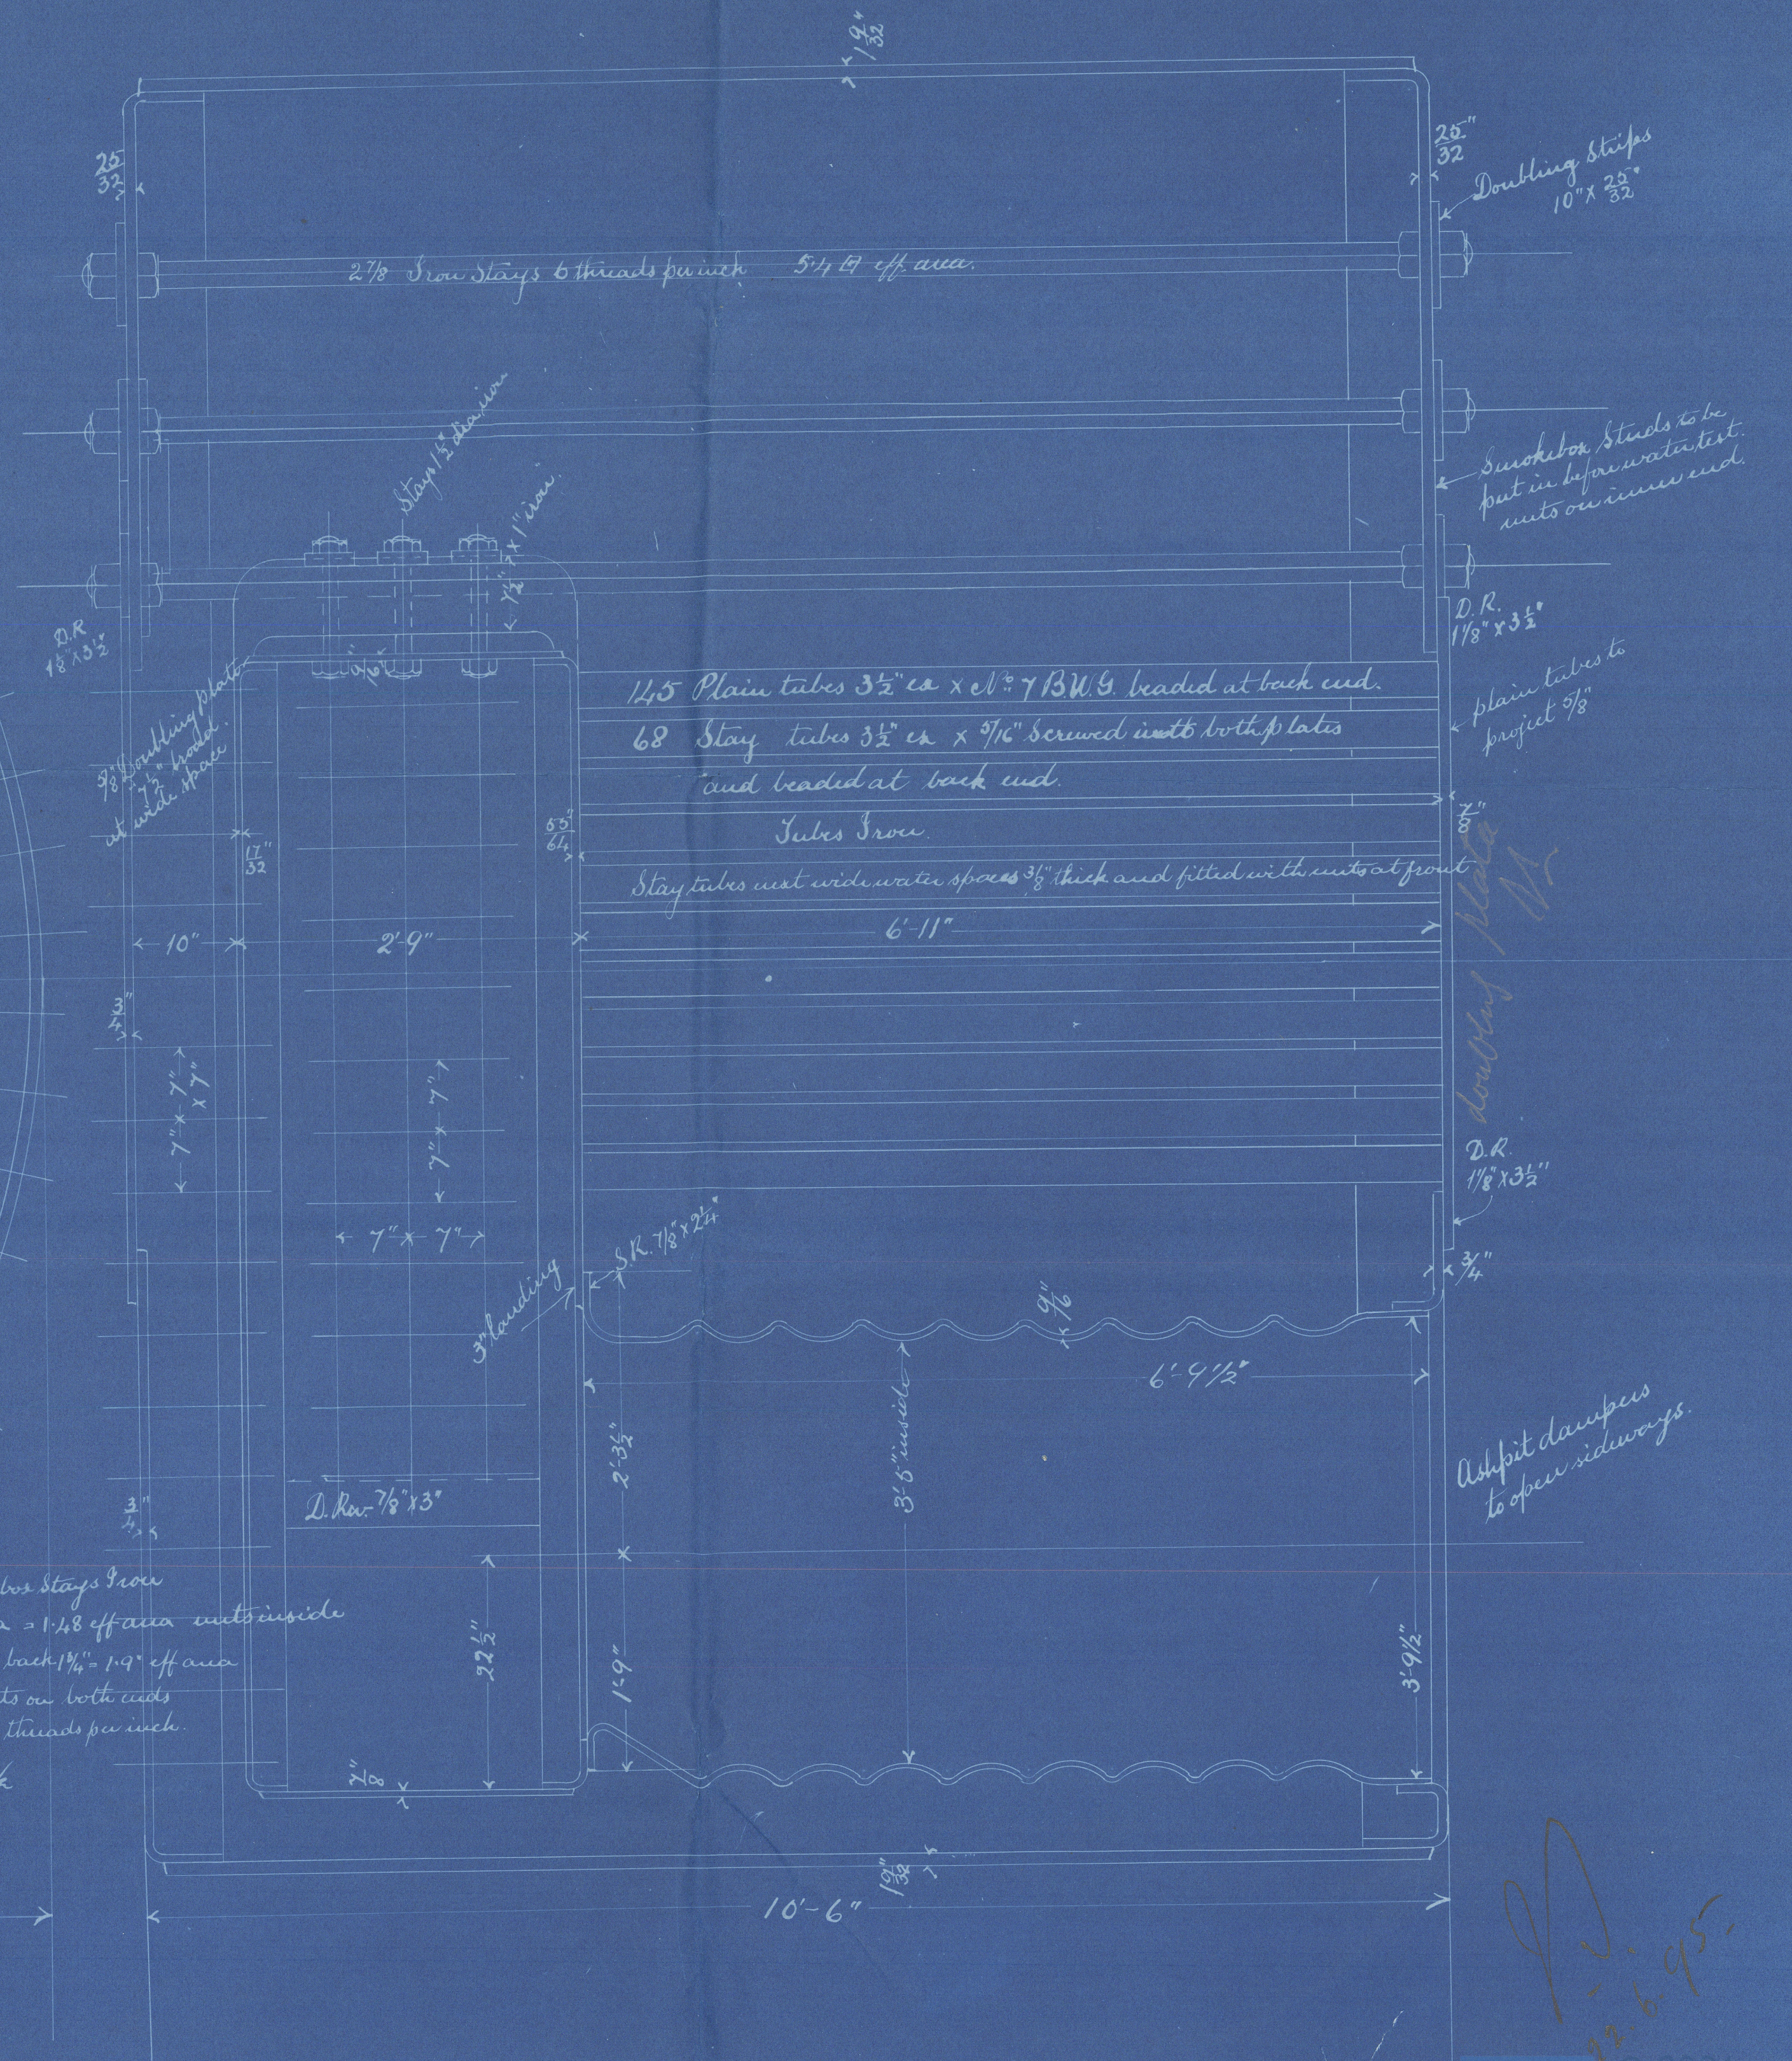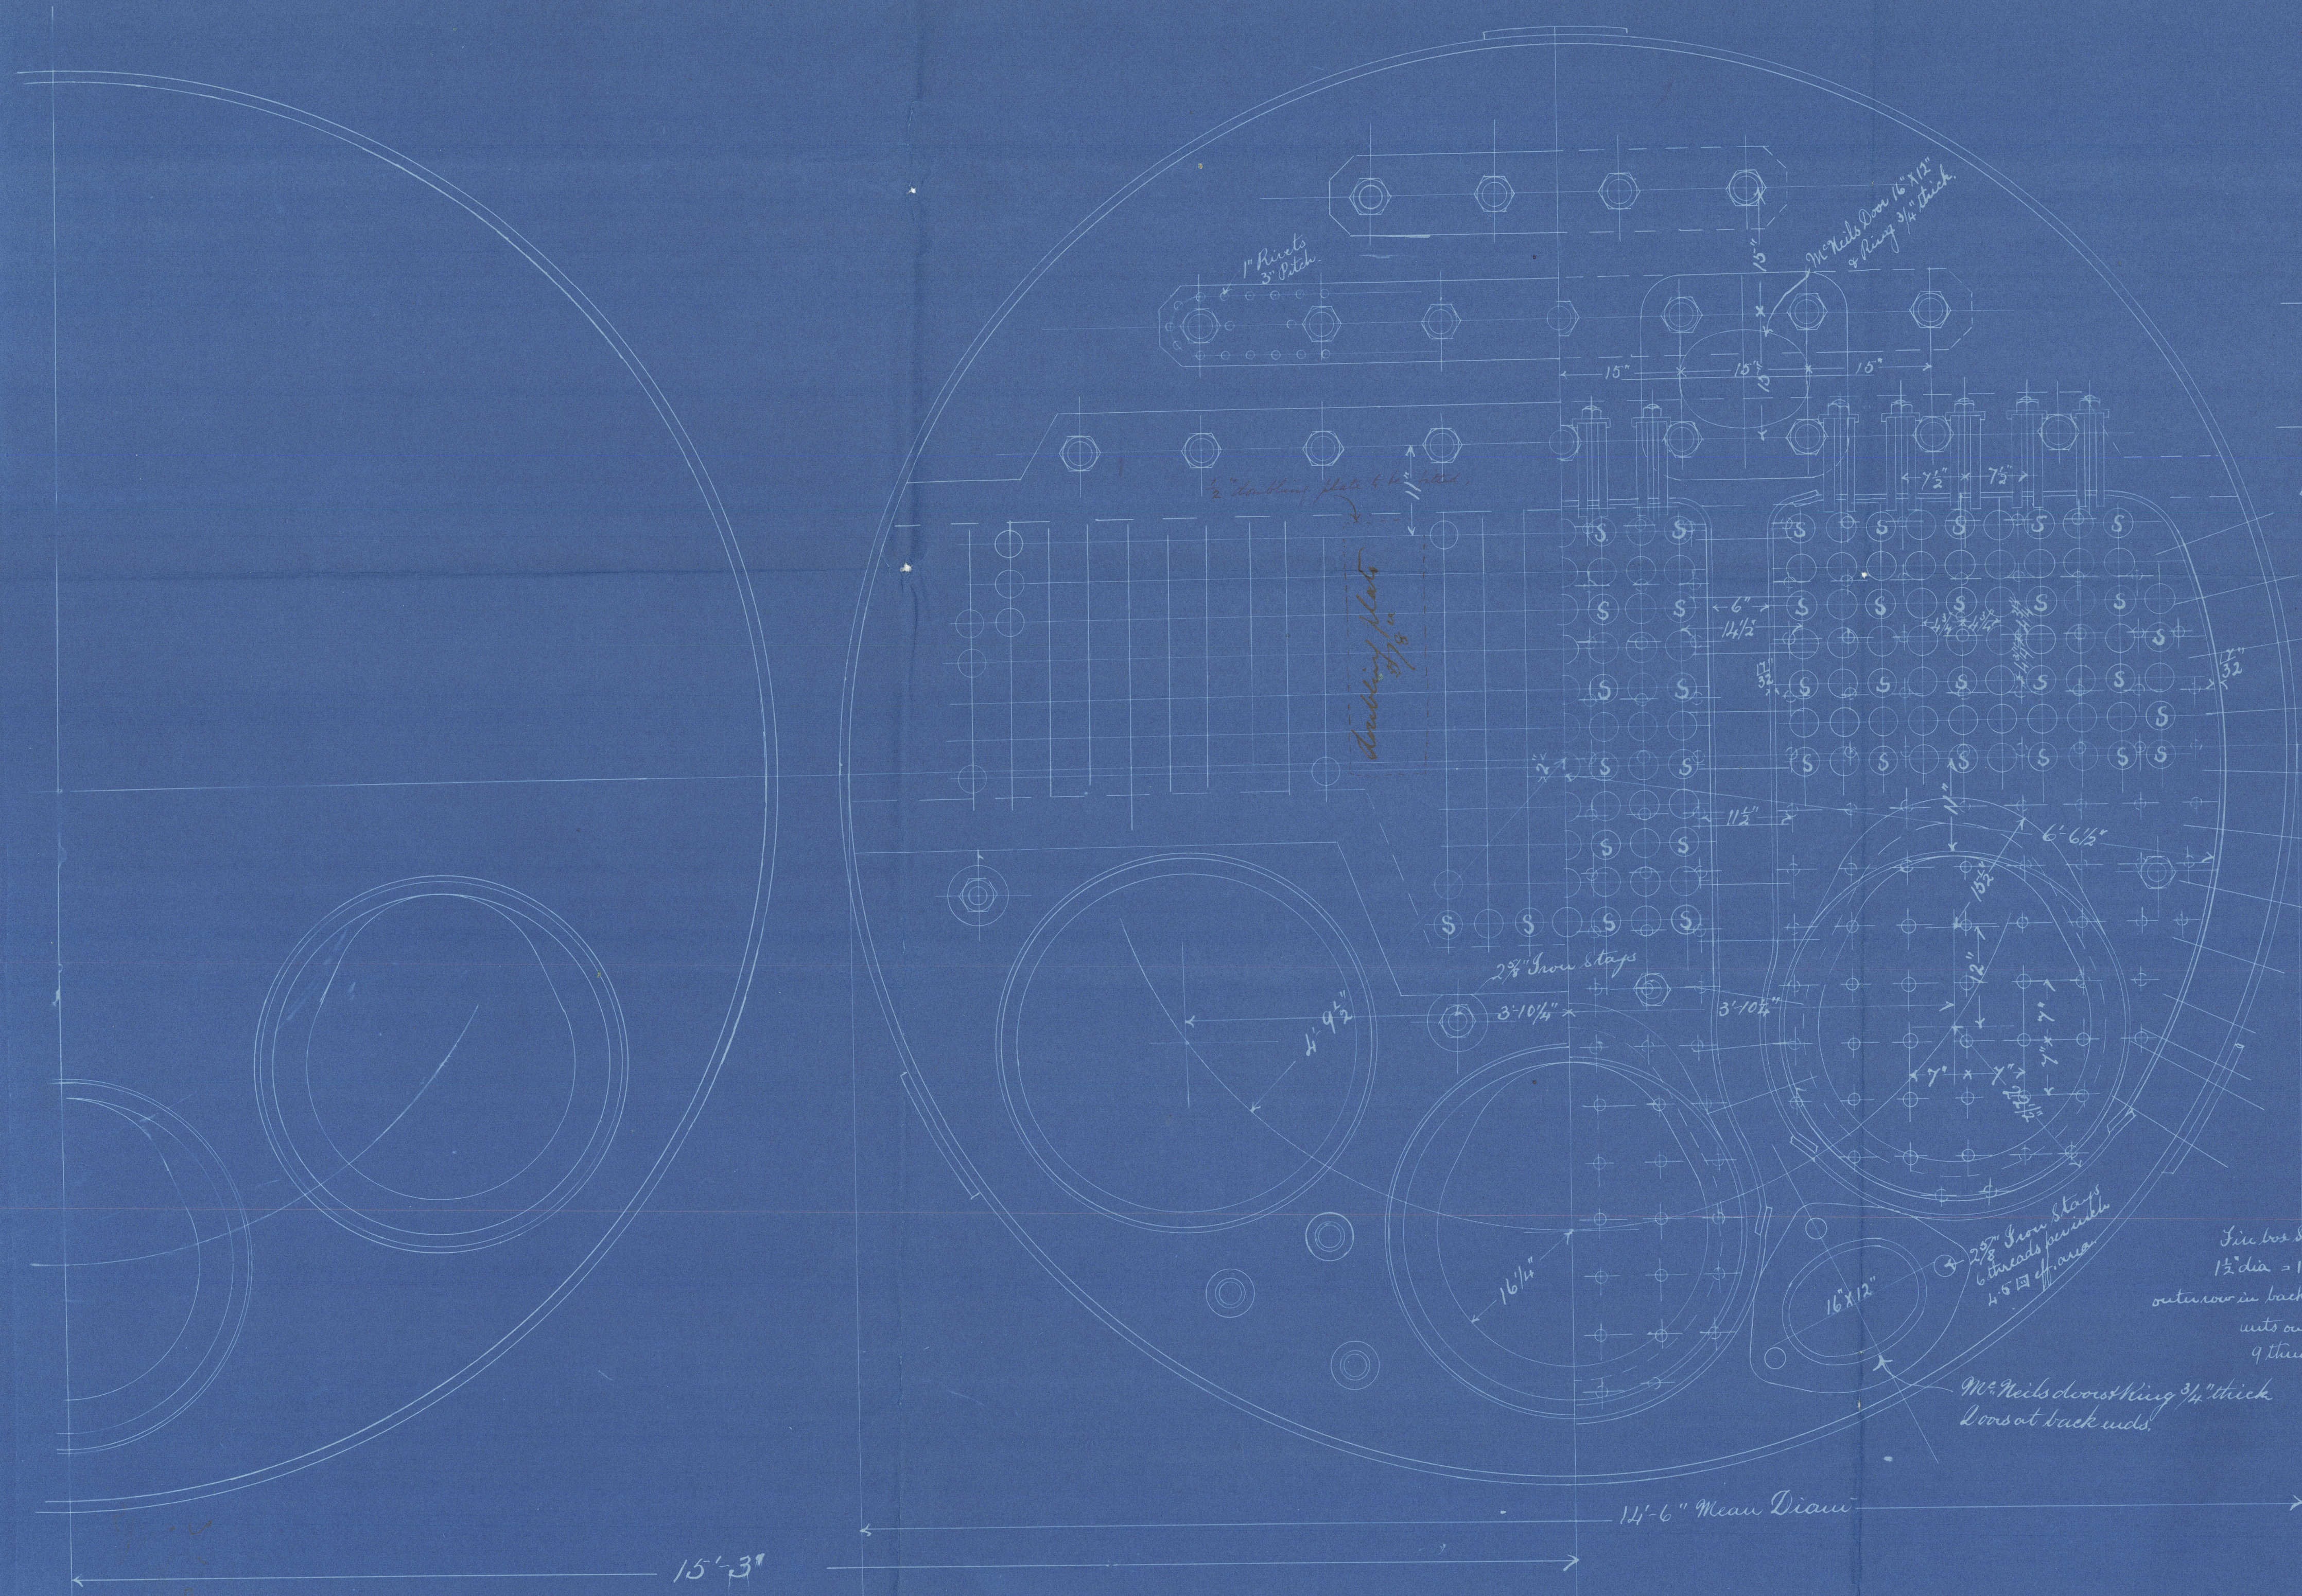

25.6.95

S. S. Kanoan



Leith Report 2047
Watson

Mr B Grayth 185-
LM



© 2021

Lloyd's Register
Foundation