
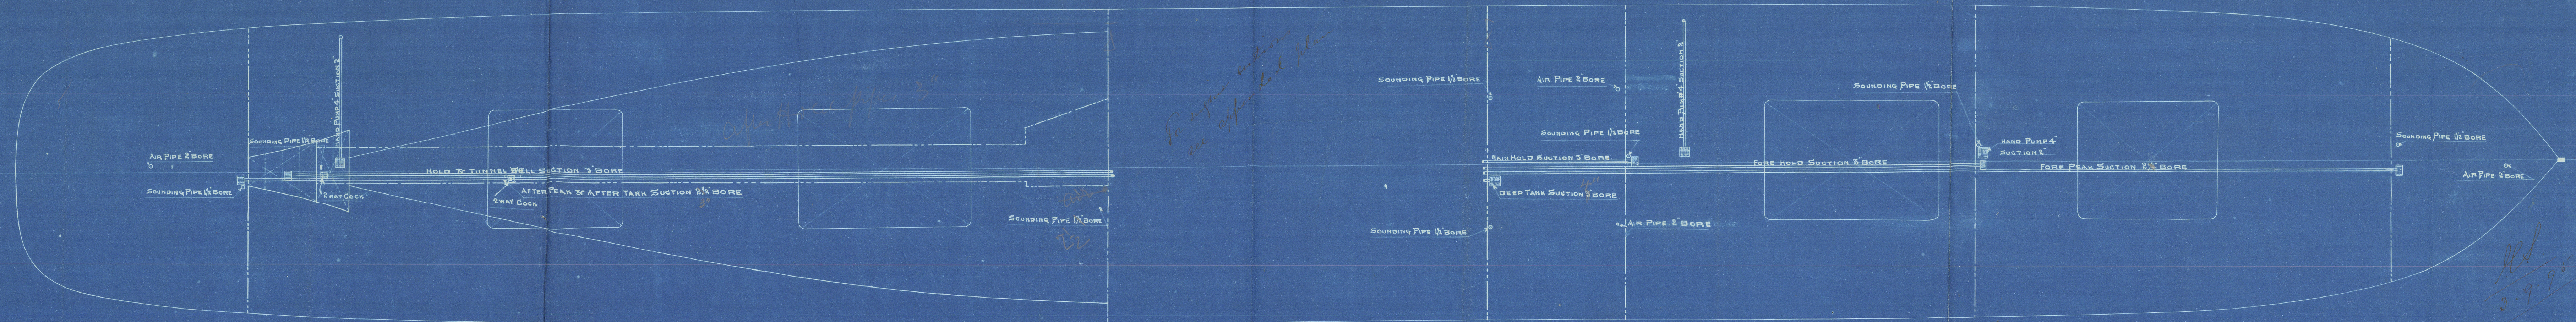



4.9.95

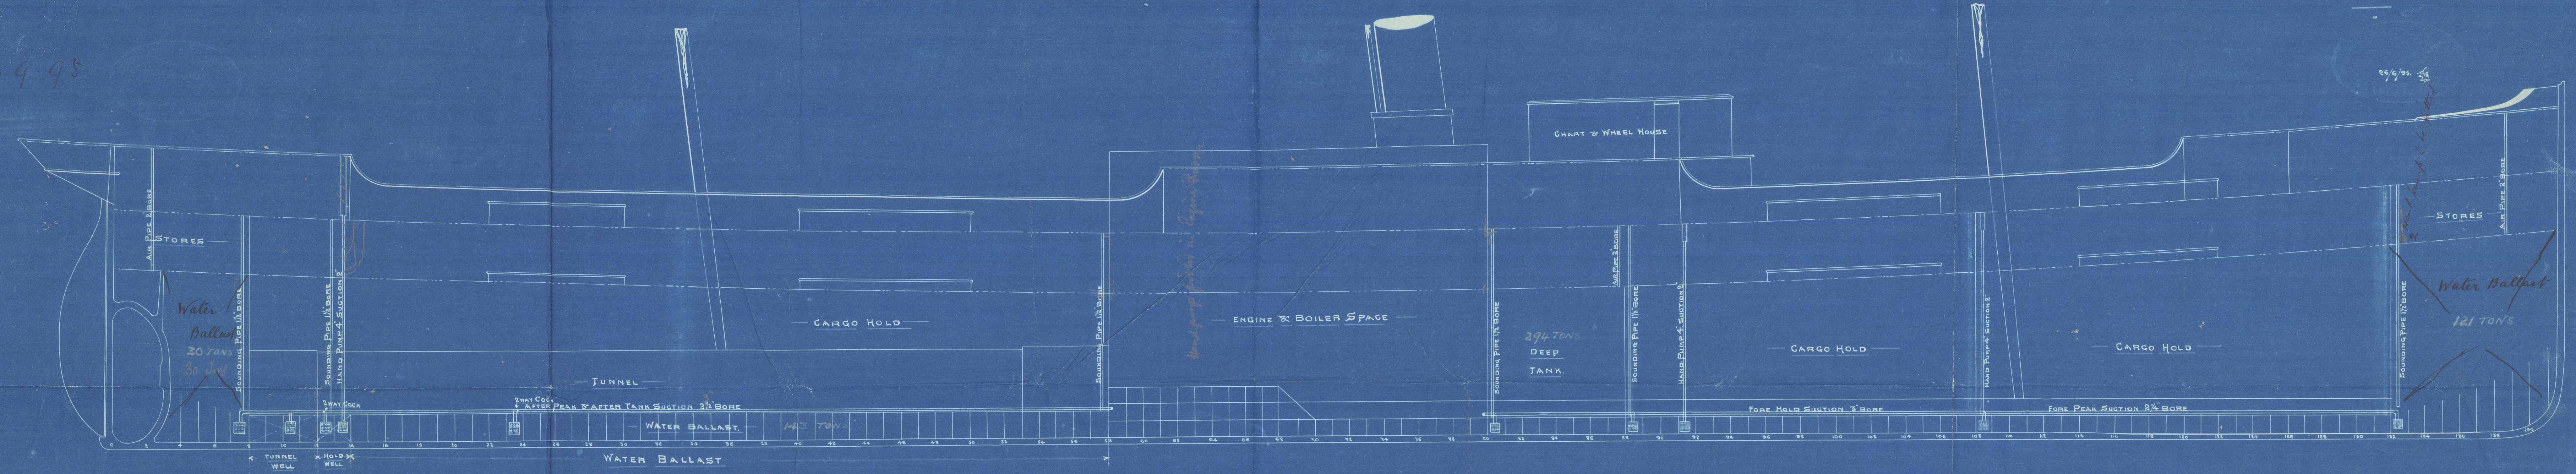

For engine room see appended plan

4.9.95

S. S. "Nanshan"
Lth. Rept. No 8047.

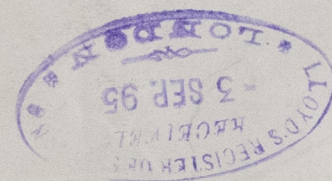

© 2021

Lloyd's Register
Foundation