



S. S. "Giang Leng"
Lth Rept. No 8119

LTH566-0005




© 2019

Lloyd's Register
Foundation

56

4. 11. 95-

55° 70' 95"
 Length 235'-0" x Breadth 34'-0" x Depth 14'-6"
 Scale 1/8" = 1 ft.

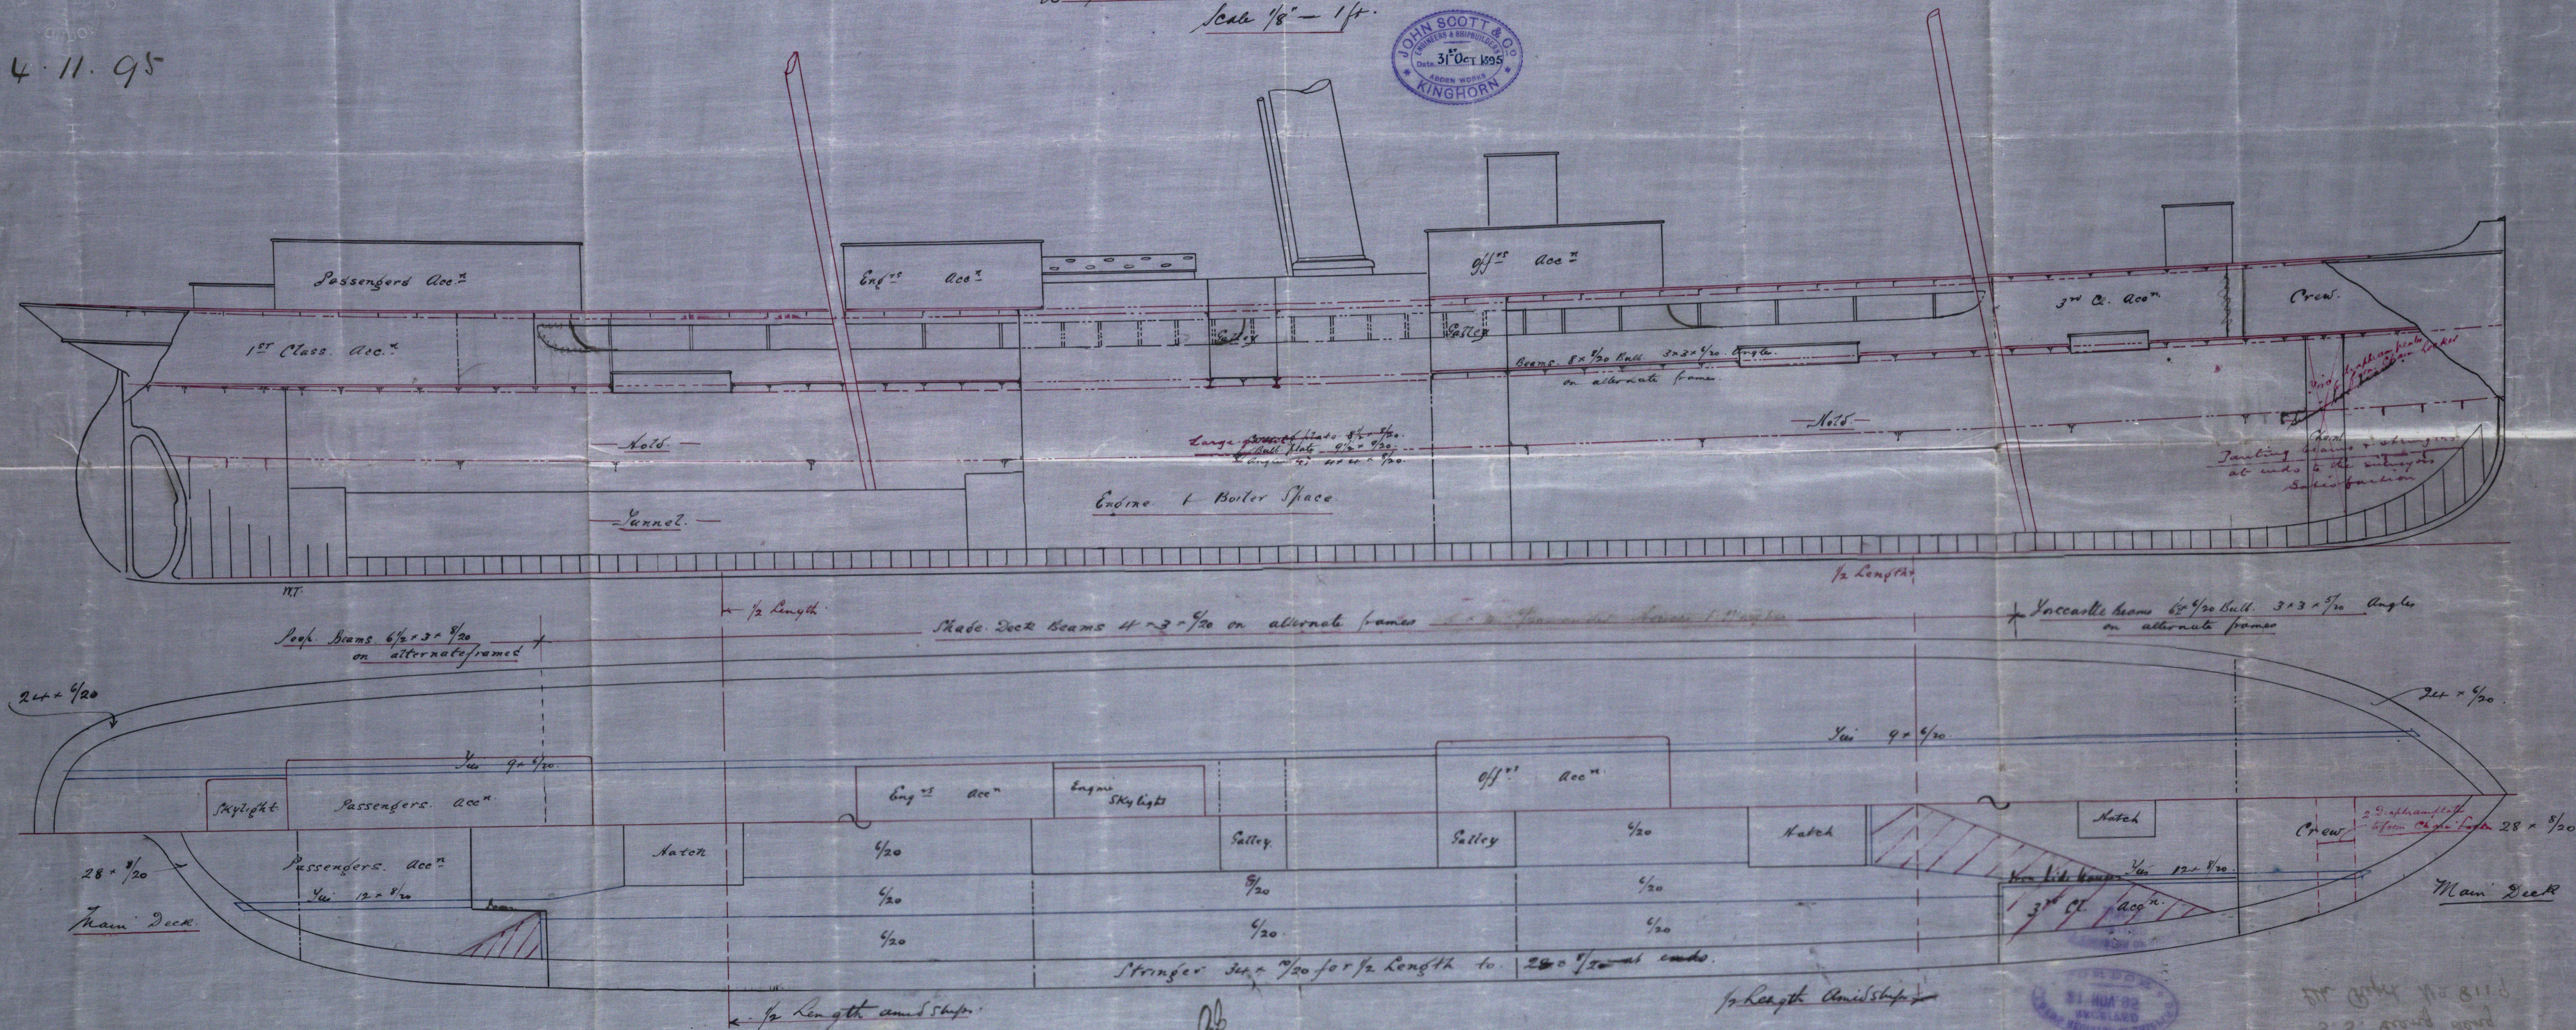

4.11.95

LTH566-0005