

Midship Section — "Giang Leng" — S S No 95 —

— Length 235'-0" Breadth 34'-0" Depth 14'-6" M.L. —

— Scale 2" = 1 foot —


Class 100 at (Steel)



Port & Side Stringer, 24" x 4 1/2"
Shade " 24" x 6 1/2"
Angles 3" x 3" x 1/2"

Section in way of
Shade Deck.

4. 11. 95
25. 11. 95

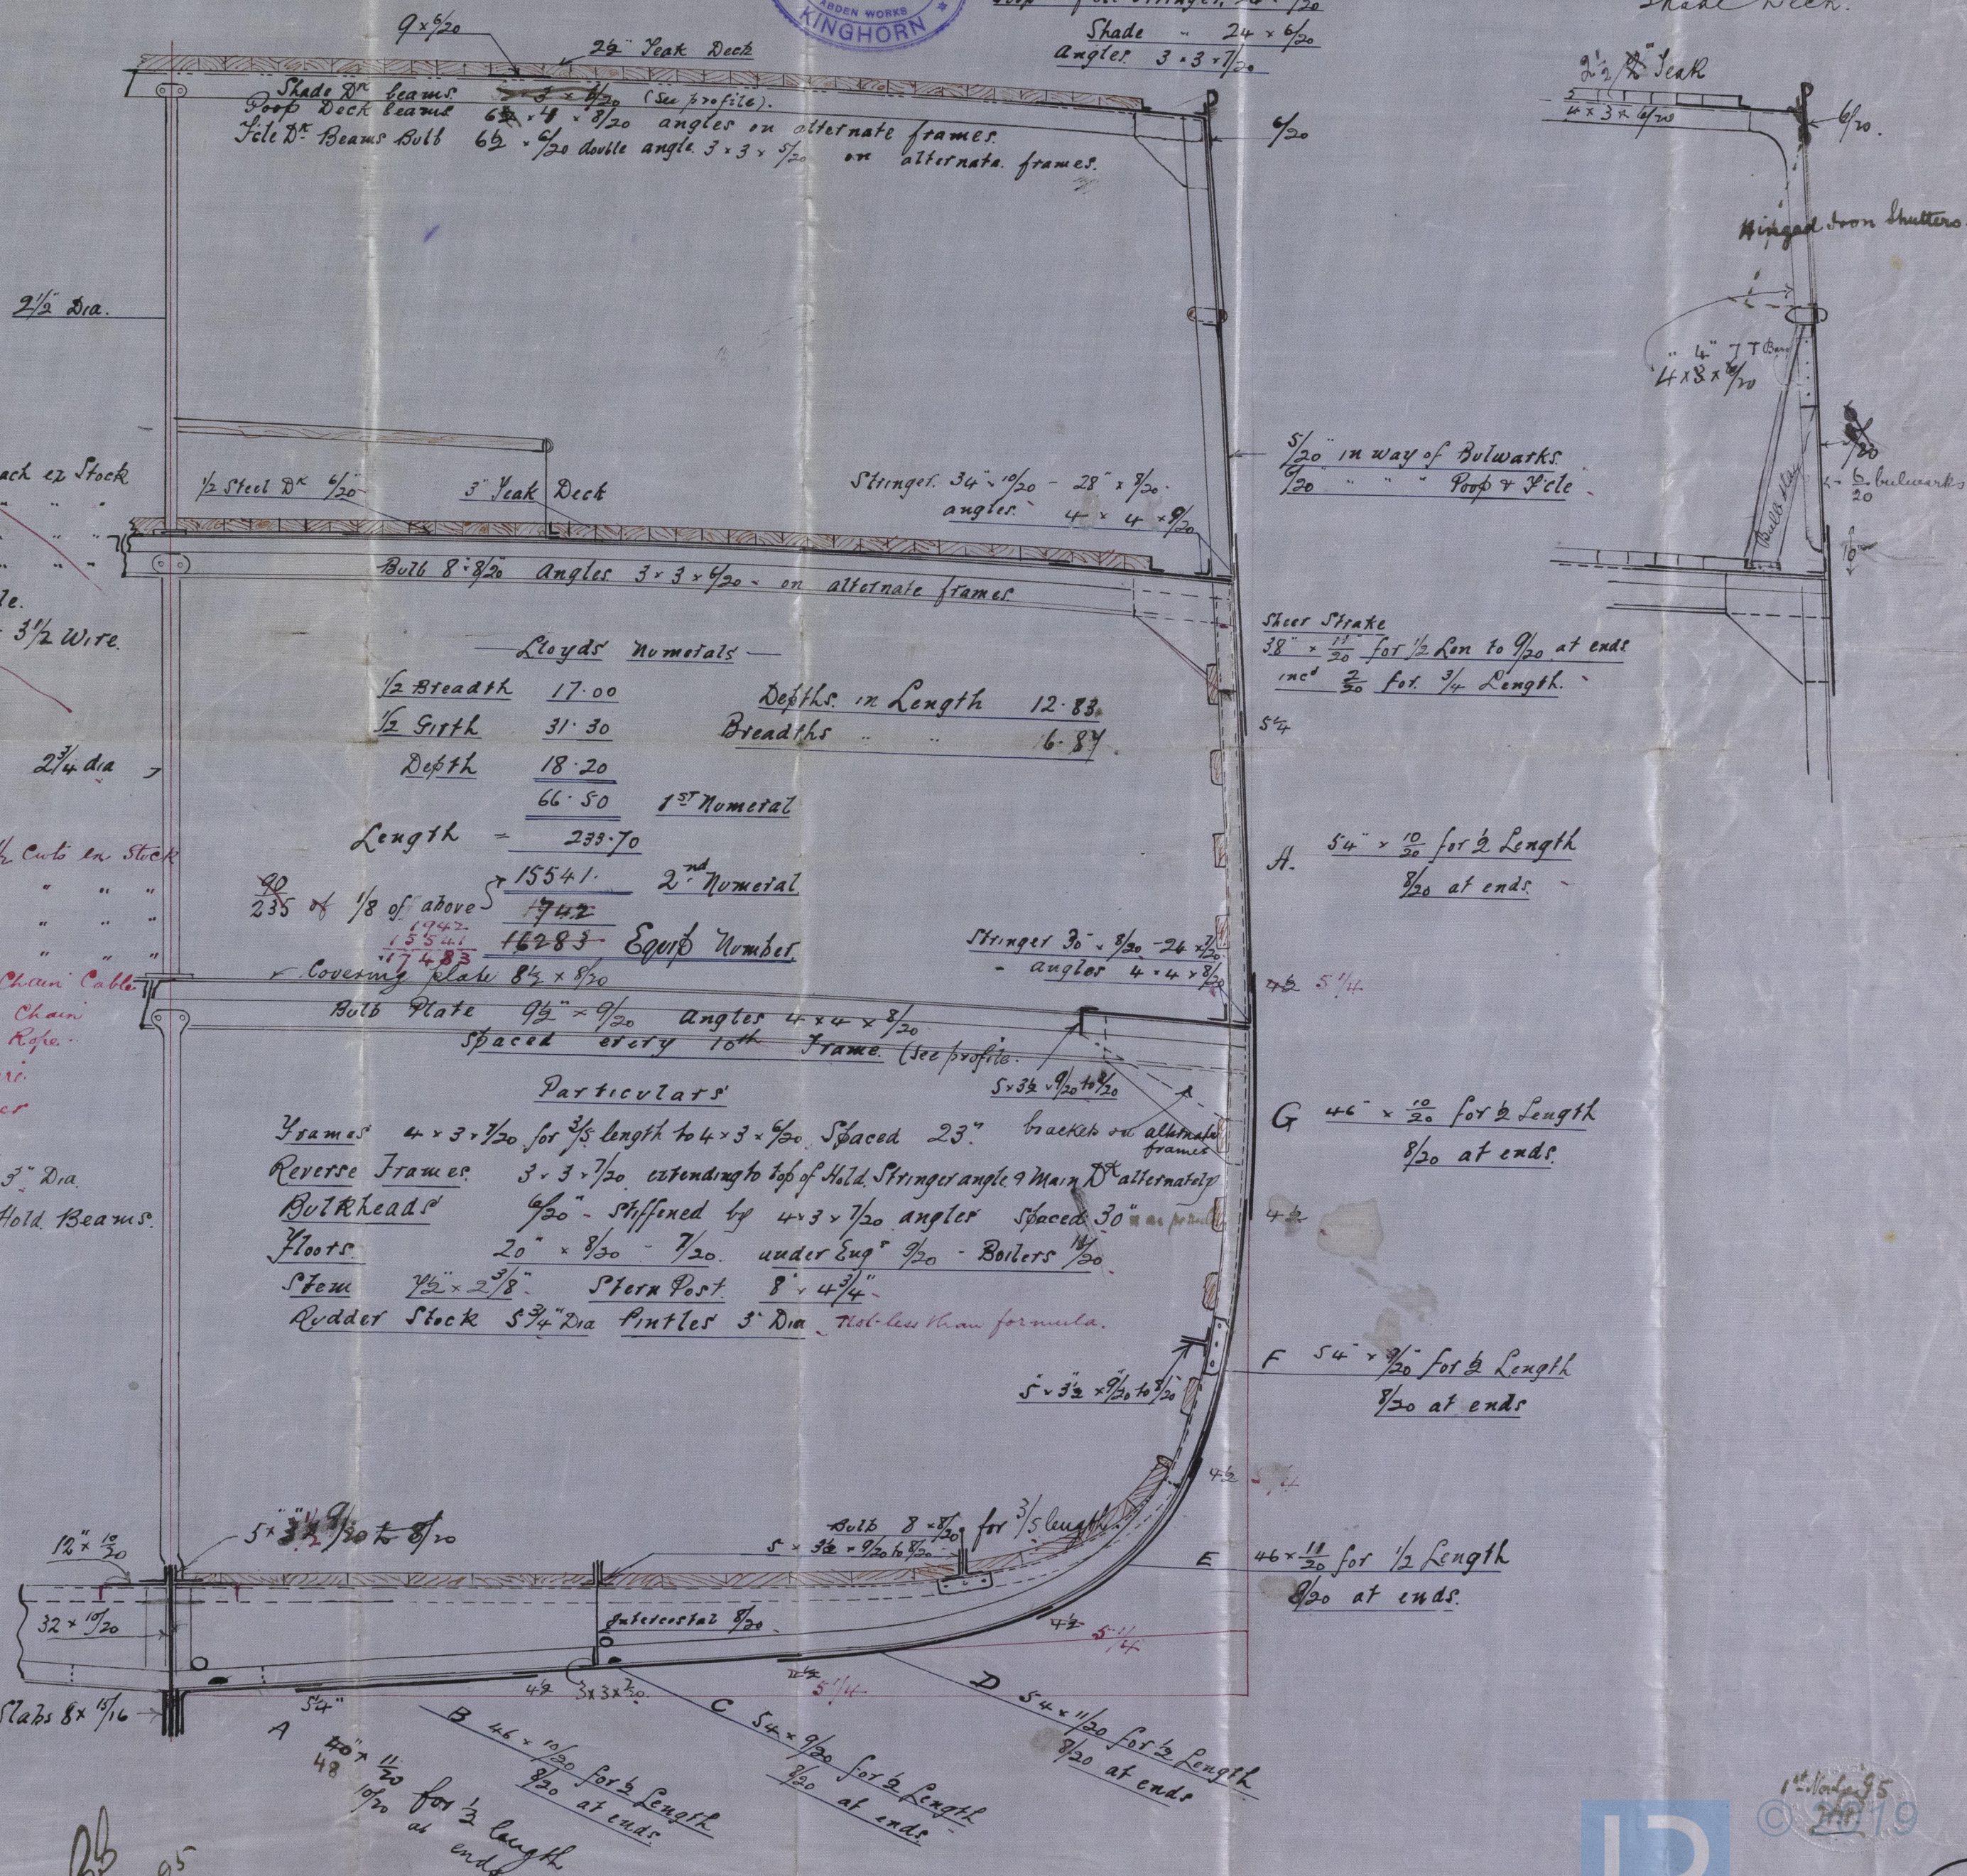

- Equipment —
- 2 Bower Anchors 2 1/2 Cwt each in Stock
 - 1 Stream " 18 " " "
 - 1 Kedge " 3 1/2 " " "
 - 240 fms. 1 1/8" Stud Link Cable.
 - 75 fms. 1/2" Stream Chain or 3 1/2 Wire.
 - 90 " 3/4" Steel Wire
 - 90 " 8" Hawser
 - 90 " 5 1/2 " "

- Equipment —
- 2 Bower Anchors. 2 3/4 Cwt in Stock
 - 1 " " 20 " " "
 - 1 Stream " 8 " " "
 - 1 Kedge " 14 " " "
 - 240 fms. 1 1/8" Stud Chain Cable.
 - 75 fms. 1/2" Stream Chain or 3 1/4" Wire Rope.
 - 90 fms. 3/4" Steel Wire
 - 90 " 8" Hawser
 - 90 " 6 " "

Hold Pillars 3" Dia.
3 3/4" where no Hold Beams.

— Lloyd's Nominals —

1/2 Breadth	17.00	Depth in Length	12.83
1/2 Girth	31.30	Breadths	6.84
Depth	18.20		
	66.50	1 st Nominal	
Length	233.70		

235 of 1/8 of above = 15541. 2nd Nominal
1742
15541 + 1742 = 16283 Equip Number

Covering Plate 8 1/2" x 9 1/2"
Bulb Plate 9 1/2" x 9 1/2" Angler 4" x 4" x 3/20
Spaced every 10th Frame (See profile).

Particulars

Frames 4" x 3" x 1/20 for 3/5 length to 4" x 3" x 1/20. Spaced 23" bracket on alternate frames

Reverse Frames 3" x 3" x 1/20 extending to top of Hold Stringer angle 9 Main & alternately

Bulkheads 4 1/2" - Stiffened by 4" x 3" x 1/20 Angler Spaced 30" as profile

Floors 20" x 8 1/2" x 1/20 under Eng 9 1/2" - Boilers 1 1/2"

Stem 1 1/2" x 2 1/8" Stern Post 8" x 4 1/4"

Rudder Stock 5 3/4" Dia Pintles 3" Dia - Not less than formula.

Sheer Strake
38" x 1 1/2" for 1/2 Run to 9 1/20 at ends
inc 20 for 3/4 Length.

A. 54" x 10 1/20 for 1/2 Length
8 1/20 at ends

G 46" x 10 1/20 for 1/2 Length
8 1/20 at ends

F 54" x 9 1/20 for 1/2 Length
8 1/20 at ends

E 46" x 11 1/20 for 1/2 Length
8 1/20 at ends

4. 11. 95


S. S. "Giang Leng"
Lth. Report - No 8119.

A circular purple ink stamp. The outer ring contains the text "LLOYD'S REGISTER OF SHIPPING" at the top and "LONDON" at the bottom. In the center, the word "RECEIVED" is printed above the date "2 NOV. 35".

LLOYD'S REGISTER OF SHIPPING
RECEIVED
21 NOV 95
LONDON


© 2019

Lloyd's Register
Foundation