

Lloyd's Register of British and Foreign Shipping.

(Report on Vessel No. 8119 Port *Leith*)

No. SHIP FORGINGS OR CASTINGS.

I have to report that the undermentioned Iron ~~or Steel~~ Forgings ~~or Castings~~,
 manufactured by *The Life Forge Co*
 of *Sinclairtown* for the Vessel No. *95*, being built
 by *John Scott & Co* of *Kinghorn*
 have been inspected by me as set forth below, and found to be, so far as can be seen,
sound


Mark on Forgings.

Lloyd's

No. *264**L. L.**Thomas Meld**Leith**28/12/95*

	STERN FRAME.	RUDDER FRAME.	STEM.
Material* ...	<i>Scrap iron</i>		<i>Scrap iron</i>
How made ...	<i>Forged & smithed</i>		<i>Forged & smithed</i>
Dimensions ...	<i>8" x 4³/₄"</i>		<i>7¹/₂" x 2³/₈"</i>
Progress on Inspection	<i>Rough & finished</i>		<i>Finished</i>
Date when Inspected	<i>25/11/95, 12/12/95</i> <i>& 27/12/95</i>		<i>10/12/95</i>

SKETCHES OF FRAMES SHOWING POSITION AND DESCRIPTION OF WELDS OF FORGINGS, OR PARTICULARS OF
 TESTS APPLIED TO CASTINGS.

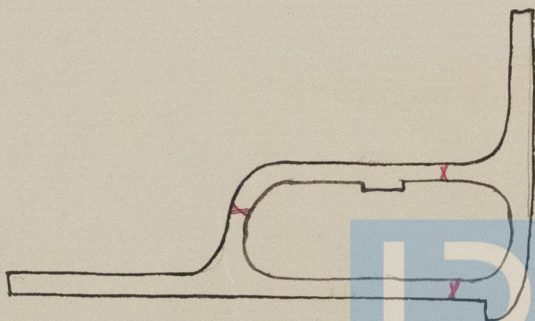

© 2019

Lloyd's Register
Foundation

S. S. "Liang Leng"
Lth. Rept. No 8119



© 2019

Lloyd's Register
Foundation