

## Lloyd's Register of British and Foreign Shipping.

(Report on Vessel No. 8138 Port *Leith*)No. *3109*

## SHIP FORGINGS OR CASTINGS.

I have to report that the undermentioned Iron ~~or Steel~~ Forgings ~~or Castings~~,  
 manufactured by *Messrs Emmerson Waller & Thompson*  
 of *Dunston* for the Vessel No. *56*, being built  
 by *Messrs Hawthorn & Co* of *Leith*  
 have been inspected by me as set forth below, and found to be, so far as can be seen,  
*Sound*



Mark on Forgings.

Lloyd's

No. *5338/3**JB**John C Craig**Newcastle*  
*18.5.96*

	STERN FRAME.	RUDDER FRAME.	STEM.
Material*	<i>Scrap Iron</i>	/	
How made	<i>Forged</i>		
Dimensions	<i>5 1/4 - 2 1/4</i>		
Progress on Inspection	<i>Forged &amp; Smithed</i>		
Date when Inspected	<i>March 4-6-10-13/96</i>		

SKETCHES OF FRAMES SHOWING POSITION AND DESCRIPTION OF WELDS OF FORGINGS, OR PARTICULARS OF TESTS APPLIED TO CASTINGS.

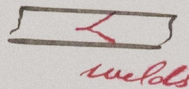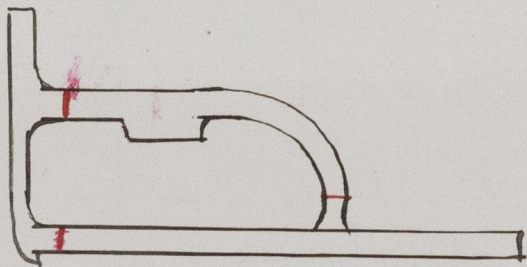

Fee (if any chargeable) £ : :

To be paid at



© 2019

Lloyd's Register  
Foundation



Line Fishing 1.1. "Kellie Castle"

Lth. Report, No. 8138.



© 2019

Lloyd's Register  
Foundation