



# MIDSHIP SECTION

STEAM LINE FISHING BOAT 18 56 x 57 x 59

LENGTH BETWEEN PERPS - - 90'-0"  
BREADTH MOULDED - - 19'-0"  
DEPTH DO - - 10'-6"


SCALE 1" = 1 FOOT

CLASS 100 A STEEL

N:56 "Kellie Castle"

Lth. Rept. N:

6. 2. 96  
15. 2. 96

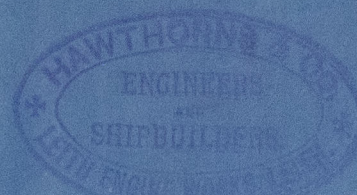

Feb 15/96

4-68 BREADTHS TO LENGTH  
8-16 DEPTHS TO LENGTH

NUMERALS

1/2 BREADTH	=	9'-5"
DEPTH	=	10'-8 3/4"
1/2 GIRTH	=	16'-5"
		36.83 1 <sup>st</sup> NUM
LENGTH		89.08
		3287.94 2 <sup>nd</sup> NUM
		3280.81

EQUIPMENT  
UNDER DECK TONNAGE 99  
3 Anchors 3 1/2 3 1/2 & 2 cwt ea stock  
60 FATHOMS 3/16 STUD CHAIN & B.L.  
60 " 5/16 HWSER  
60 " 3 WGRP

RIVETTING  
BUTTSTRAPS OF SHEERSTRAKE TO BE 1/16"  
Thicker than plate for 1/2 L & D T  
BUTTSTRAP OF STRINGER 1/20 THICKER THAN  
PLATES FOR 1/2 L & D T  
BUTTSTRAPS OF GARBOARD D.T.  
REST OF PLATING OVER LAPPED BUTTS  
T.P. FOR 1/2 L & D.T. AT ENDS

PILLARS 2 1/4" DIAM

FRAMES 2 1/2 x 2 1/2 x 1/20 SPACED 20" APART  
REV. FRAMES 2 1/2 x 2 1/2 x 1/20 TO EXTEND TO  
UPPER TURN OF BILGE ON EVERY FRAME TO BE  
DOUBLE IN E & S SPACE  
FLOOR 5 15 x 1/20 UNDER ENGINE 1/20 " BOILER 1/20  
BULKHEAD 1/4" ANGLES 2 1/2 x 2 1/2 x 1/20  
PILLARS 2 1/4" DIAM ON EVERY BEAM  
KEEL 6 x 1 1/8" STEM 6 x 1 1/8" STERNPOSTS 1/4 x 1/4  
RUDDER HEAD & KEEL 2 1/8" SINGLE PLATE 1/20

CEILING 2" H.P.

RISE PLATE FOR 3/4 L 6 1/2 x 1/20  
ANGLES 3 x 3 x 1/20  
WEB PLATE 2 1/2 x 1/20 FOR 1/2 L TO 20

STRINGER ANGLE 3 x 3 x 1/20  
STRINGER PLATE 20 x 1/20 FOR 1/2 L  
TO 15' x 1/20 AT ENDS  
GUTTER BAR 3' x 2 1/2 x 1/20  
REPLATES 7 x 1/20 FOR 1/2 L TO 1/20

Deck 5 x 3" P.Pine

BEAMS 5 x 3 x 1/20 ON ALTERNATE FRAMES

ROUND OF BEAM 5"

5' 6"

Deck plated out to  
ship's side in way  
of boiler casing

LAP 2 1/2" S.P.

BEAD 2 1/2 x 1/4

SHEERSTRAKE 30 x 1/16 FOR  
1/2 L TO 1/16 AT ENDS

LAP 4 1/2 D.P.

5/16 FORE & AFT

HEIGHT OF REVERSE FRAMES 10'-6"

LAP 2 1/4 S.P.

5/16 FORE & AFT

LAP 2 1/4 S.P.

5/16 FORE & AFT

LAP 2 1/4 S.P.

5/16 FORE & AFT

LAP 2 1/4 S.P.

5/16 FORE & AFT x 30

KEEL 6 x 1 1/8"

9'-6"

J.D.L.

6/2/96

15/2/96





S. S. "Kellie Castle"

Rth. Rept. No 8138



LTH566-0024



© 2019

Lloyd's Register  
Foundation