





6.2.96  
15.2.96  
20.5.96

N: 56 "Kellie Castle" Lth. Rept. N:  
N: 57 "Isle of May" Lth. Rept. N:  
N: 59 "County of Life" Lth. Rept. N:

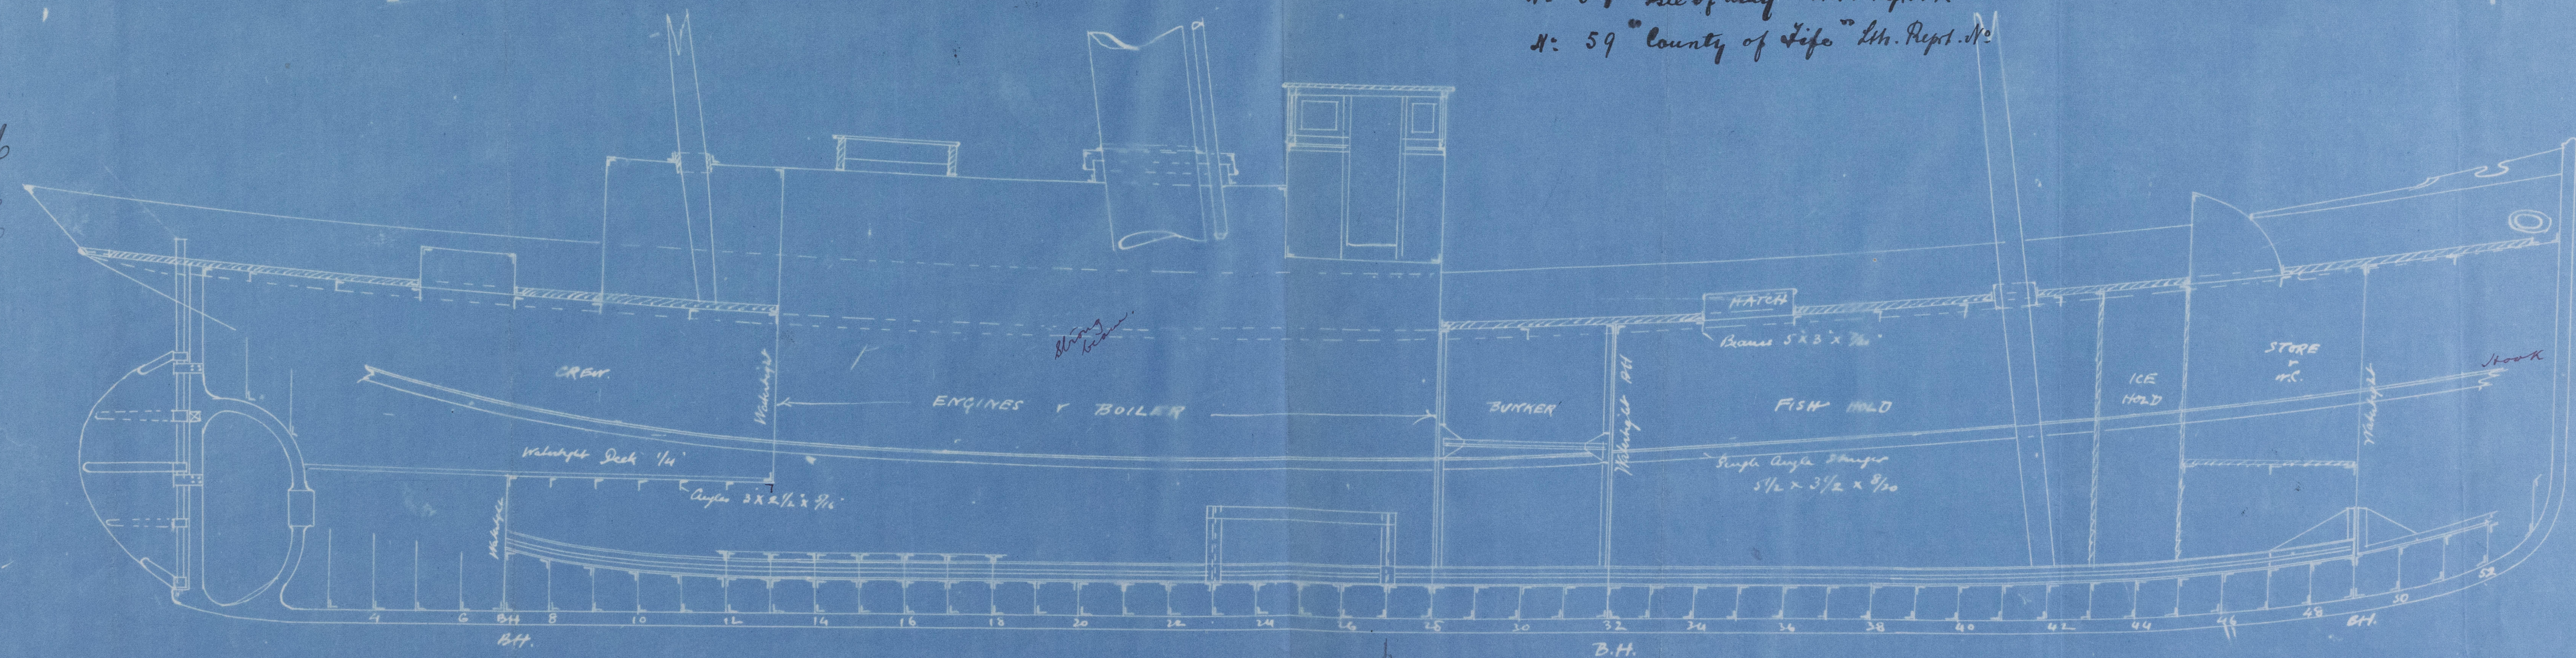


J.H.  
6/2/96 15/2/96

ELEVATION  
SS No 56 & 57 & 59  
SCALE 1/4" = 1 FOOT

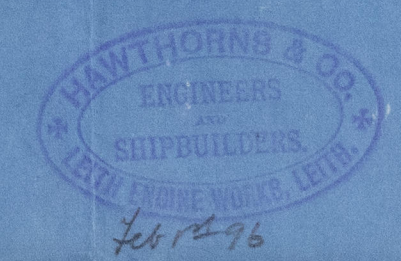



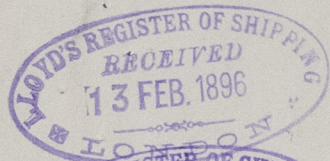

Line Fishing S. S. "Kellie Castle"

Rth. Rept. No. 8138

LTH566-0025



© 2019

Lloyd's Register  
Foundation