

Lloyd's Register of British and Foreign Shipping.

(Report on Vessel No. 8147 Port Leith)

No. 3108

SHIP FORGINGS OR CASTINGS.

The words FORGINGS or CASTINGS, IRON or STEEL, should be struck out as may be required.

I have to report that the undermentioned Iron ~~or Steel~~ Forgings ~~or Castings~~, manufactured by Messrs Emmerson Walker & Thompson of Dunston for the Vessel No. 57, being built by Messrs Hawthorn & Co of Leith have been inspected by me as set forth below, and found to be, so far as can be seen, sound



Mark on Forgings.

Lloyd's
No. 53320
JB

John C Craig
Newcastle
18.5.96

	STERN FRAME.	RUDDER FRAME.	STEM.
Material* ...	<u>Scrap Iron</u>	/	
How made ...	<u>Forged</u>		
Dimensions ...	<u>5/4 - 2/4</u>		
Progress on Inspection	<u>Forged & Smithed</u>		
Date when Inspected	<u>April 1-2-13-14/96</u>		

SKETCHES OF FRAMES SHOWING POSITION AND DESCRIPTION OF WELDS OF FORGINGS, OR PARTICULARS OF TESTS APPLIED TO CASTINGS.

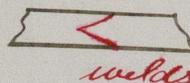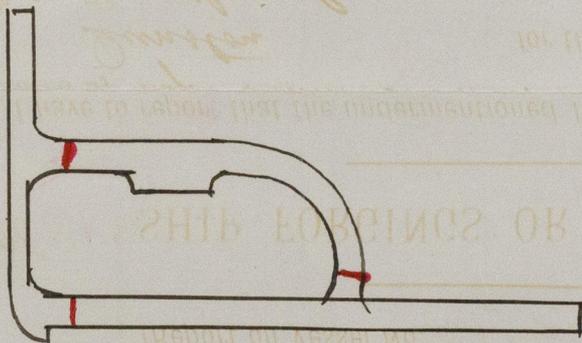

Fee (if any chargeable) £ : : :

To be paid at



© 2019

Lloyd's Register
Foundation

* If of Iron, state whether scrap or puddled Iron.

"Sole of May"

Lth. Rept. No. 8147.



© 2019

Lloyd's Register
Foundation