

Received at

Office.

159

Please attach
Lloyd's Register of British and Foreign Shipping.
Lch 8170

Lloyd's Register of British and Foreign Shipping.

(Report on Vessel No. 8170 Port Leith)

No. 110

SHIP FORGINGS OR CASTINGS.

The words FORGINGS or CASTINGS, IRON or STEEL, should be struck out as may be required.

I have to report that the undermentioned Iron ~~or Steel~~ Forgings ~~or Castings~~,
manufactured by Messrs Emmerson Walker & Thompson
of Dunston for the Vessel No. 59, being built
by Messrs Hawthorn & Co of Leith
have been inspected by me as set forth below, and found to be, so far as can be seen,
sound

Mark on Forgings.


Lloyd's
No. 5359B
JB

John C Craig

Newcastle
18.5.96

	STERN FRAME.	RUDDER FRAME.	STEM.
Material* ...	Scrap Iron	/	
How made ...	Forged		
Dimensions ...	5/4 - 2/4		
Progress on Inspection	Forged & Smithed		
Date when Inspected	April 2-13-15-17/96		

SKETCHES OF FRAMES SHOWING POSITION AND DESCRIPTION OF WELDS OF FORGINGS, OR PARTICULARS OF TESTS APPLIED TO CASTINGS.

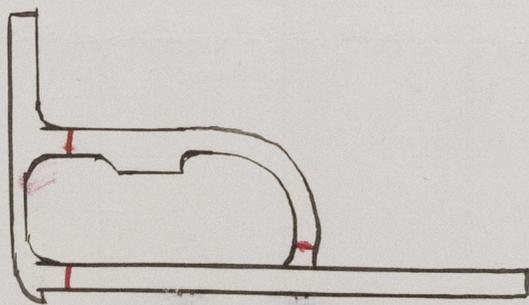

welds

Fee (if any chargeable) £ : :

To be paid at



© 2019

Lloyd's Register
Foundation

1.1. "County of Life"

Lth. Rept. No. 8170



© 2019

Lloyd's Register
Foundation