



Edinburgh &
No 1047

W.P 125th

S.S. "Guardian"

Cummings & Ellis's No 23

No 4857

Ships List
250th

R. H


17.6.96.

Rowe P33535.

S.S. "Guardian"

Lh. 8220.

© 2019

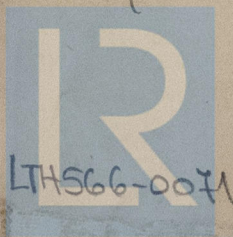

Lloyd's Register
Foundation

Mr 23.3.96

1047 Multitubular Boiler for

W. Pressure 125 lbs per sq inch
 Scale 1 foot

Tested to Lloyd's Requirements

Material
 all Plates rivets & stays
 of Steel Tubes of Iron



Shell rivetting


18 holes 4 1/2" apart

1 hole 4" apart

Heating Surface

Tubes --- 962 sq ft
 Furnaces --- 124
 6 Chambers --- 138
 Tube Plates --- 44
 Total --- 1268 sq ft.

Uptake 4' 0" sq.

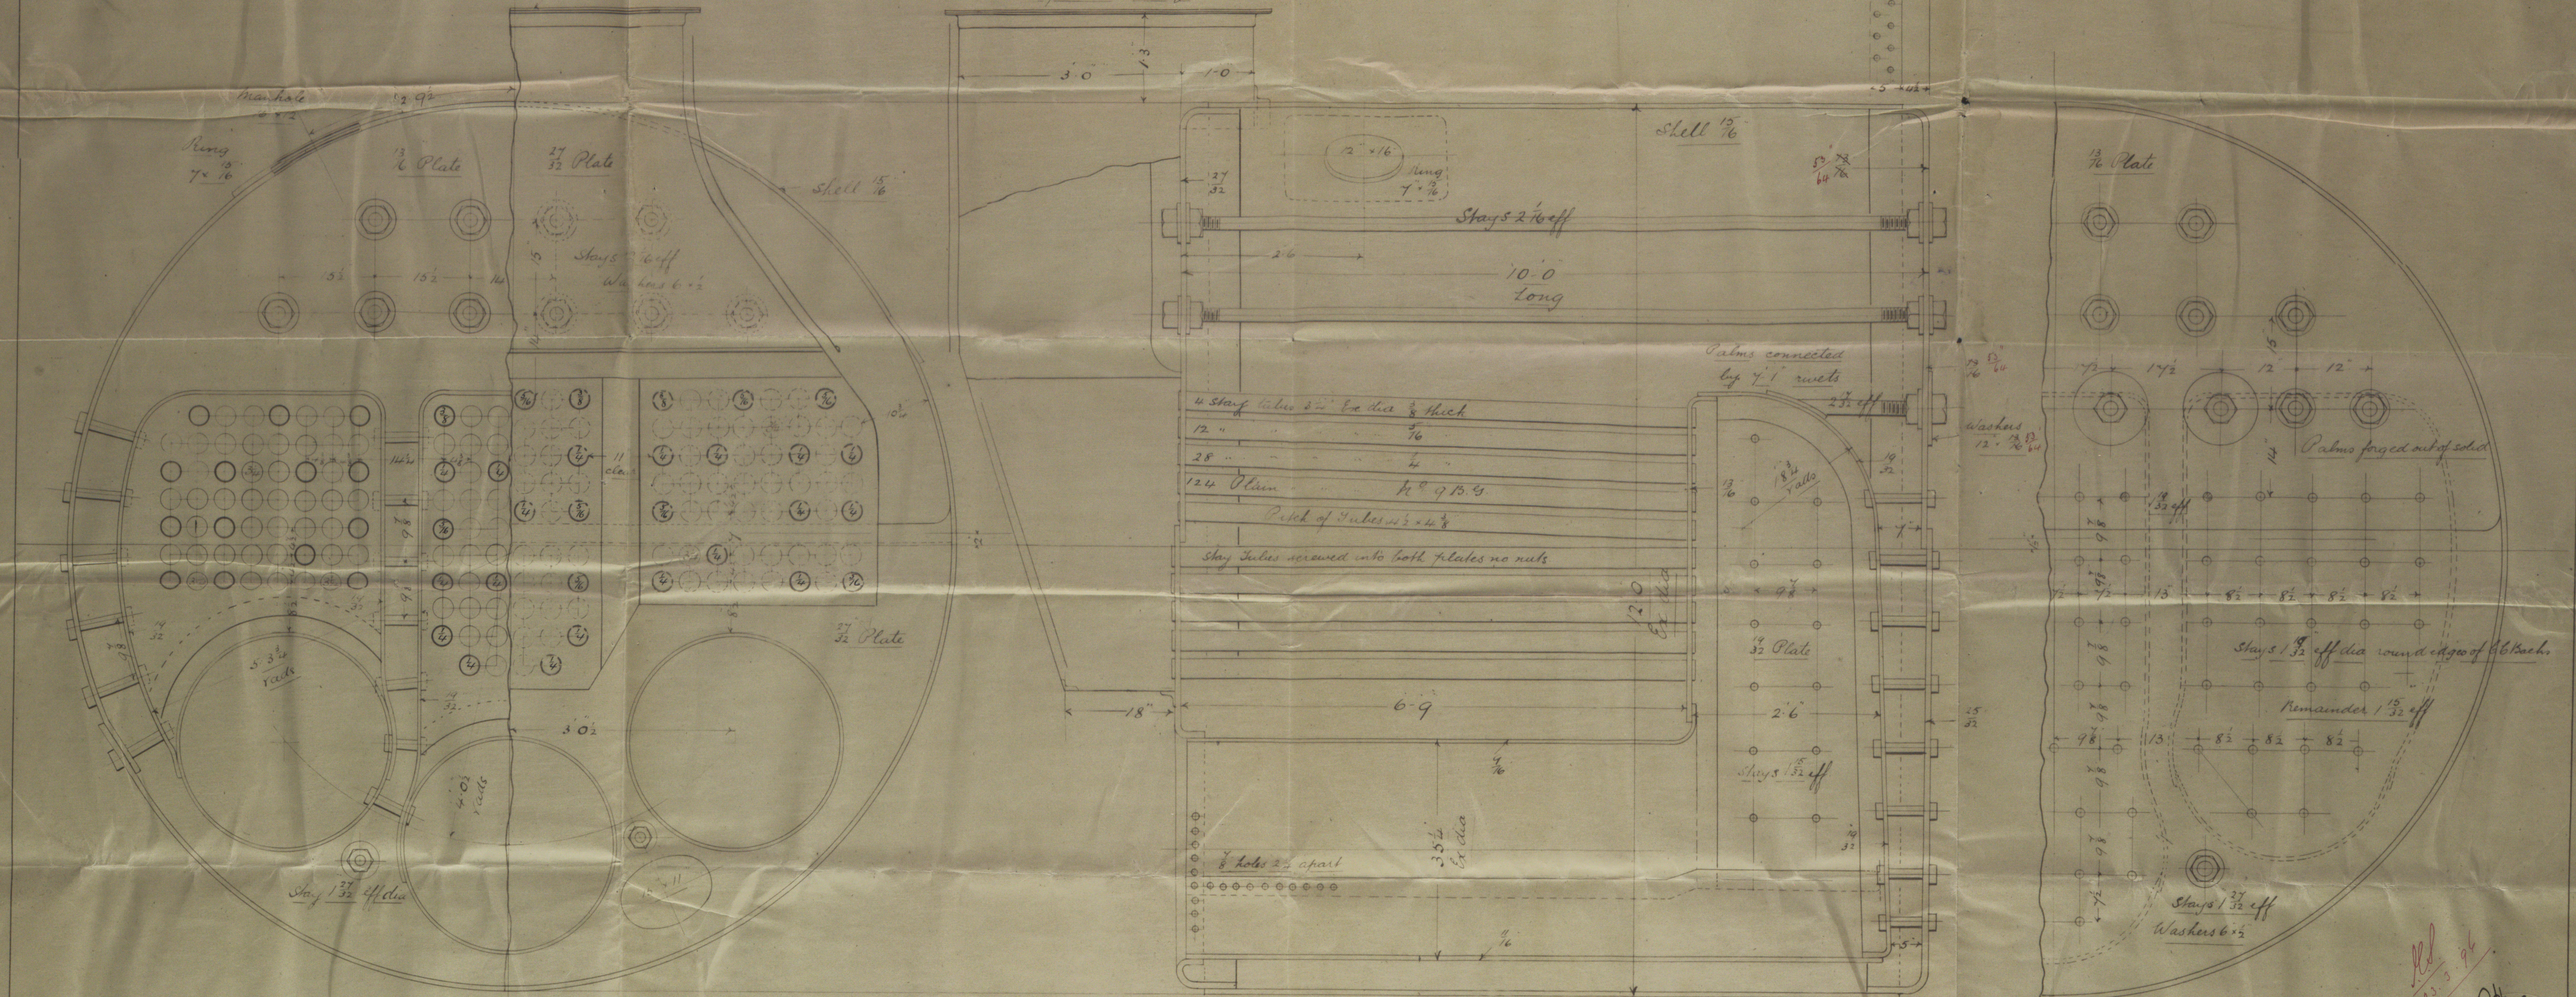

23.3.96

