

Lloyd's Register of British and Foreign Shipping.

Leith (Report on Vessel No. *8239* Port *Leith*)

No. *3281a*. SHIP FORGINGS OR CASTINGS.

I have to report that the undermentioned Iron or Steel Forgings or Castings,
 manufactured by *Mr Tho Ray*
 of *Pallion* for the Vessel No. *37*, being built
 by *Messrs John Bran & Co.* of *Leith*
 have been inspected by me as set forth below, and found to be, so far as can be seen,
sound

Mark on Forgings.

Lloyd's

No. *3281a*

W.C.


Wm Cannon
Leith

7.5.96

	STERN FRAME.	RUDDER FRAME.	STEM.
Material*	<i>Scrap iron</i>		
How made	<i>Forged</i>		
Dimensions	<i>6 x 2 1/2</i>		
Progress on Inspection	<i>Forged & smithed</i>		
Date when Inspected	<i>April 22 to 29/96</i>		

SKETCHES OF FRAMES SHOWING POSITION AND DESCRIPTION OF WELDS OF FORGINGS, OR PARTICULARS OF TESTS APPLIED TO CASTINGS.

>
Welds

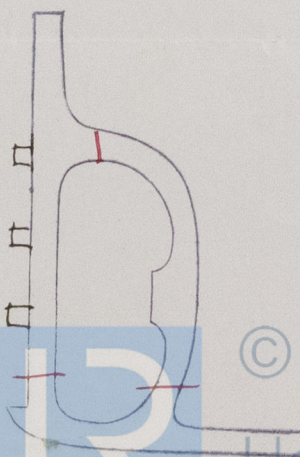

Fee (if any chargeable) £ : :

To be paid at

* If of Iron, state whether scrap or puddled Iron.

S. S. "Huskisson"

Lth. Rept. No 8239.



© 2019

Lloyd's Register
Foundation