


Hawthorn & Co  
Boiler No 941  
S K. No 62.  
170 lbs

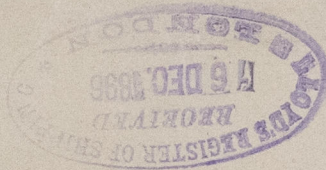

No. 400  
Lloyd's List  
340 lbs  
Y. L.  
20. 3. 97



© 2019

Lloyd's Register  
Foundation

LTH566-0149



8 No 63  
app<sup>d</sup> 16/12/96