


J. Scott & Co. S. F. No 99

"Jaffa"

Rudder plan

Lth. Repth. No 8452

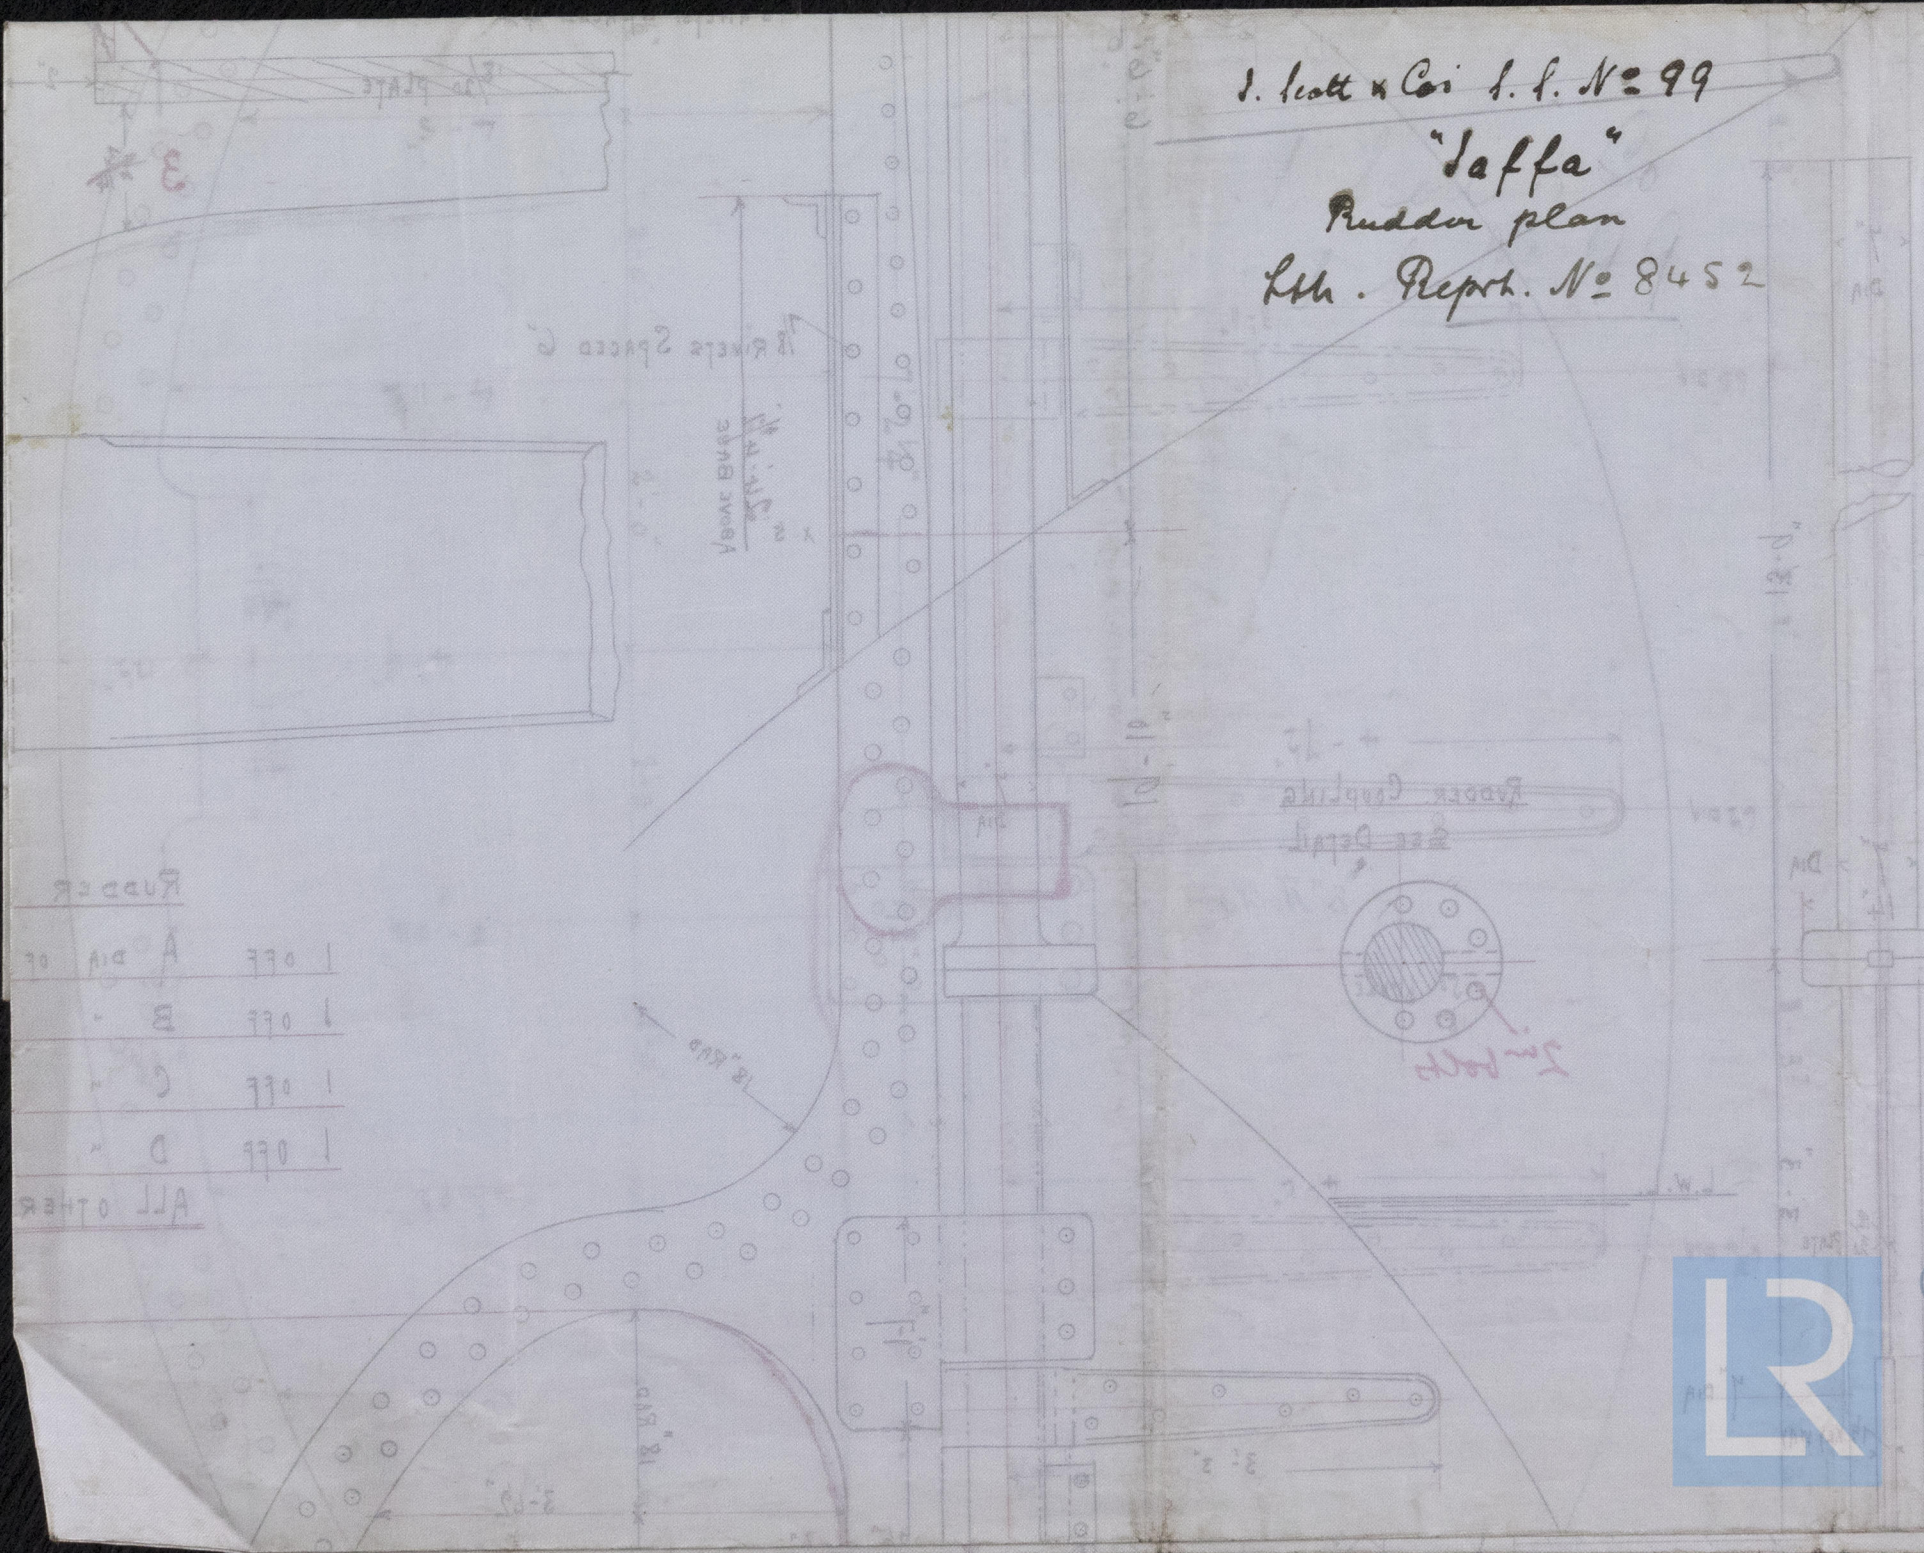

Rudder

A	1 off
B	1 off
C	1 off
D	1 off

ALL OTHER








© 2019

Lloyd's Register
Foundation

LTH566 0175

1. 1. "Laffa"
Lth. Repth. No 8452

— UPPER GUDGEON & STOPPER. —
SCALE 3" = 1 FOOT

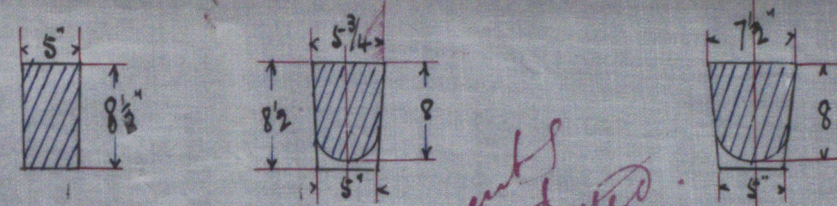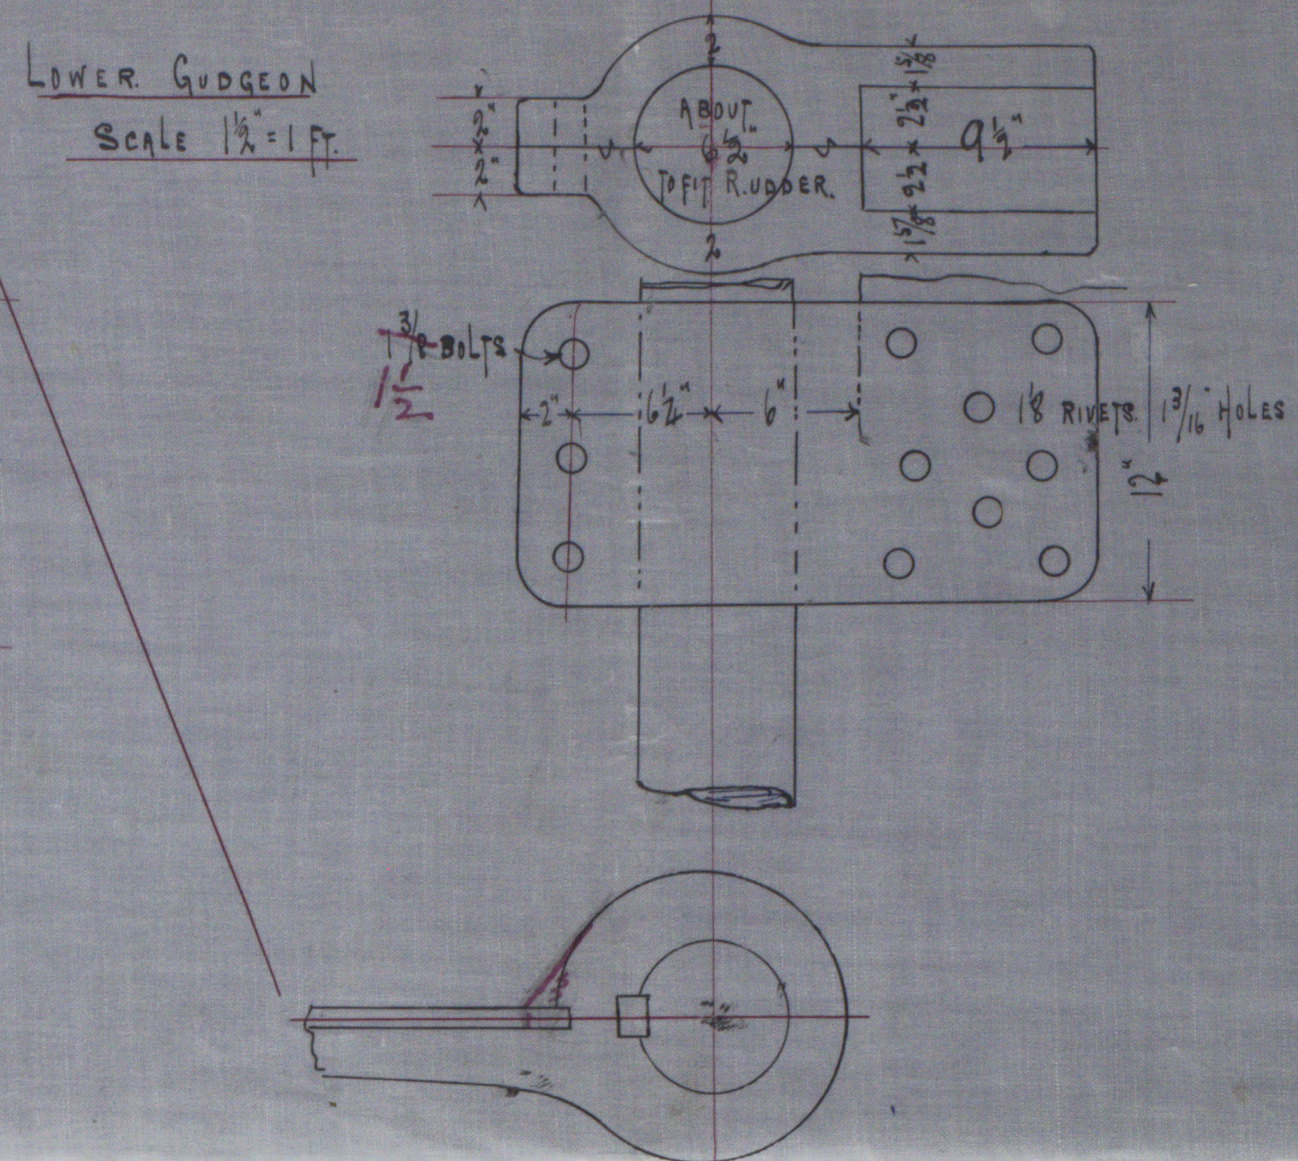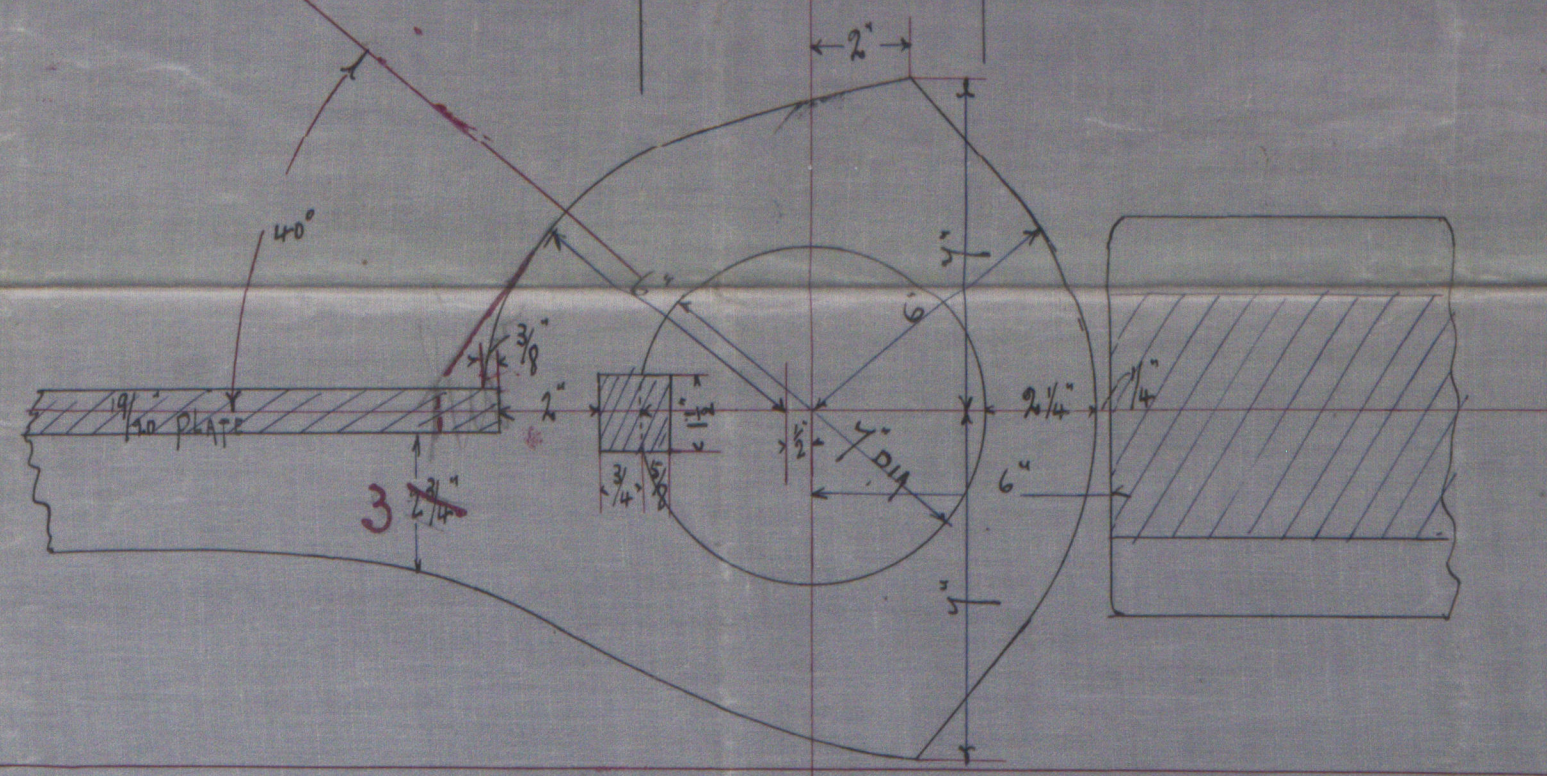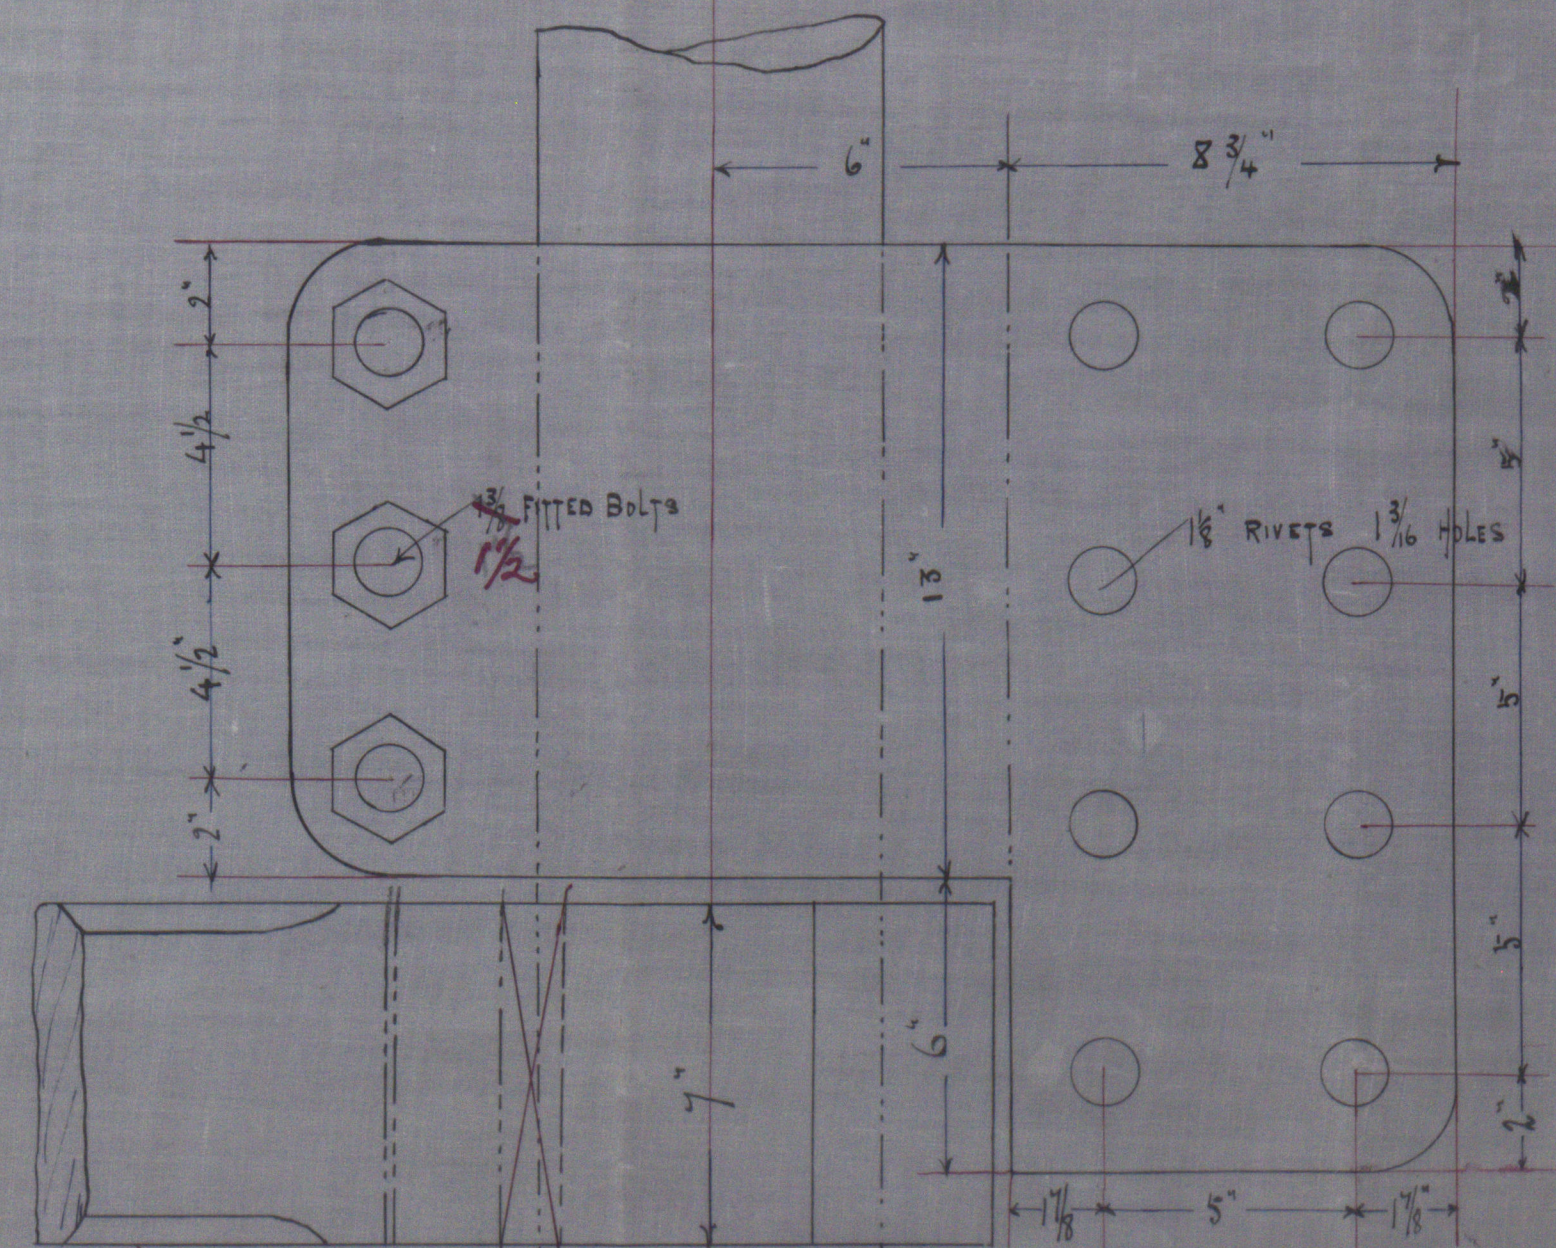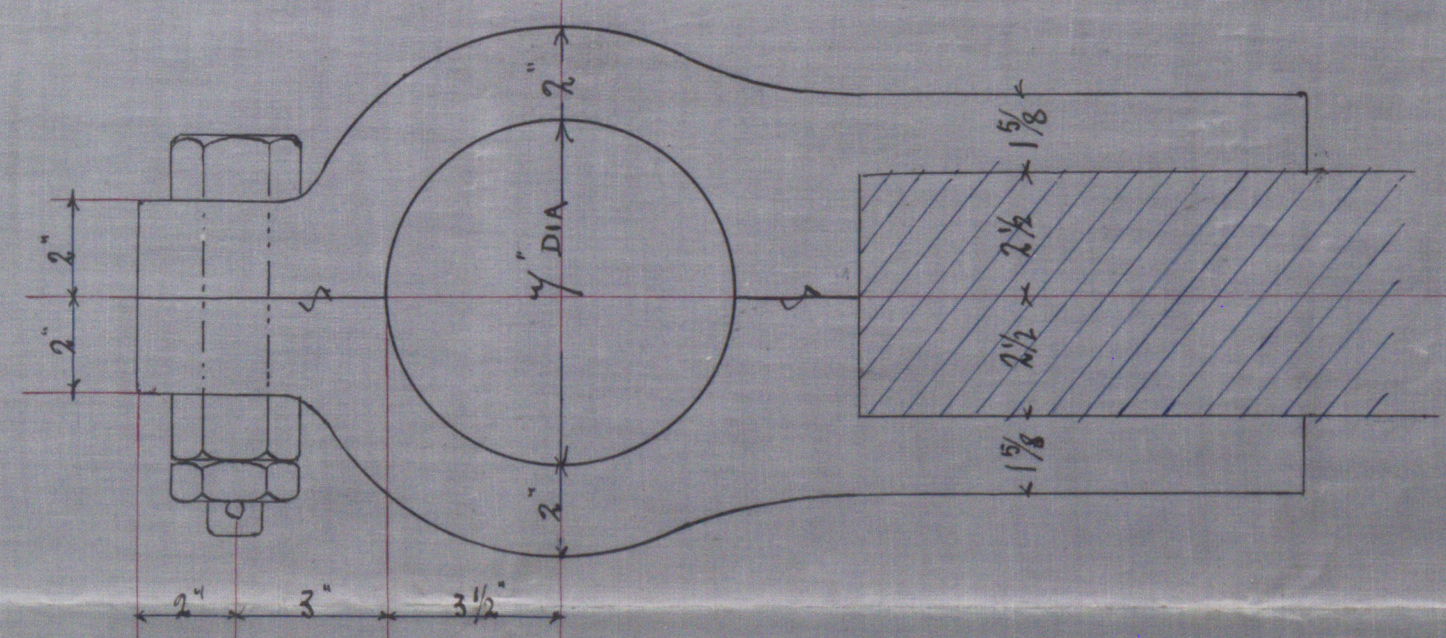

Sketches of attachments to Tent Kit to be submitted



— STERN POST + RUDDER —
— S S No 90 —
SCALE $\frac{3}{4}$ " = ONE FOOT

6th Feb. '97