
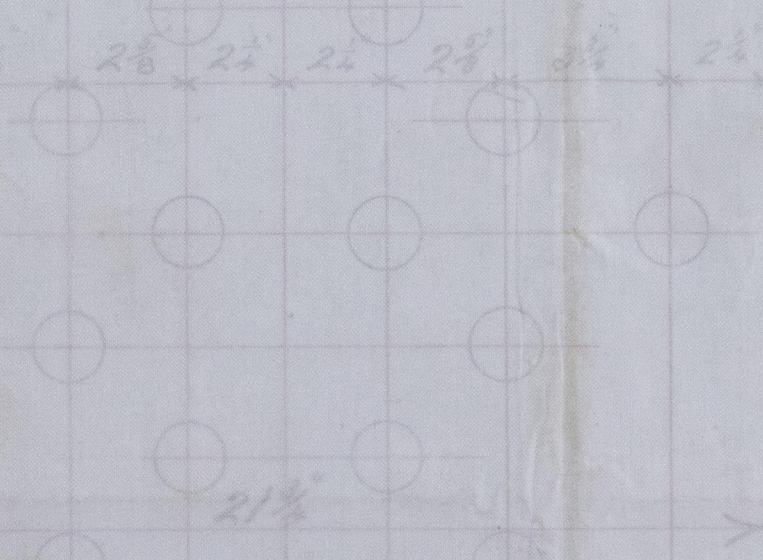


Amended Tracing
 Steel main boiler
 to be made by Messrs
 J. Scott & Co, for their
 No 99 vessel
180 lbs pressure
 18/11/96

Jaffs Ltd 81452

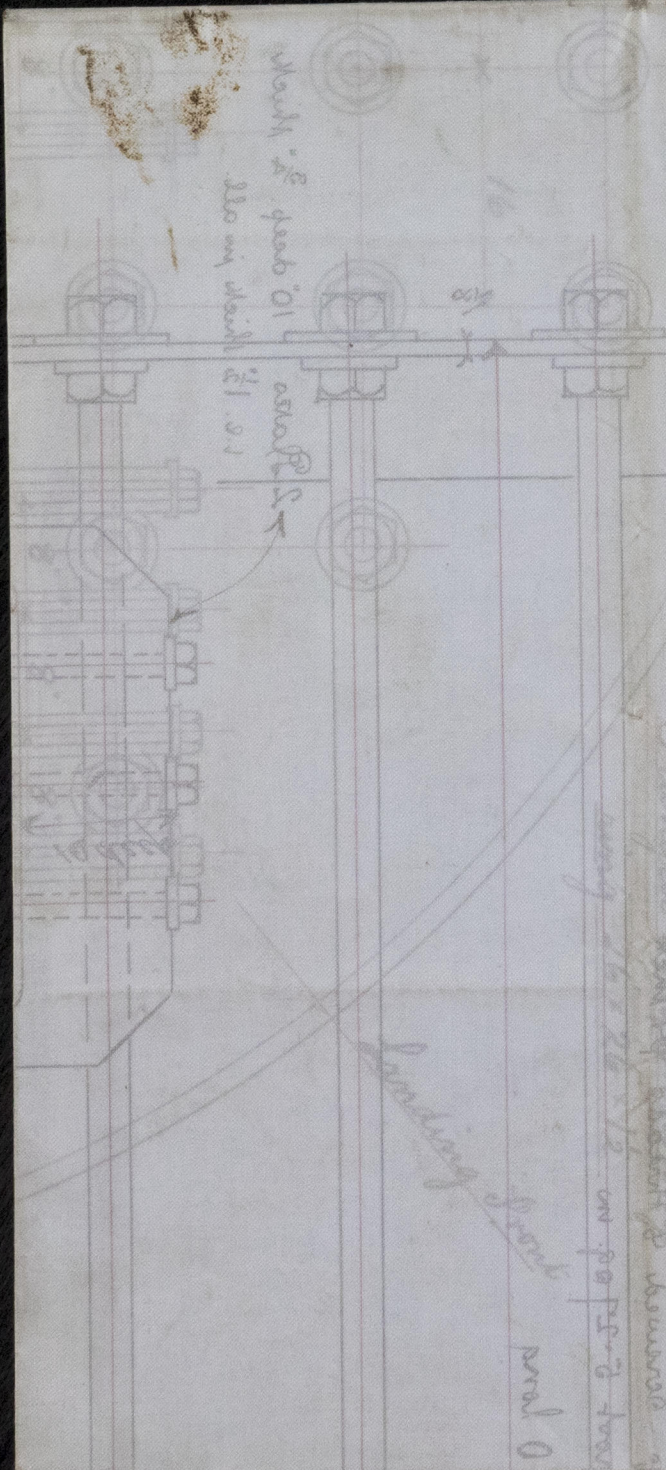

© 2019

Lloyd's Register
 Foundation

2410-995417

