


John Scott & Co. No 99

S. S. "Jaffa"

Approved Midship Section.

Lth. Rept. No 8452

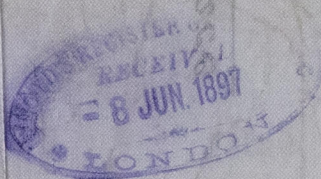



© 2019

Lloyd's Register  
Foundation

LTH566-0178



28. 10. 96  
15. 12. 96  
1. 2. 97  
9. 2. 97  
21. 5. 97

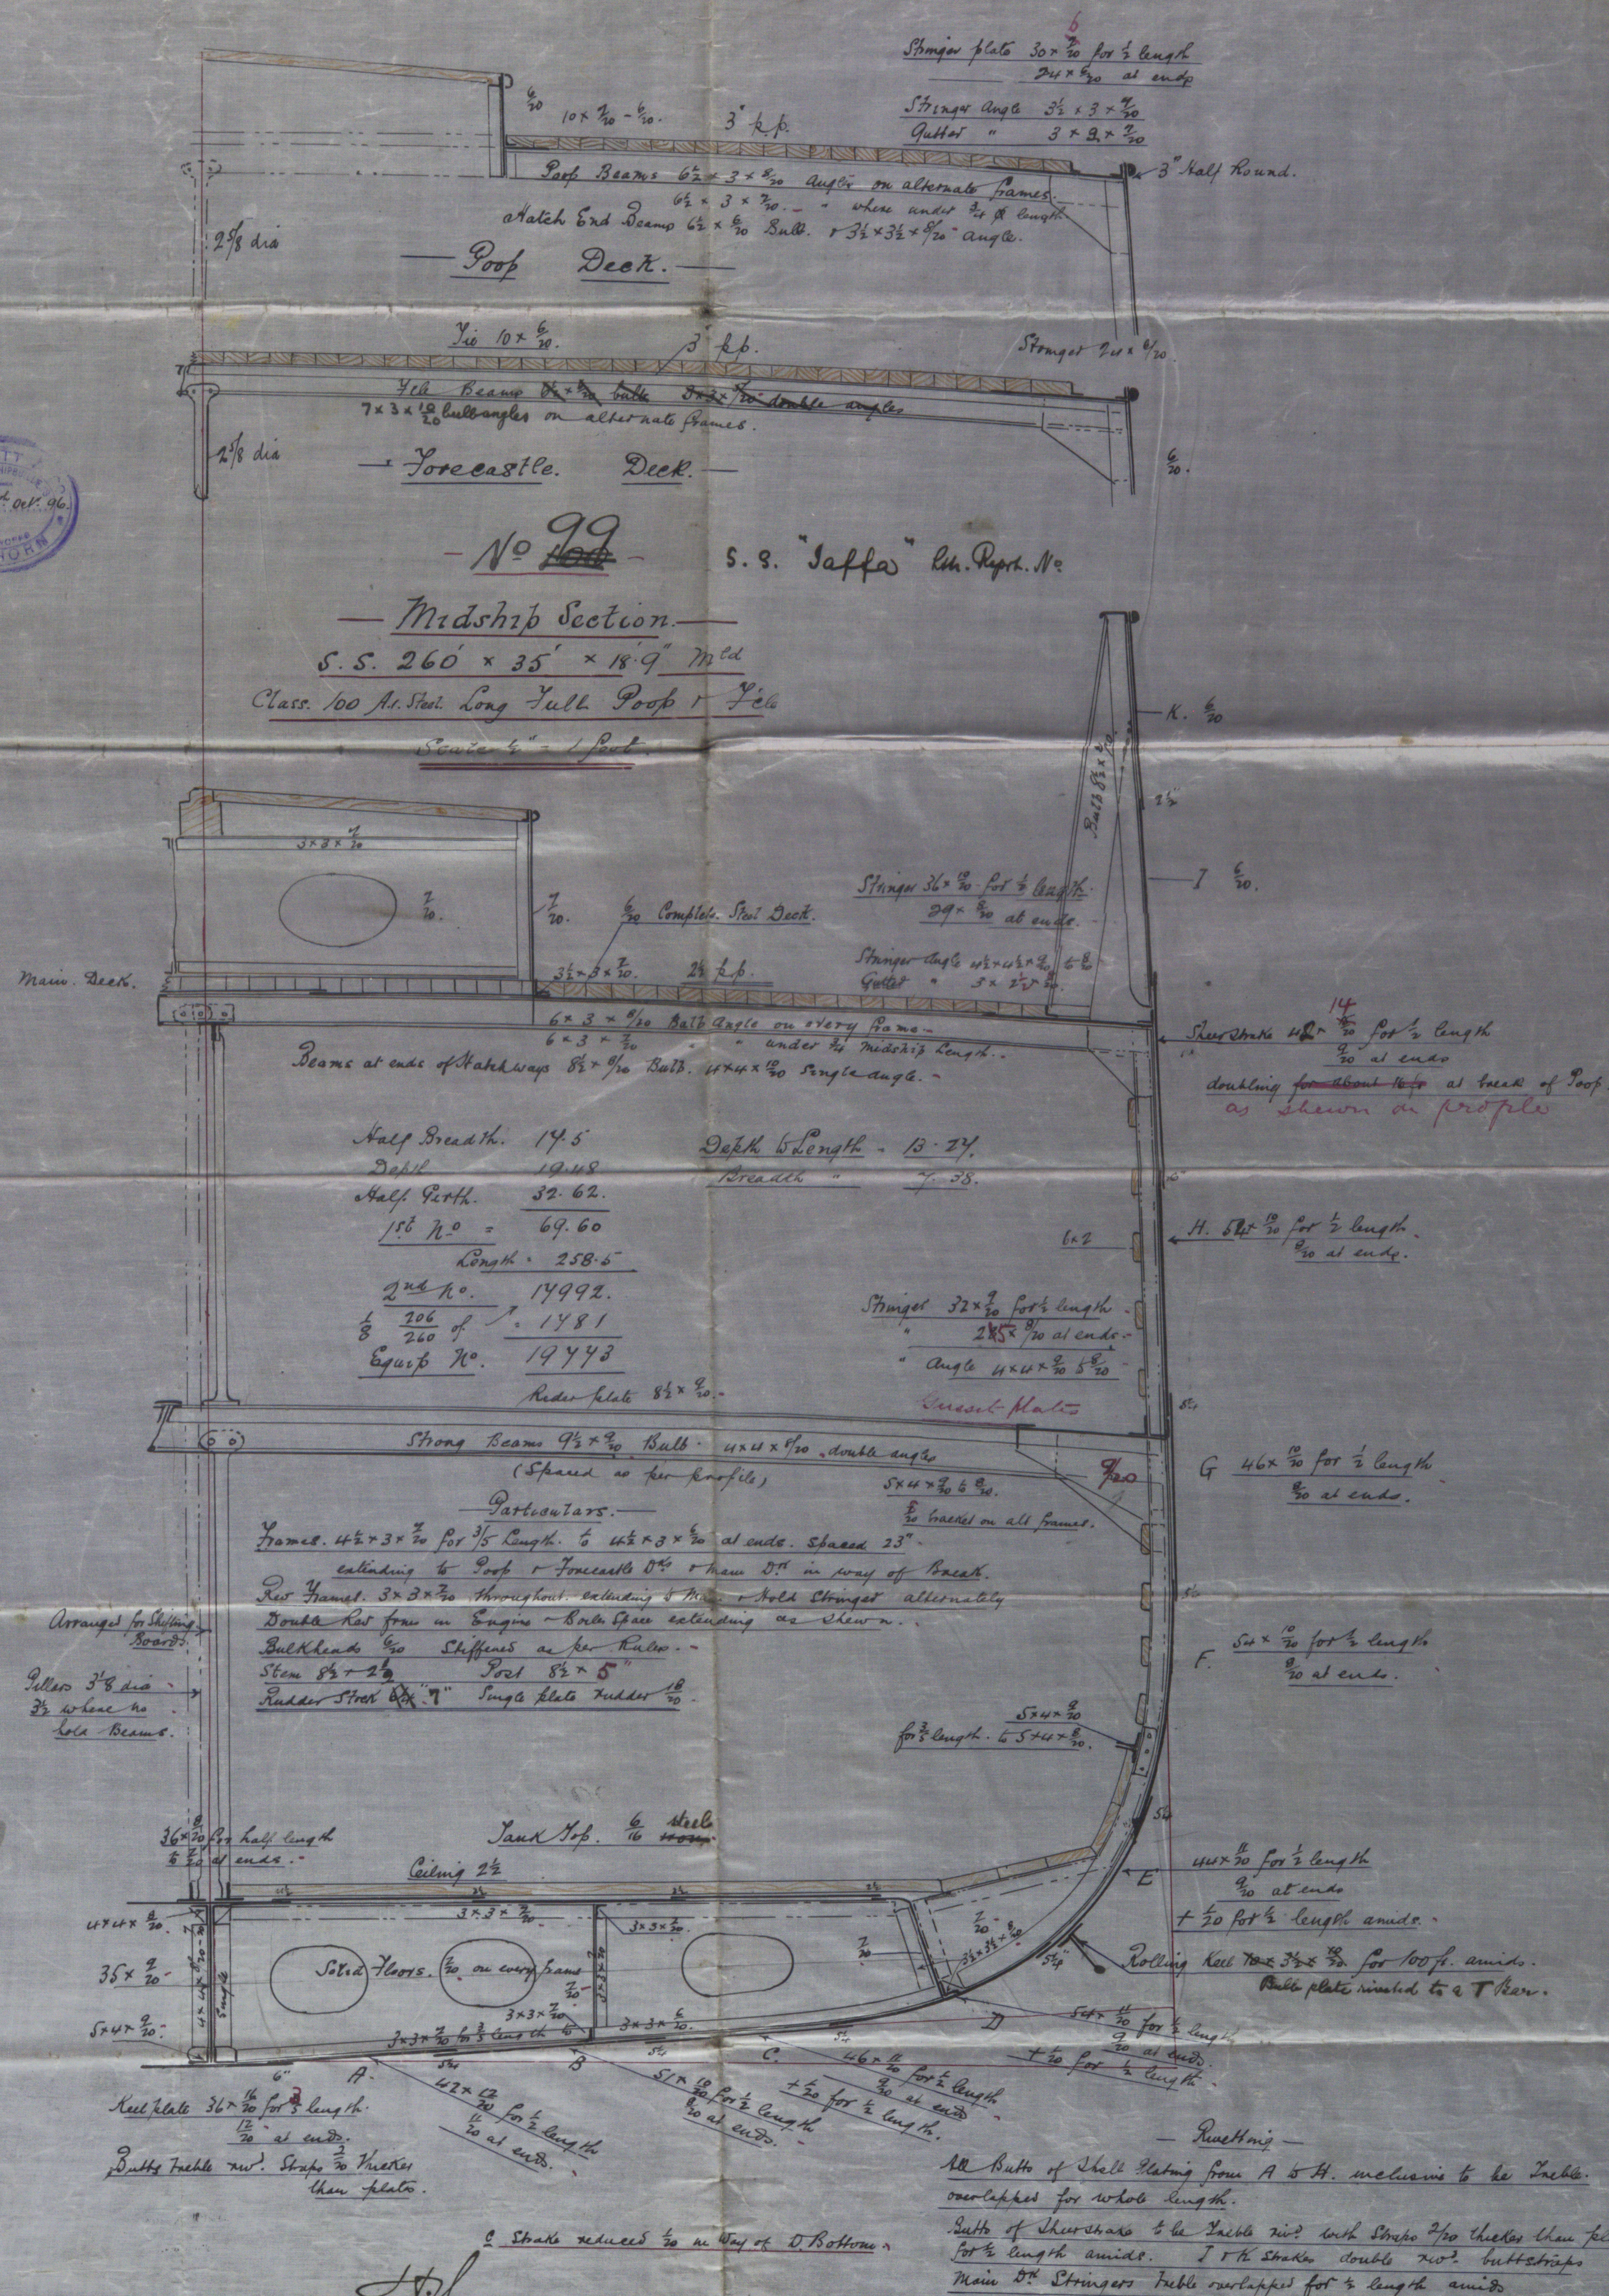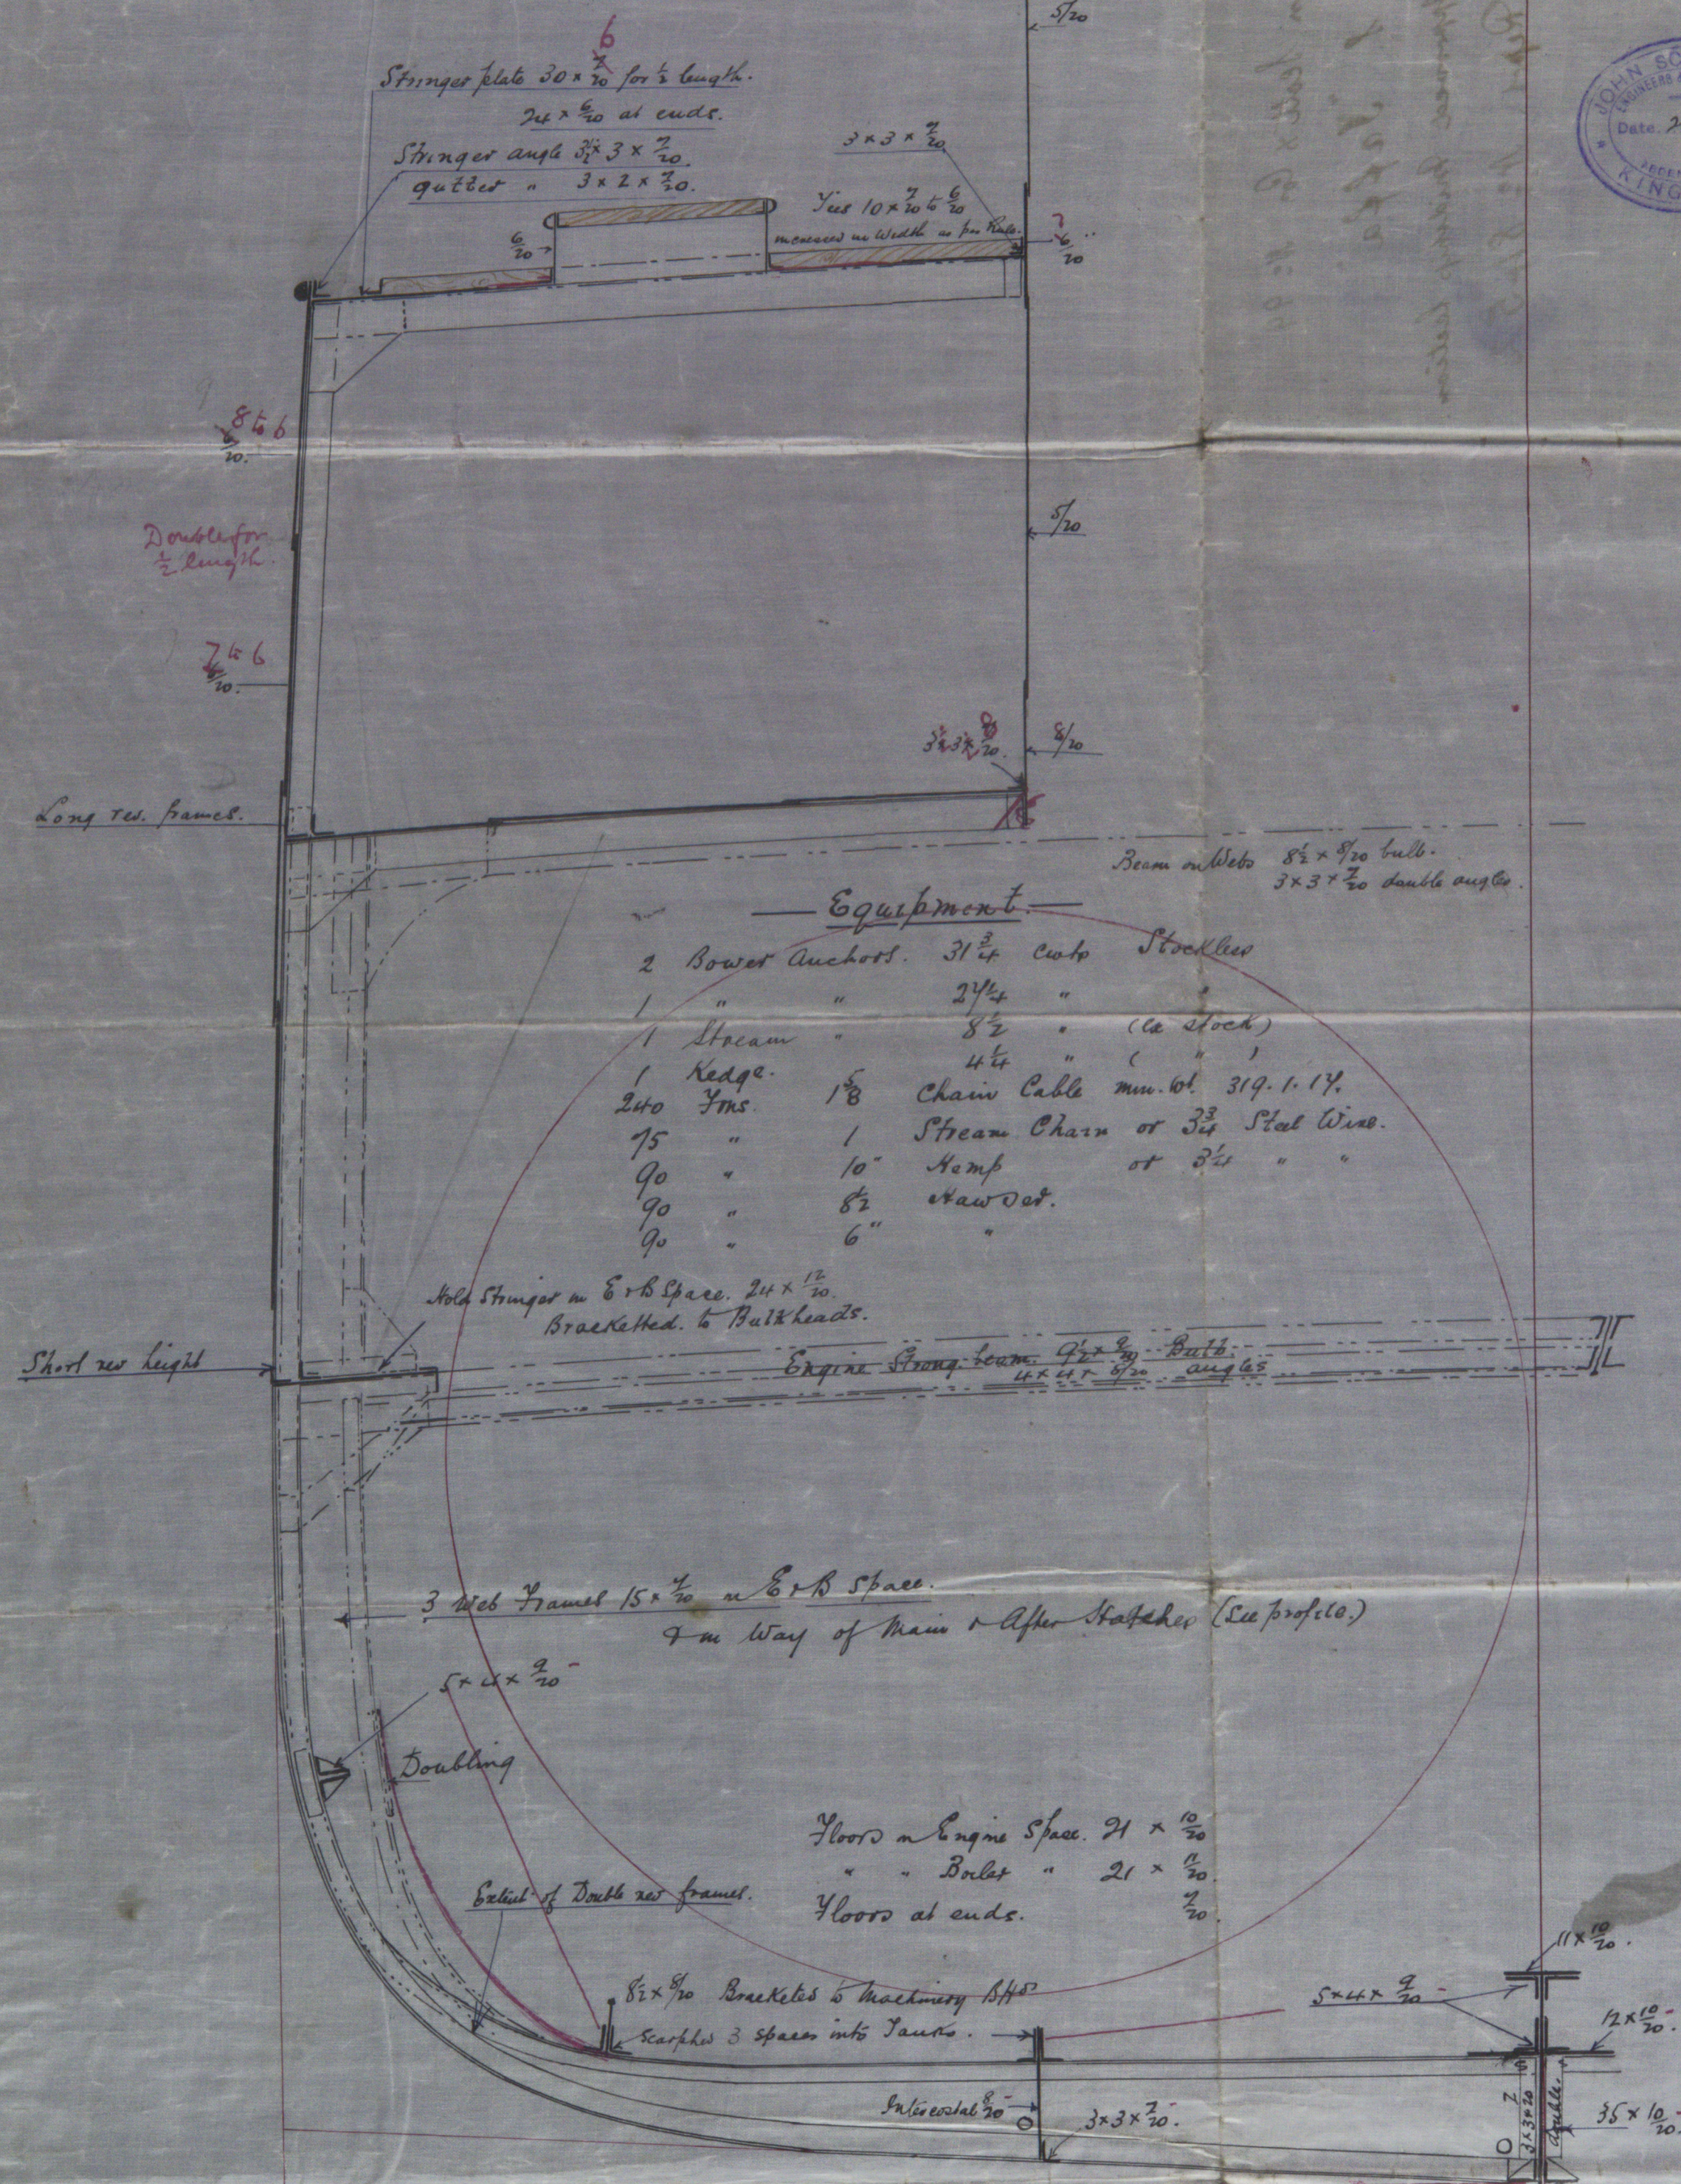

J.V.L.  
28/10/96

3044 Oct 15. 96  
21.9.