
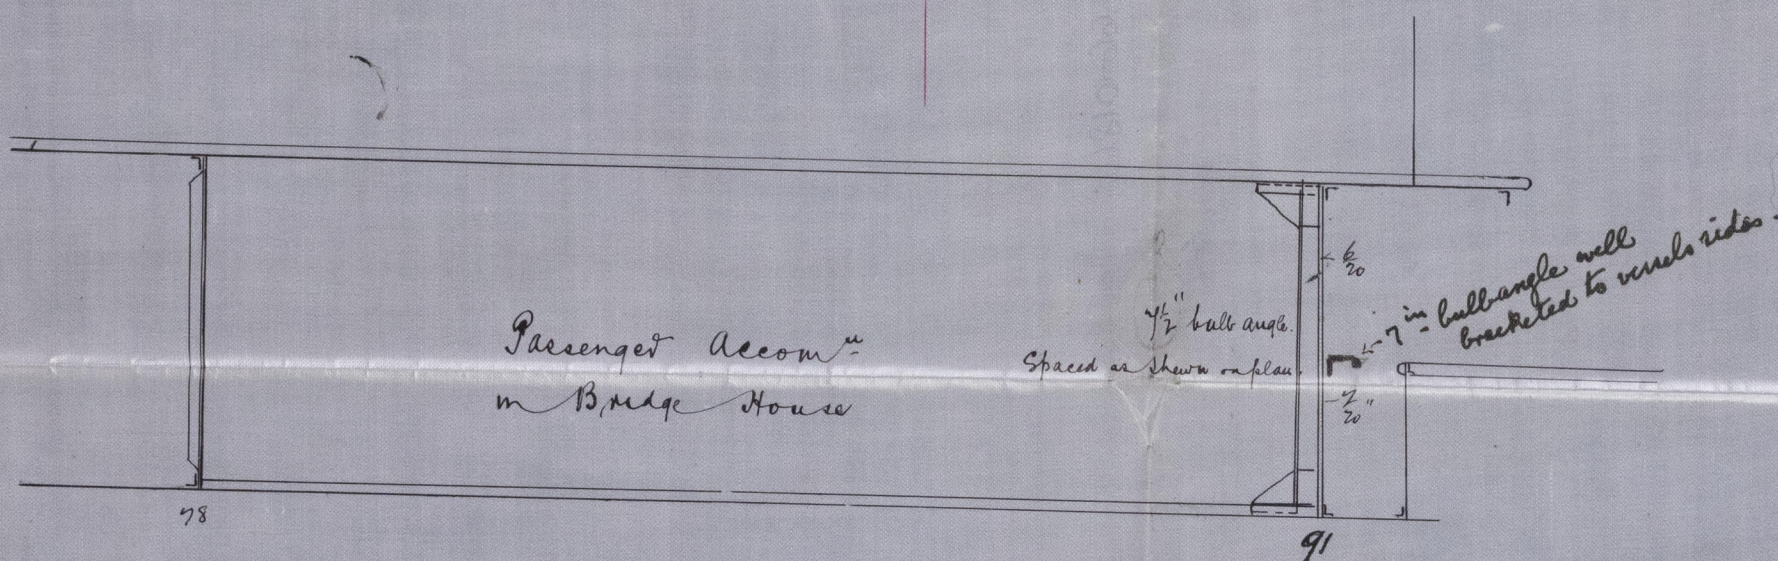
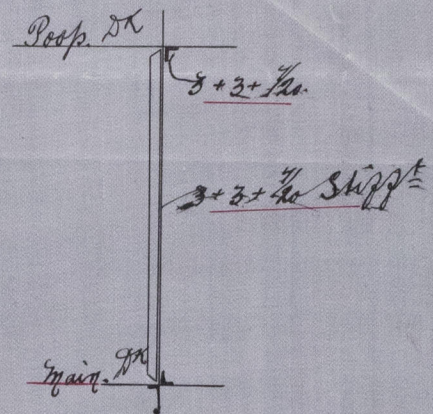


J. J. "Saffa"

Lth. Report. No 8452

See letter to  
Leith 21/5/97.

Bulkhead No 78 Frame.

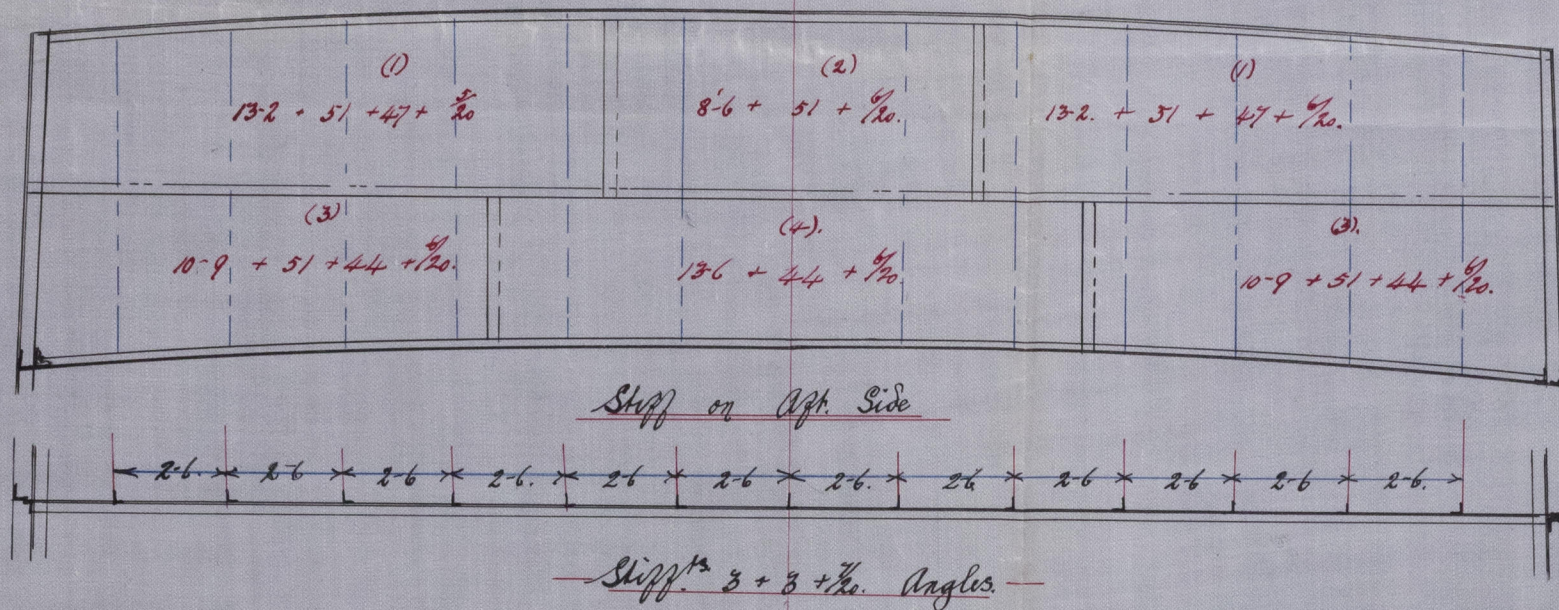




— Poop & Bridge Fronts

— SS No 99 —

— Scale  $\frac{1}{4}$ " = 1 foot. —



Bridge front on No 91 frame.

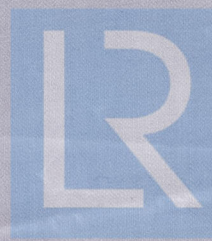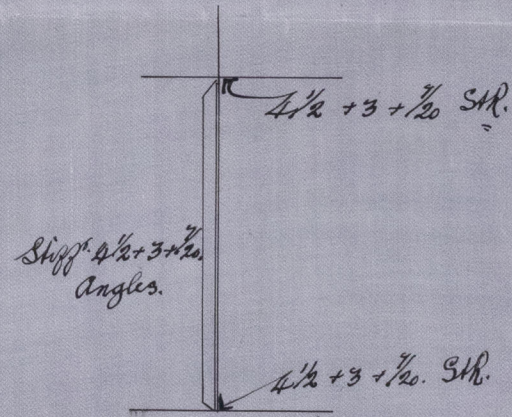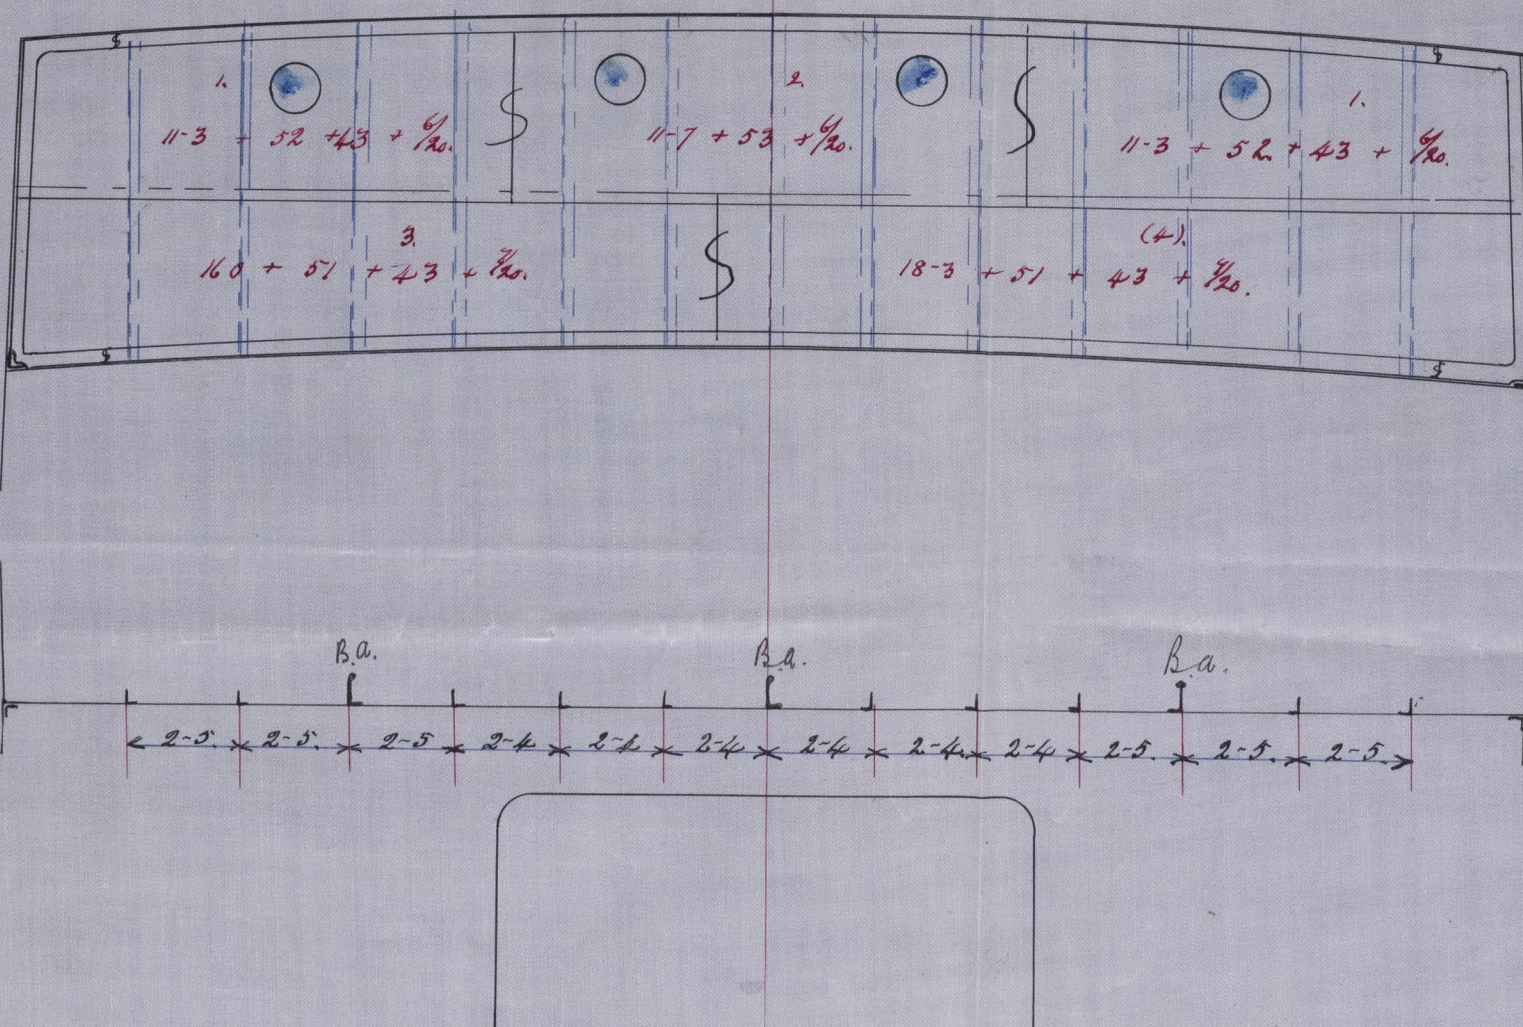

© 2019


Register  
Foundation  
LTH566-0181




Messrs. J. Holt & Co. L.L.N. 99

"Jaffa"

L.L. Report. N. 8452

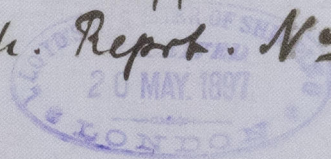

*Handwritten:* 7/1/97

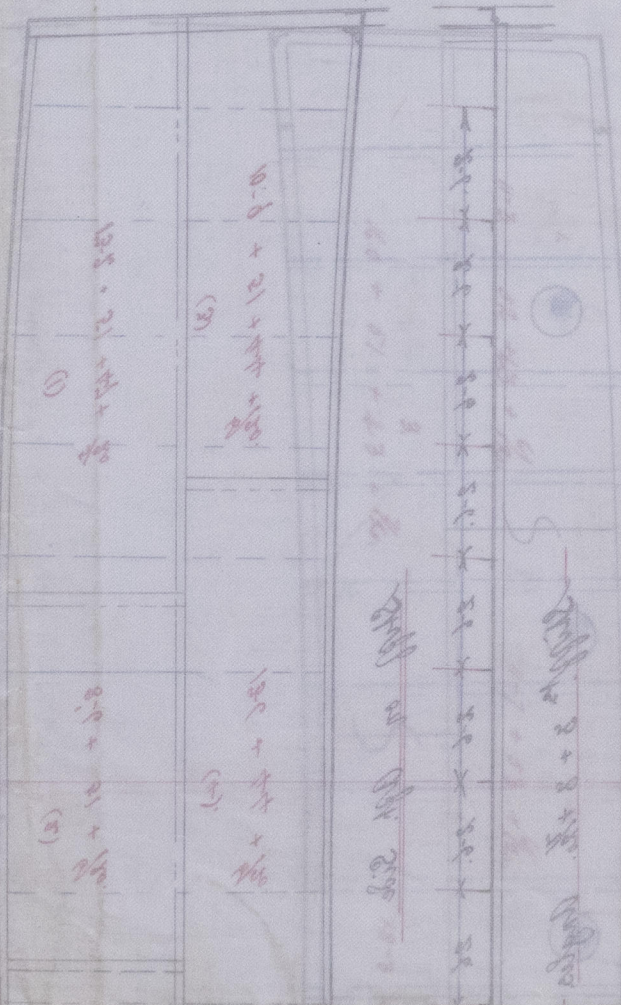

*Handwritten:* 87 2/3



© 2019

Lloyd's Register Foundation

LTH566-0181

*Handwritten:* 10/1/97