

Lloyd's Register of British and Foreign Shipping.

(Report on Vessel No. 8506 Port *Leith*)

No. 394 SHIP FORGINGS OR CASTINGS.

The words FORGINGS or CASTINGS, IRON or STEEL, should be struck out as may be required.

I have to report that the undermentioned Iron ~~or Steel~~ Forgings ~~or Castings~~, manufactured by *James Carmichael & Co. (Lim.)* of *Dundee* for the Vessel No. *24*, being built by *Cumming & Ellis* of *Inverkeithing* have been inspected by me as set forth below, and found to be, so far as can be seen, *sound*.


Mark on Forgings.

Lloyd's
No. *490*
JT

J. Thomson
Dundee

	STERN FRAME.	RUDDER FRAME.	STEM.
Material* ...	<i>Scrap Iron</i>	/	/
How made ...	<i>Forged</i>		
Dimensions ...	<i>6 1/2 x 3 1/2</i>		
Progress on Inspection ...	<i>Forging & finished.</i>		
Date when Inspected ...	<i>21st & 31st Oct. 1896</i>		

SKETCHES OF FRAMES SHOWING POSITION AND DESCRIPTION OF WELDS OF FORGINGS, OR PARTICULARS OF TESTS APPLIED TO CASTINGS.

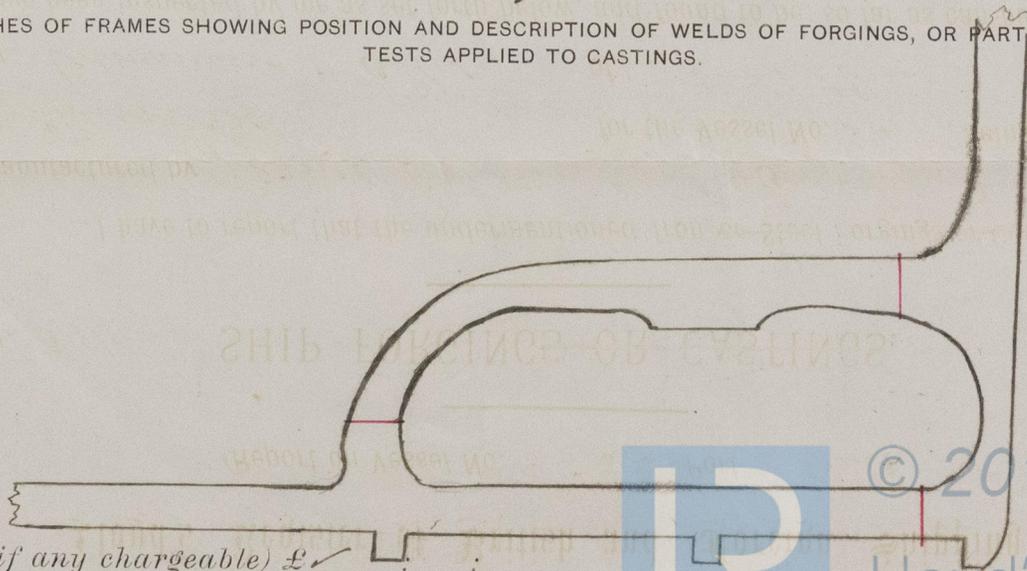

Fee (if any chargeable) £

To be paid at



© 2019

Lloyd's Register
Foundation

1. 1. "Marquerite Depeaux"

Lth. Repr. N^o: 8506



© 2019

Lloyd's Register
Foundation