

Lloyd's Register of British and Foreign Shipping.

(Report on Vessel No. 8506 Port Leith)

No. 396 SHIP FORGINGS OR CASTINGS.

The words FORGINGS or CASTINGS, IRON or STEEL, should be struck out as may be required.

I have to report that the undermentioned Iron ~~or Steel Forgings or Castings~~,
manufactured by *Jas. Carmichael & Co. (Lim.)*
of *Dunfermline* for the Vessel No. *24*, being built
by *Cumming & Ellis* of *Inverkeithing*
have been inspected by me as set forth below, and found to be, so far as can be seen,
sound.


Mark on Forgings.

Lloyd's
No. 496
J. T.


J. Thomson
Dunfermline

	STERN FRAME.	RUDDER FRAME.	STEM.
Material*	/	<i>Scrap Iron.</i>	/
How made		<i>Forged.</i>	
Dimensions		<i>Head 4 1/2. Steel 3 1/2 x 3.</i>	
Progress on Inspection		<i>Forging & finished.</i>	
Date when Inspected		<i>21st Oct. 17th Nov. 1896</i>	

SKETCHES OF FRAMES SHOWING POSITION AND DESCRIPTION OF WELDS OF FORGINGS, OR PARTICULARS OF TESTS APPLIED TO CASTINGS.

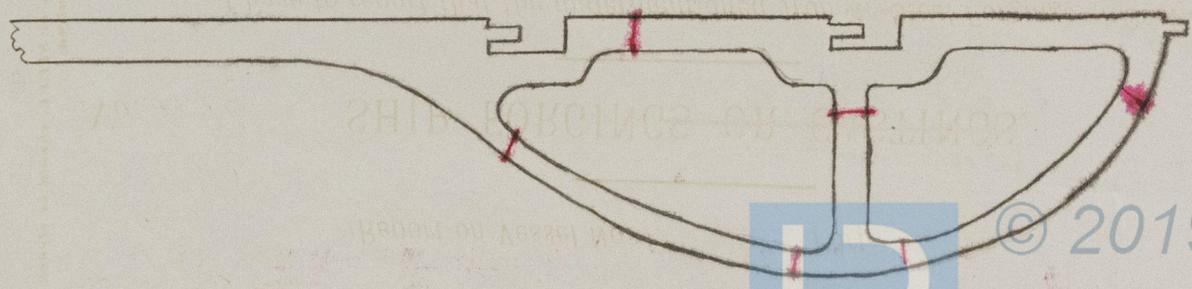

Fee (if any chargeable) £ : :
To be paid at

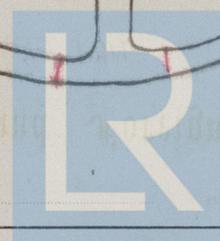

© 2019
Lloyd's Register
Foundation

* If of Iron, state whether scrap or puddled Iron.

1. 1. "Marguerite Depeaux"

Lth. Rept. N^o 8506



© 2019

Lloyd's Register
Foundation