

MON 22 NOV 1897

Lloyd's Register of British and Foreign Shipping.

(Report on Vessel No. 8565 Port Leith)

No. 5871

SHIP FORGINGS OR CASTINGS.

The words FORGINGS or CASTINGS, IRON or STEEL, should be struck out as may be required.

I have to report that the undermentioned Iron ~~or Steel~~ Forgings ~~or Castings~~,
 manufactured by Messrs. Robt. Kerr & Sons.
 of Irvine. for the Vessel No. 190, being built
 by The Grangemouth Dockyard Co. of Grangemouth.
 have been inspected by me as set forth below, and found to be, so far as can be seen,
Sound.

Mark on Forgings.


Lloyd's
 No. 5871
 F.C

Frank Cook.

Glasgow.
3/8/97

	STERN FRAME.	RUDDER FRAME.	STEM.
Material*	<u>Scrap Iron.</u>		
How made	<u>Forged.</u>		
Dimensions	<u>6x3"</u>		
Progress on Inspection	<u>Forged & omitted</u>		
Date when Inspected	<u>6.9.19.21.26.27/4/97</u>		


SKETCHES OF FRAMES SHOWING POSITION AND DESCRIPTION OF WELDS OF FORGINGS, OR PARTICULARS OF TESTS APPLIED TO CASTINGS.

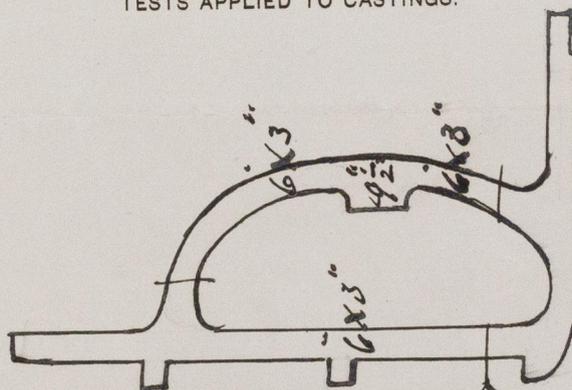

Fee (if any chargeable) £ : :

To be paid at _____

* If of Iron, state whether scrap or puddled Iron.

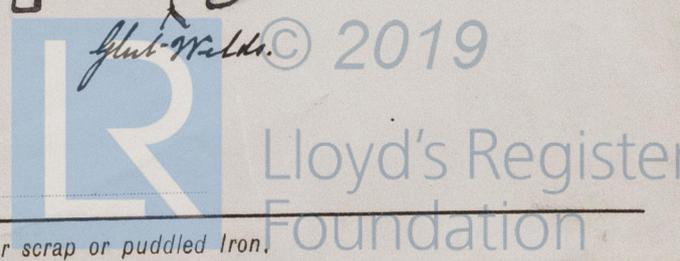

SHIP FORGING OR CASTING

SHIP FORGING OR CASTING




Hand made



© 2019

Lloyd's Register Foundation