
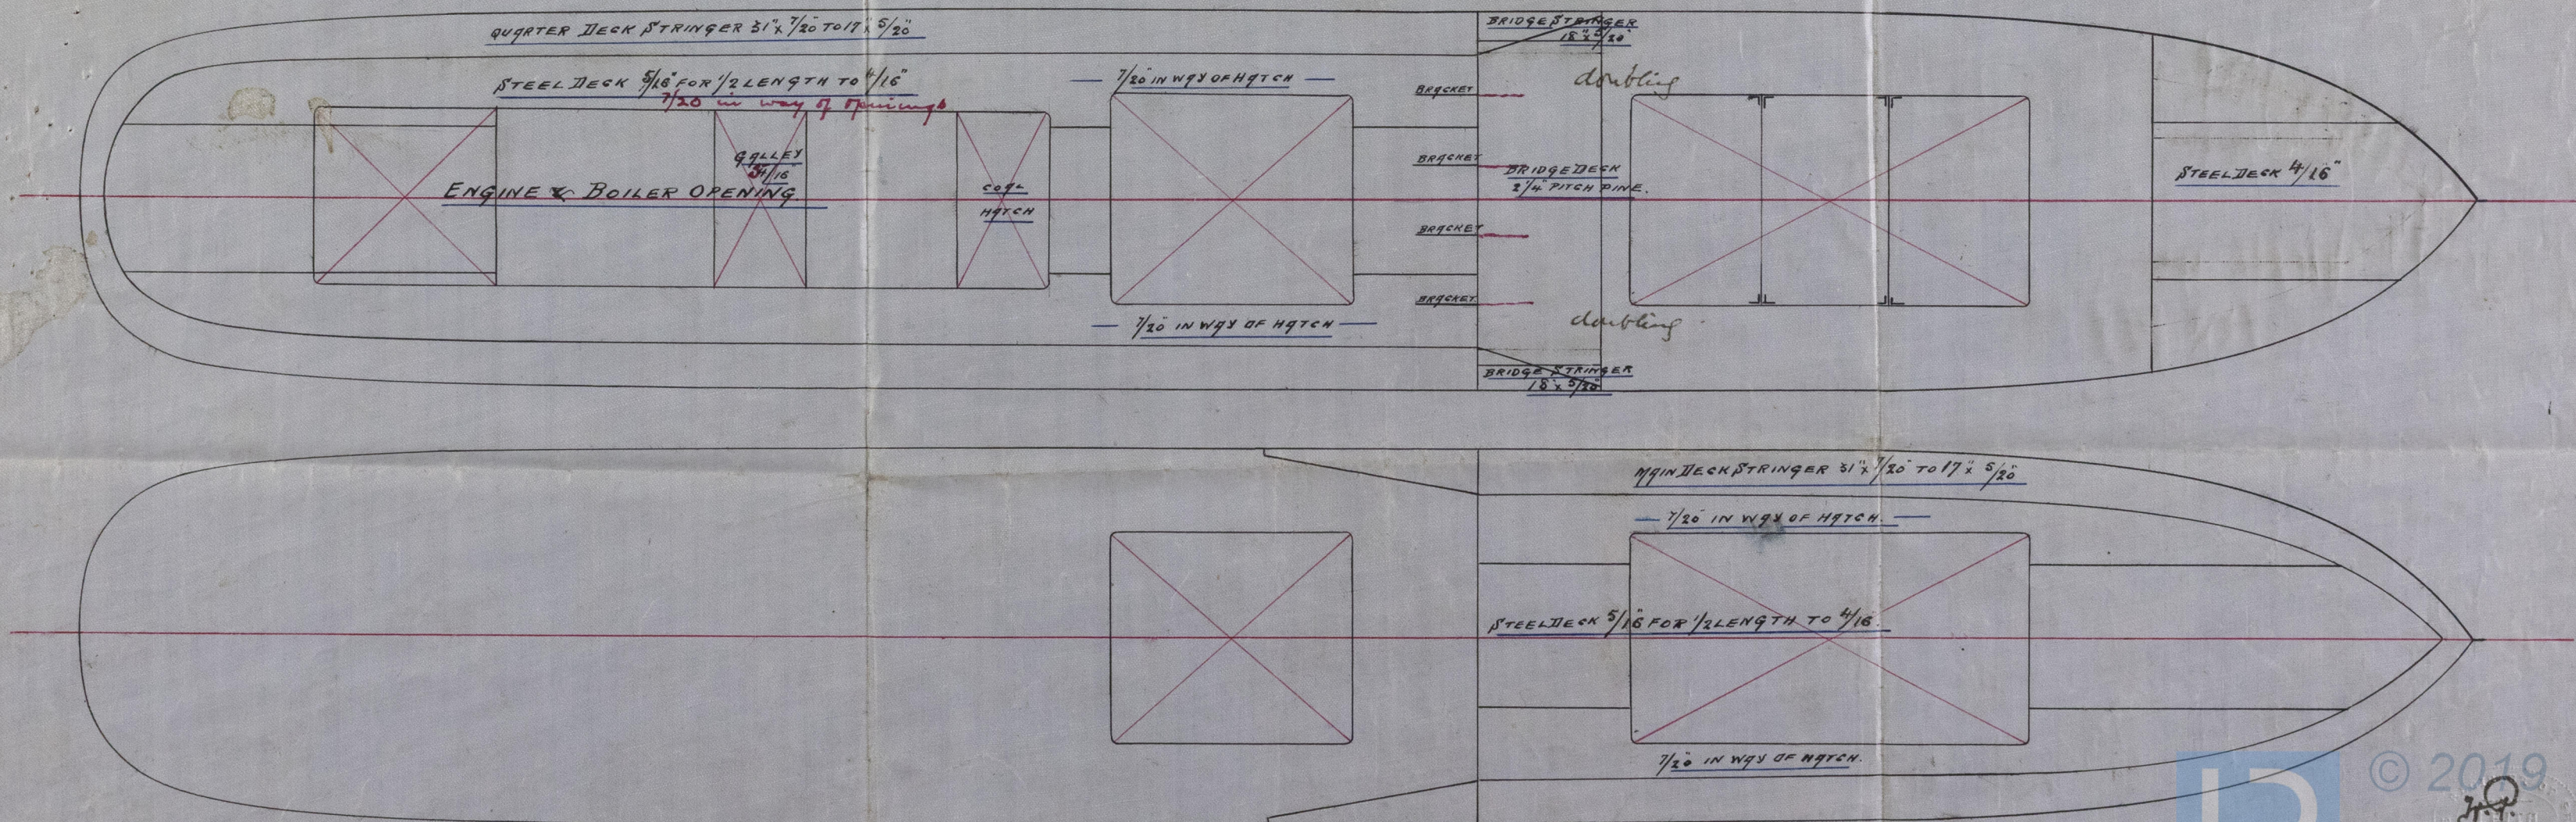
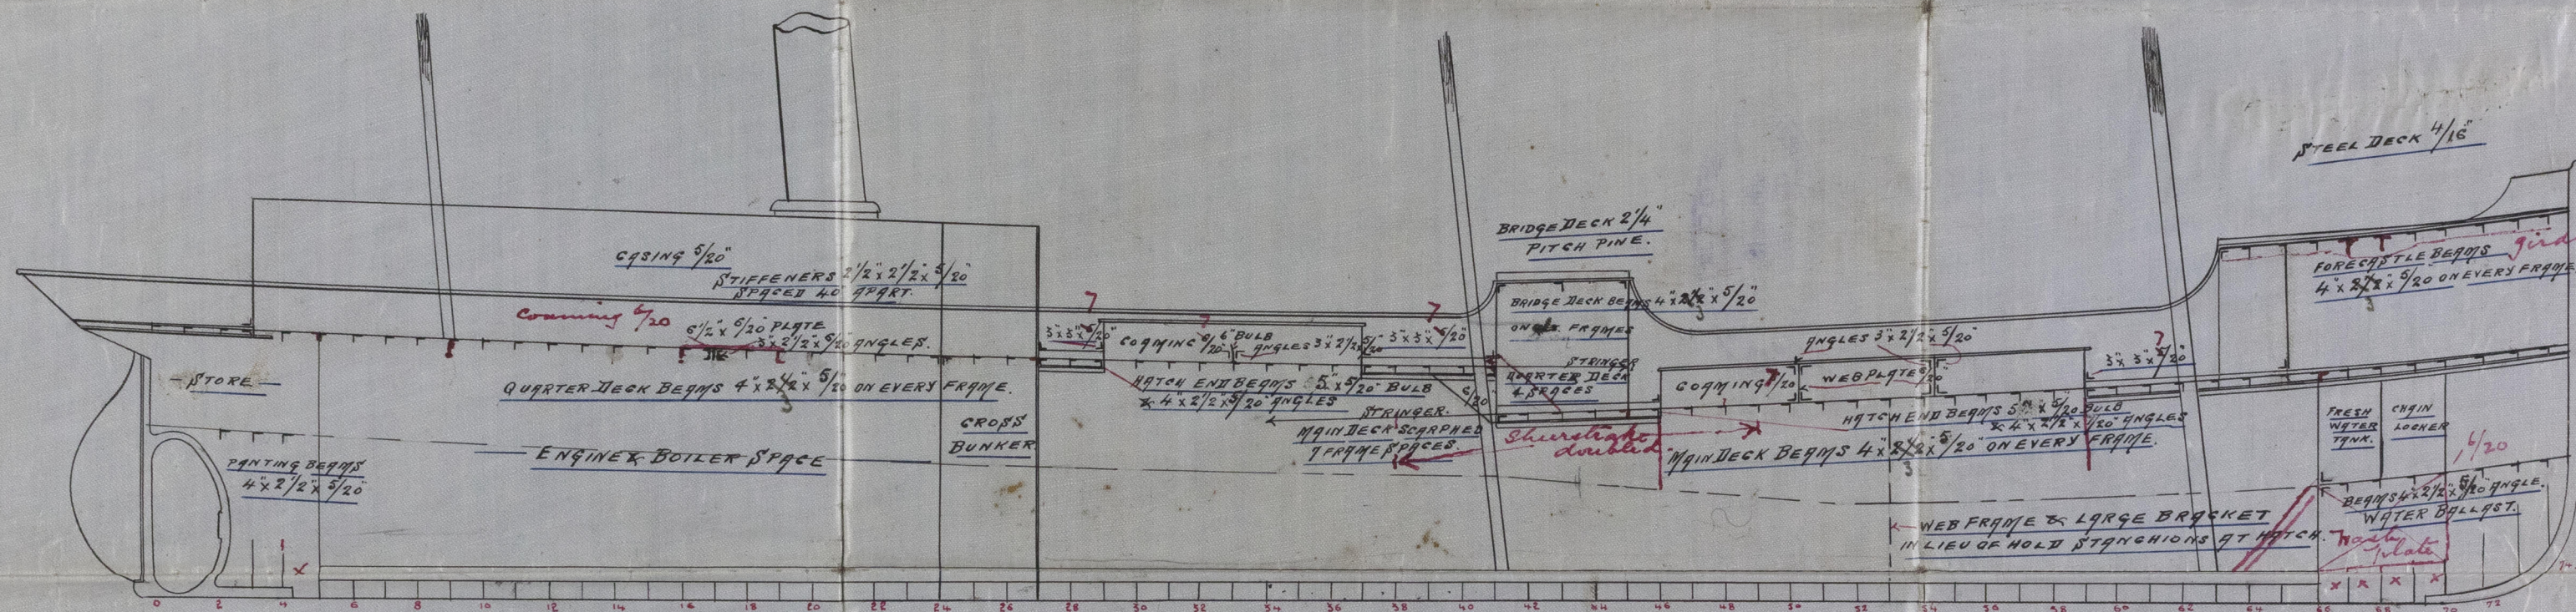


Lth. Report. No. 8565

SCALE 1/8" = ONE FOOT.

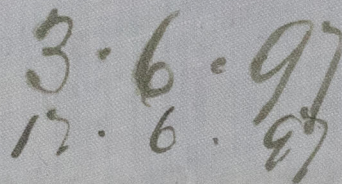

Smith. Skypd. Co. l. l. N^o 190

"Humber"

Profile

Lth. Rept. N^o 8565



LLOYD'S REGISTER OF SHIPPING



© 2019

Lloyd's Register
Foundation

LTH566-0236