

17/9/97


STEEL SCREW STEAMER N° 190

DIMENSIONS 130' x 22'-3" x 9'-11" ML^D

SCALE 1/2" = ONE FOOT

TO CLASS 100.A. AT LLOYDS

"Humber" Lth. Repd. N°

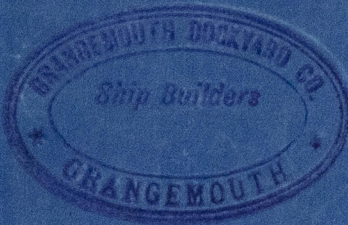

NUMERALS

1/2 GIRTH 19.16

1/2 BREADTH 11.12

DEPTH 10.34


$$40.65 \times 129 = 5243.85$$

F.N. P.N.

PROPORTIONS

BREADTHS IN LENGTH 5.79

DEPTHS IN LENGTH 12.43

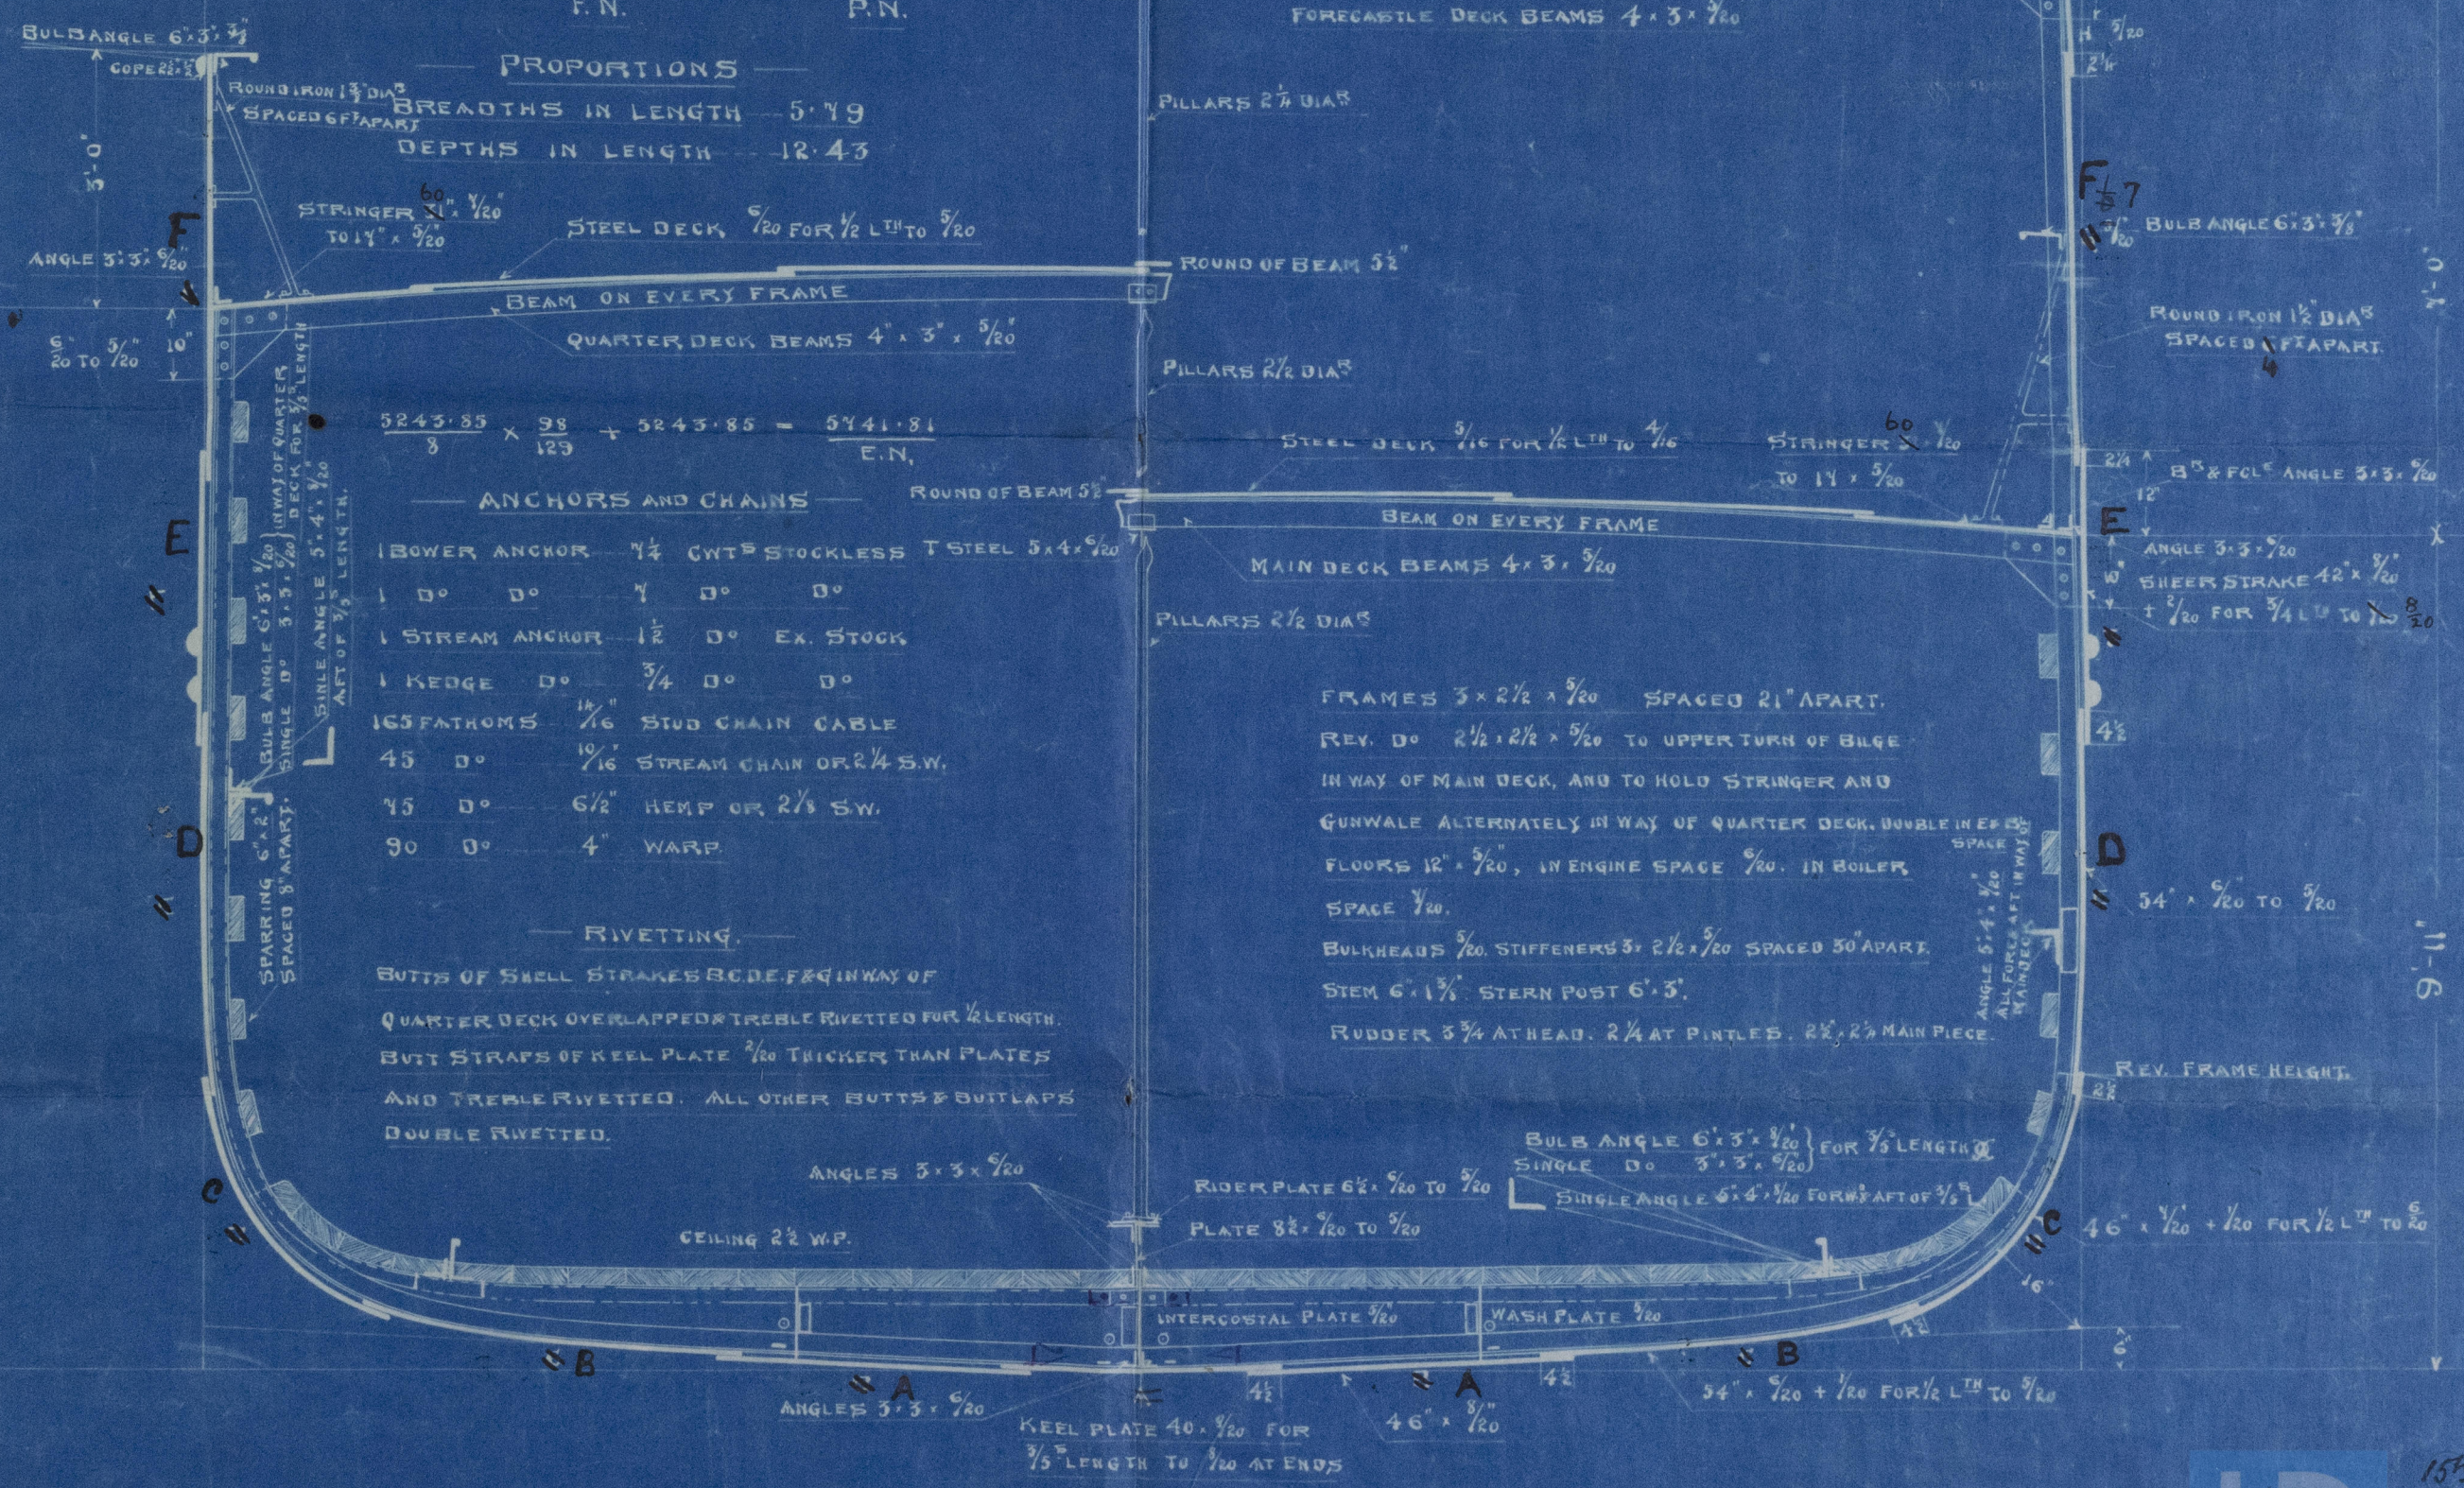

ANCHORS AND CHAINS


- 1 BOWER ANCHOR 7 1/2 CWT STOCKLESS T STEEL 5 x 4 x 5/20
- 1 DO DO 7 DO DO
- 1 STREAM ANCHOR 1 1/2 DO EX. STOCK
- 1 KEDGE DO 3/4 DO DO
- 163 FATHOMS 1 1/2\"/>
- 45 DO 10\"/>
- 75 DO 6\"/>
- 90 DO 4\"/>

RIVETTING

BUTTS OF SHELL STRAKES B, C, D, E & G IN WAY OF QUARTER DECK OVERLAPPED TREBLE RIVETTED FOR 1/2 LENGTH. BUTT STRAPS OF KEEL PLATE 1/20 THICKER THAN PLATES AND TREBLE RIVETTED. ALL OTHER BUTTS & BUTLAPS DOUBLE RIVETTED.

FRAMES 3 x 2 1/2 x 5/20 SPACED 21\"/>

15th Sept 97
Lloyd's Register
Foundation

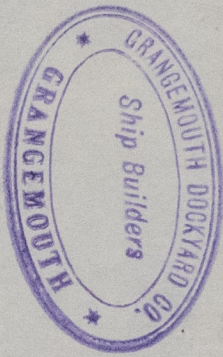


Smith. Plyd. Co. S. S. No 190

"Humber"

2th. Report No

Midship section showing altered
breadth of shell plating.

Rth. 8575

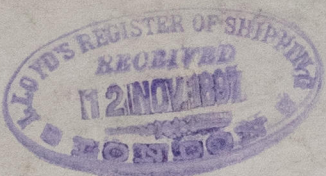

© 2019

Lloyd's Register
Foundation

LTH566-0237

14th Sept.

1894

GRANGEMOUTH DOCKYARD CO.,
GRANGEMOUTH AND ALLOA

This Enclosure is to be Sent to

Wm Paulsen Esq
Leith

~~Ships No.~~

Tracing No. 146.

LTH566-0237(1/2)

119197