


Ramage & Ferg. (Lein?)

S. I. No 153 "Ronan"


Leith Rept. 8648

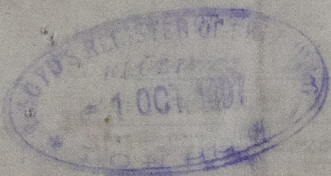

LTH567-0037

No 153

Ramage & Ferguson

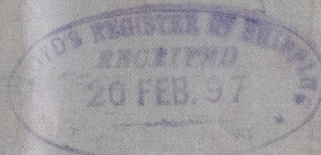

© 2019

Lloyd's Register Foundation



# MIDSHIP SECTION OF S.S. N° 153 "Ronan"

SCALE 1/2 INCH = 1 FOOT

See. Repr. N°

DIMENSIONS 259'-0" B.P. x 33'-9" x 18'-9" MOULDED

TO CLASS 100 A.1 AT LLOYDS. STEEL.

## NOTE

PROPOSED COMPENSATION FOR SHORTNESS

### OF BRIDGE

SHEER STRAKE DOUBLING TO BE CARRIED TO TOP OF SHEERSTAKE AND TO EXTEND FOR 3/4 L. SHEERSTAKE INCREASED 1/20 FOR 1/2 L. MAIN DECK STRINGER INCREASED 1/20 FOR 1/2 L.

### ERECTOR'S

POOP	3L
BRIDGE	37.6
FORECASTLE	33
18L-6 =	148

$$17896.6 + (.48 \text{ or } \frac{1}{2} \text{ of } 17896.6) = 18970 \text{ EQUIP. N°}$$

### EQUIPMENT


1 <sup>st</sup> BOW	STOCKLESS ANCHOR	3 1/2 CWT
2 <sup>nd</sup> "	"	30 "
3 <sup>rd</sup> "	"	29 "
1 <sup>st</sup> STEAM	EX STOCK	8 1/2 "
1 KEDGE	"	1 1/2 "
240 FATHOMS	1 1/2" STD CHAIN CABLE	10' 1/2" 1/2" 1/2"
75	1" STEAM CHAIN	"
90	10" MEDIUM ROLLING	"
90	8 1/2" MANROPE	"
90	6" WARP	"

### NUMERALS

1/2 GIRTH	=	33.16
1/2 BREADTH	=	16.87
DEPTH	=	19.45
		69.48 1 <sup>st</sup> N°
		207.53
		17896.65 2 <sup>nd</sup> N°

PROPORTIONS	
BREADTHS IN LENGTH	7.63
DEPTHS IN "	13.29

RAIL 7.13

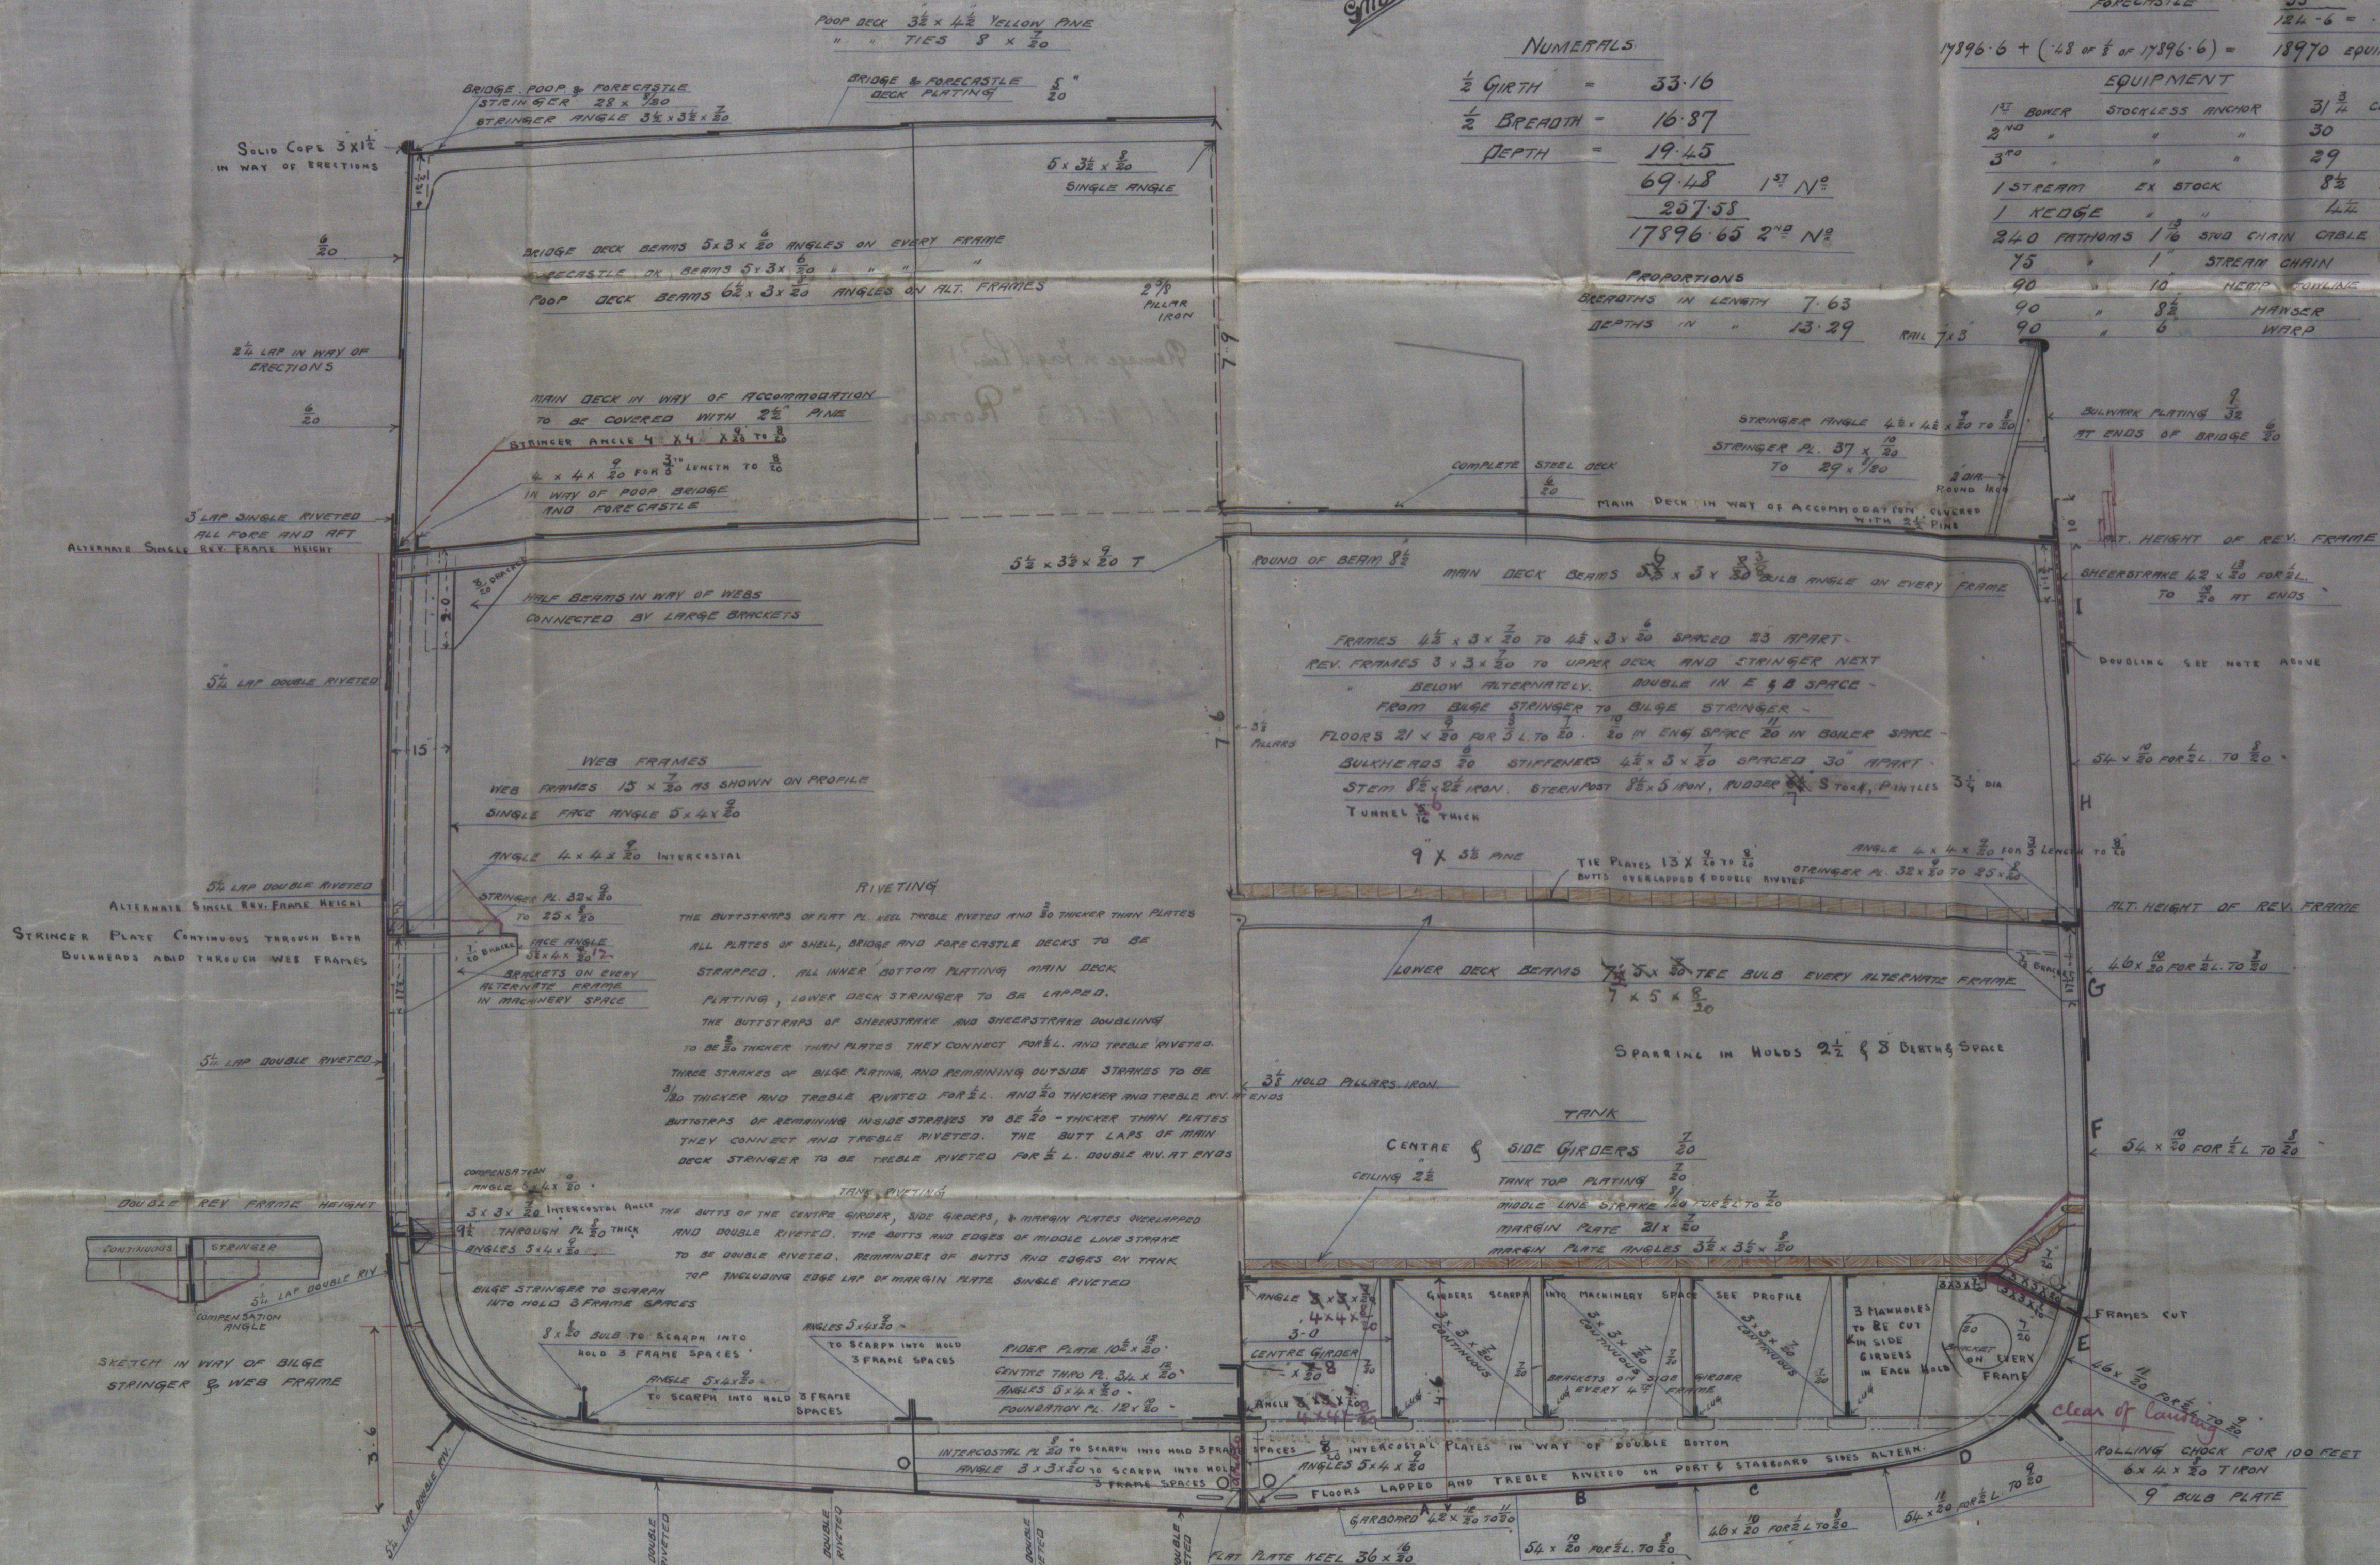

## SECTION IN WAY OF MACHINERY

## SECTION IN WAY OF HOLD

RUDDER STOCK	72"
EXTREME WIDTH OF RUDDER	72"
MEAN	53"
SPEED	12 KNOTS
DEPTH OF IMMERSED PART OF RUDDER	15'-0"

194 Feb 97

LTH567-00370 2017