

Lloyd's Register of British and Foreign Shipping.

(Report on Vessel No. 8678 Port Leith)

Leith

No. 3559a

SHIP FORGINGS OR CASTINGS.

I have to report that the undermentioned Iron ~~or Steel~~ Forgings ~~or Castings~~,
 manufactured by The Dalington Forge Co.
 of Dalington for the Vessel No. 158, being built
 by Messrs Ramsay & Ferguson of Leith
 have been inspected by me as set forth below, and found to be, so far as can be seen,
sound.

Mark on Forgings.

Lloyd's

No. 3559a


No. 6.

Mugh Cameron

Sunderland
30. 9. 97

	STERN FRAME.	RUDDER FRAME.	STEM.
Material*	<u>Scrap</u>	<u>Scrap</u>	<u>Scrap</u>
How made	<u>Forged</u>	<u>Forged</u>	<u>Forged</u>
Dimensions	<u>8 1/2 x 5"</u>	<u>7-3/4"</u>	<u>8 1/2 x 2 1/2"</u>
Progress on Inspection	<u>Forged & Smithed</u>	<u>Forged & Smithed</u>	<u>Forged</u>
Date when Inspected	<u>March 16th to April 29/97</u>	<u>July 2nd to Aug 27/97</u>	<u>April 15/97</u>

SKETCHES OF FRAMES SHOWING POSITION AND DESCRIPTION OF WELDS OF FORGINGS, OR PARTICULARS OF TESTS APPLIED TO CASTINGS.

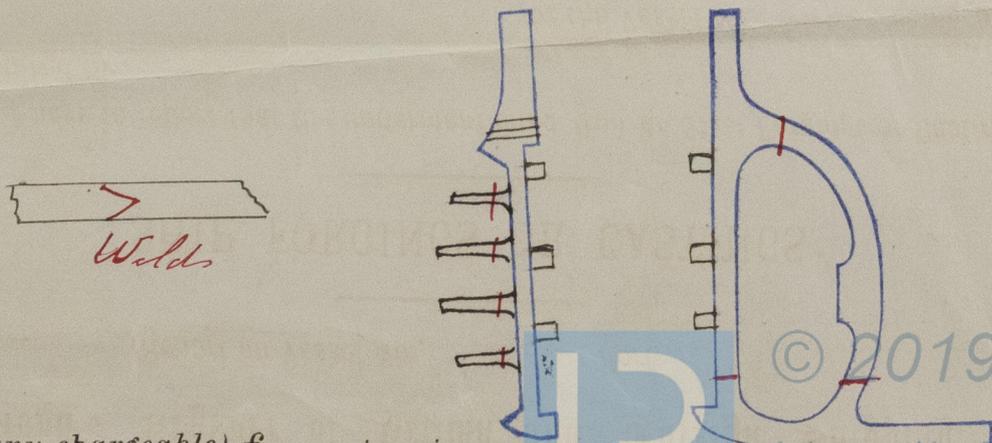

Fee (if any chargeable) £ : :

To be paid at _____

* If of Iron, state whether scrap or puddled Iron.

Ramageson Ferguson (him)

l. l. N: 153 "Roman"

Uth. Rept N: 8678.



© 2019

Lloyd's Register
Foundation