

## Lloyd's Register of British and Foreign Shipping.

(Report on Vessel No. 8728 Port *Leith*)

No. 519.

SHIP FORGINGS ~~OR CASTINGS~~.

I have to report that the undermentioned Iron ~~or Steel~~ Forgings ~~or Castings~~,  
 manufactured by *Messrs Jas Carmichael & Co*  
 of *Dunfermline* for the Vessel No. 157, being built  
 by *Messrs Ramsay & Ferguson* of *Leith*  
 have been inspected by me as set forth below, and found to be, so far as can be seen,  
*sound and good*

Mark on Forgings.

Lloyd's


No. 563

WM-261.98

*W. Morrison*  
*Dunfermline*

	STERN FRAME.	RUDDER FRAME.	STEM.
Material*		<i>Scrap iron</i>	
How made		<i>Forged</i>	
Dimensions		<i>5 1/8" beam head</i>	
Progress on Inspection		<i>Forged in the rough</i>	
Date when Inspected		<i>and finished</i>	
		<i>25<sup>th</sup> &amp; 26<sup>th</sup> Jan 1888</i>	

SKETCHES OF FRAMES SHOWING POSITION AND DESCRIPTION OF WELDS OF FORGINGS, OR PARTICULARS OF  
 TESTS APPLIED TO CASTINGS.

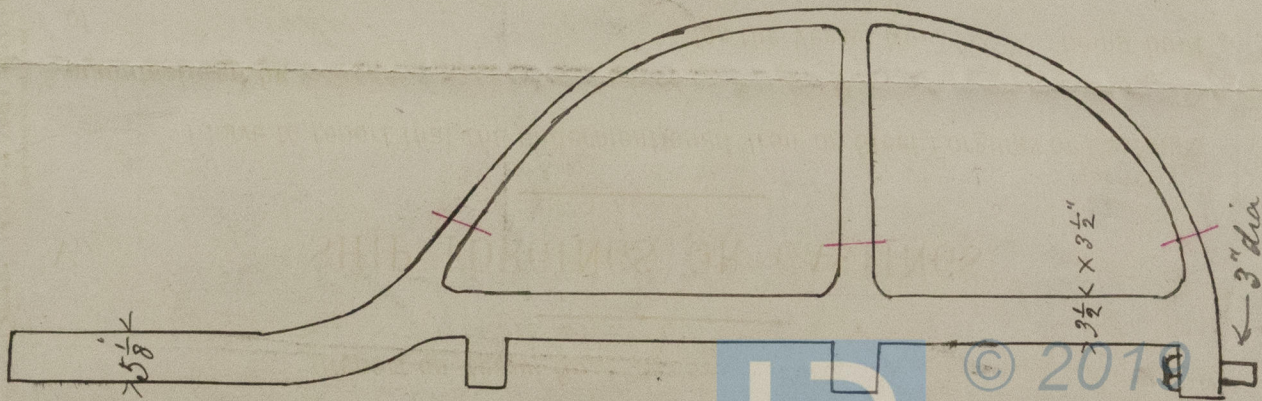

Fee (if any chargeable) £ : : :

To be paid at

\* If of Iron, state whether scrap or puddled Iron.



*Remagen, Ferguson (Linn)*

*Linn S. P. No 157*

*"Natuna" Lch. Rept. No 8728*



© 2019

Lloyd's Register  
Foundation