
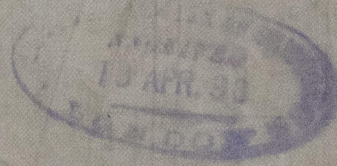
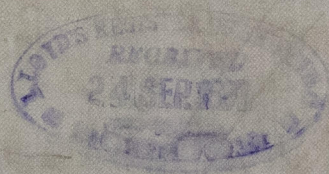
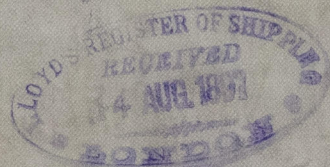
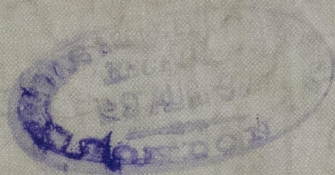


Damage & Ferguson (Lim)

Irwin S. S. No 157. "Natuna"

44/28

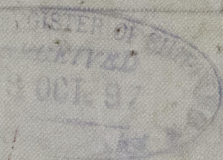



© 2019

Lloyd's Register
Foundation

LTH567-0097


Invin S. S. "Natuna"
 Est. Rept. No.

3.8.97
 10.8.97
 17.8.97
 20.8.97
 25.9.97
 8.10.97
 19.4.98

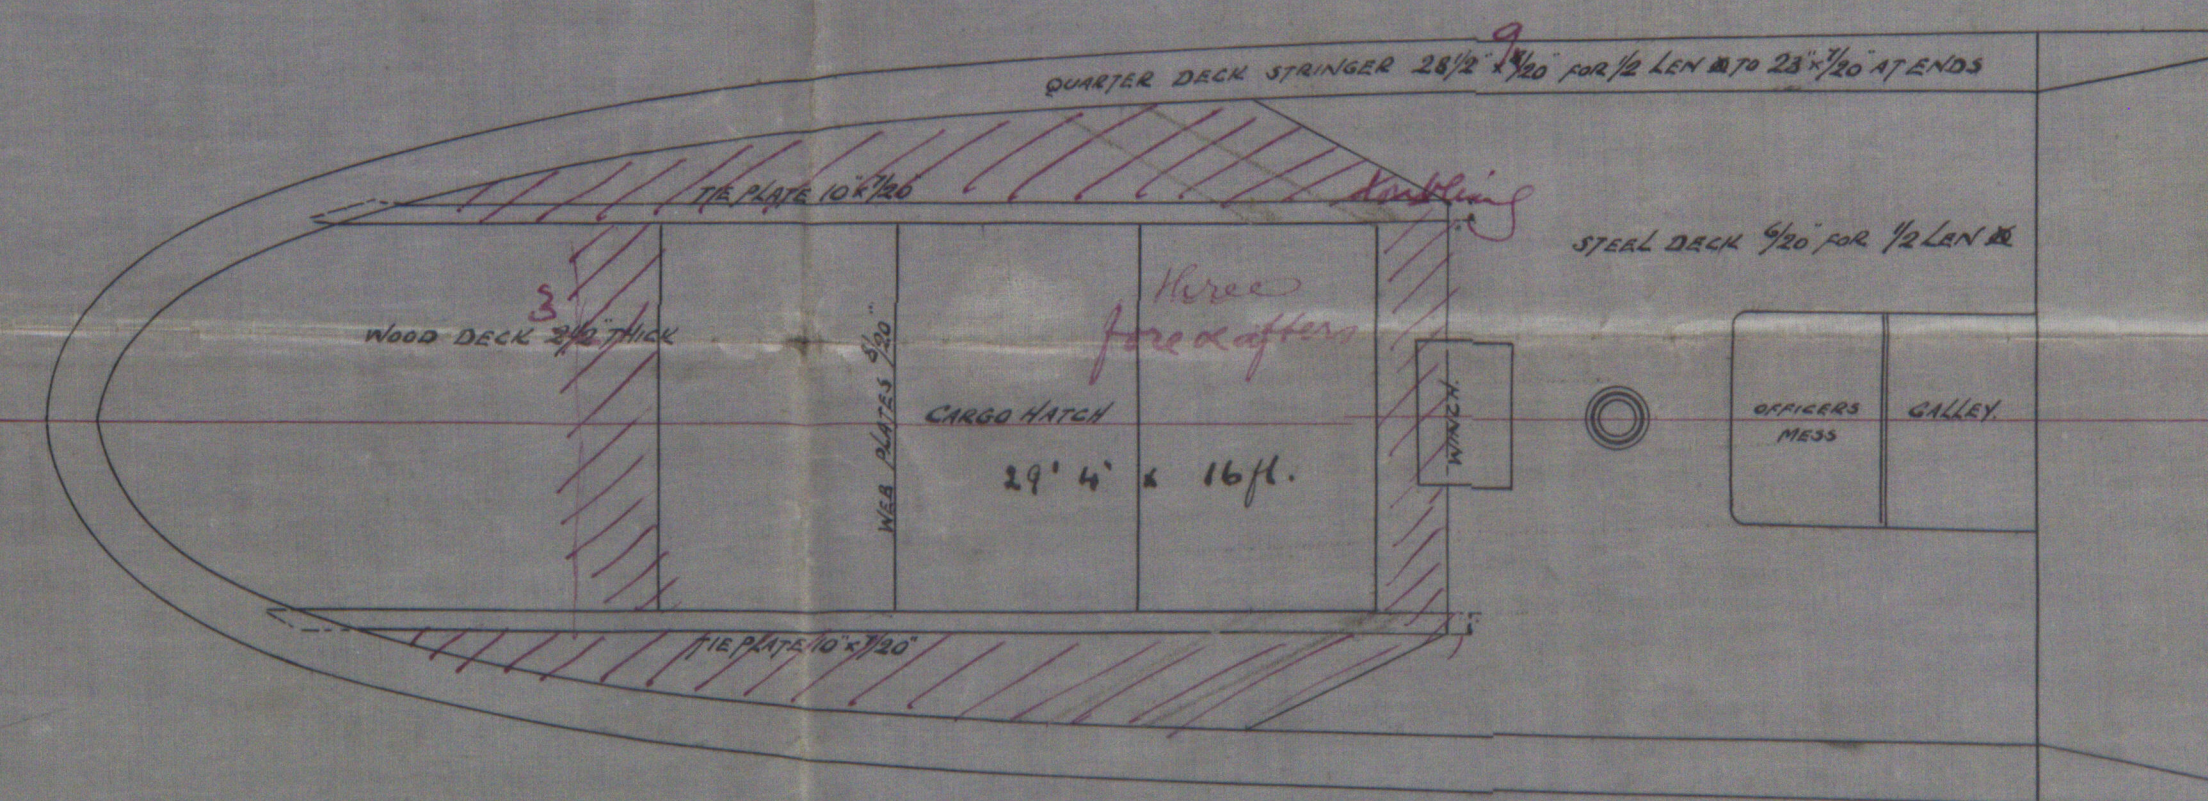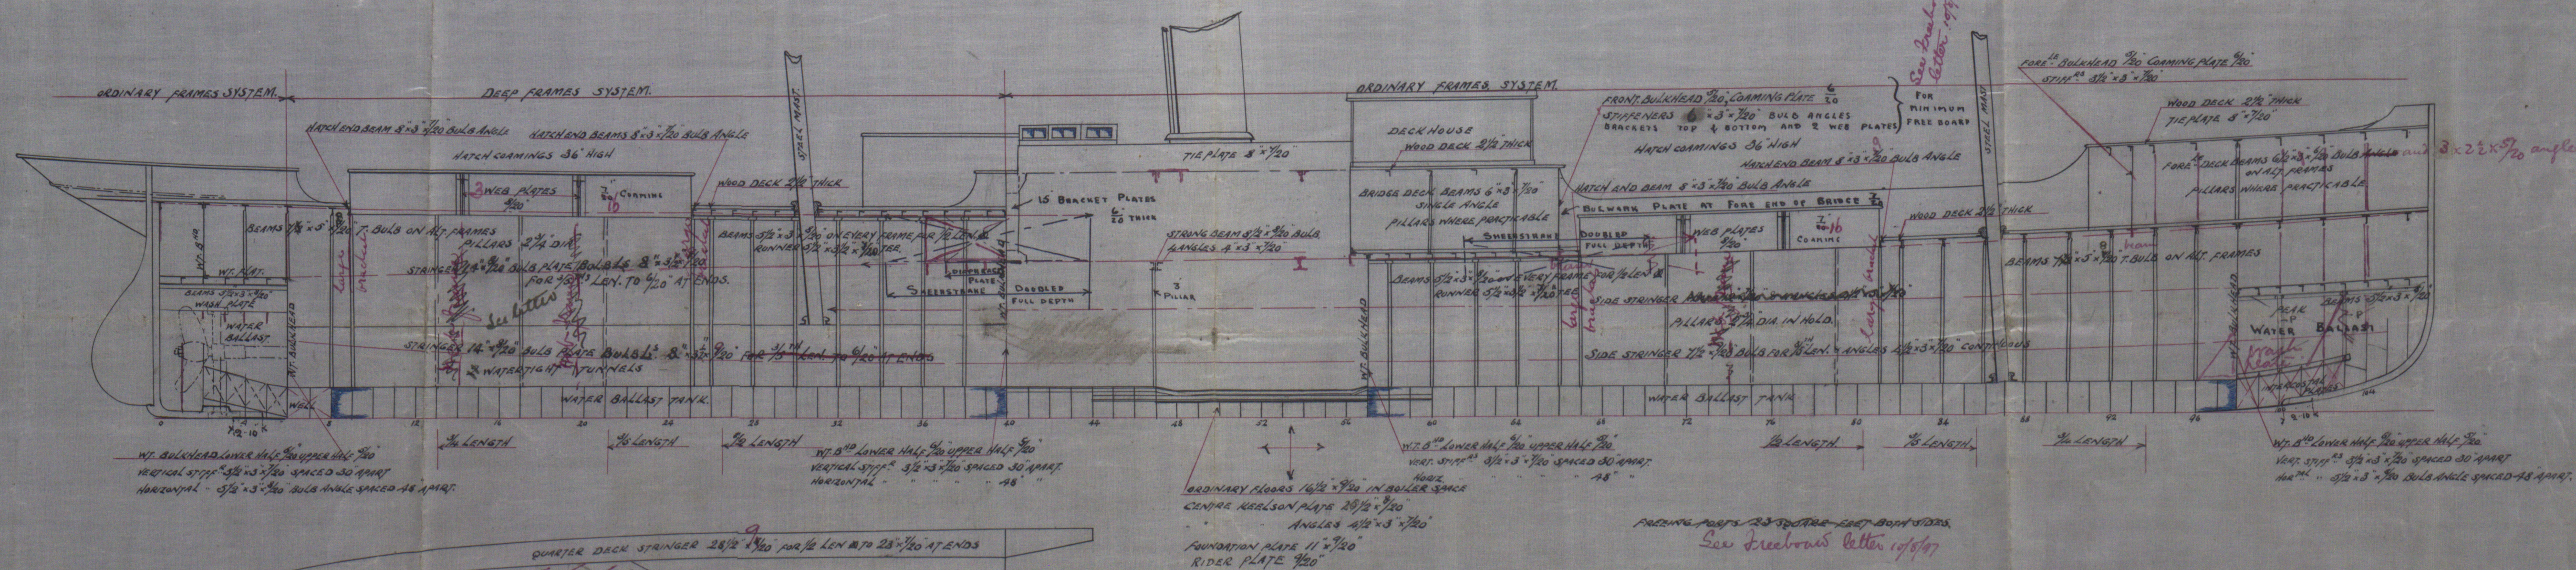

T. S. S. N. 107
PROFILE & DECK PLAN
 DIMENSIONS 197' 0" B.P. x 32' 0" x 13' 6" A.P.C.
 SCALE 1/4" = 1 FOOT
 TO CLASS 100-A-1 AT LLOYD'S STEEL

McKinnell
 3ms

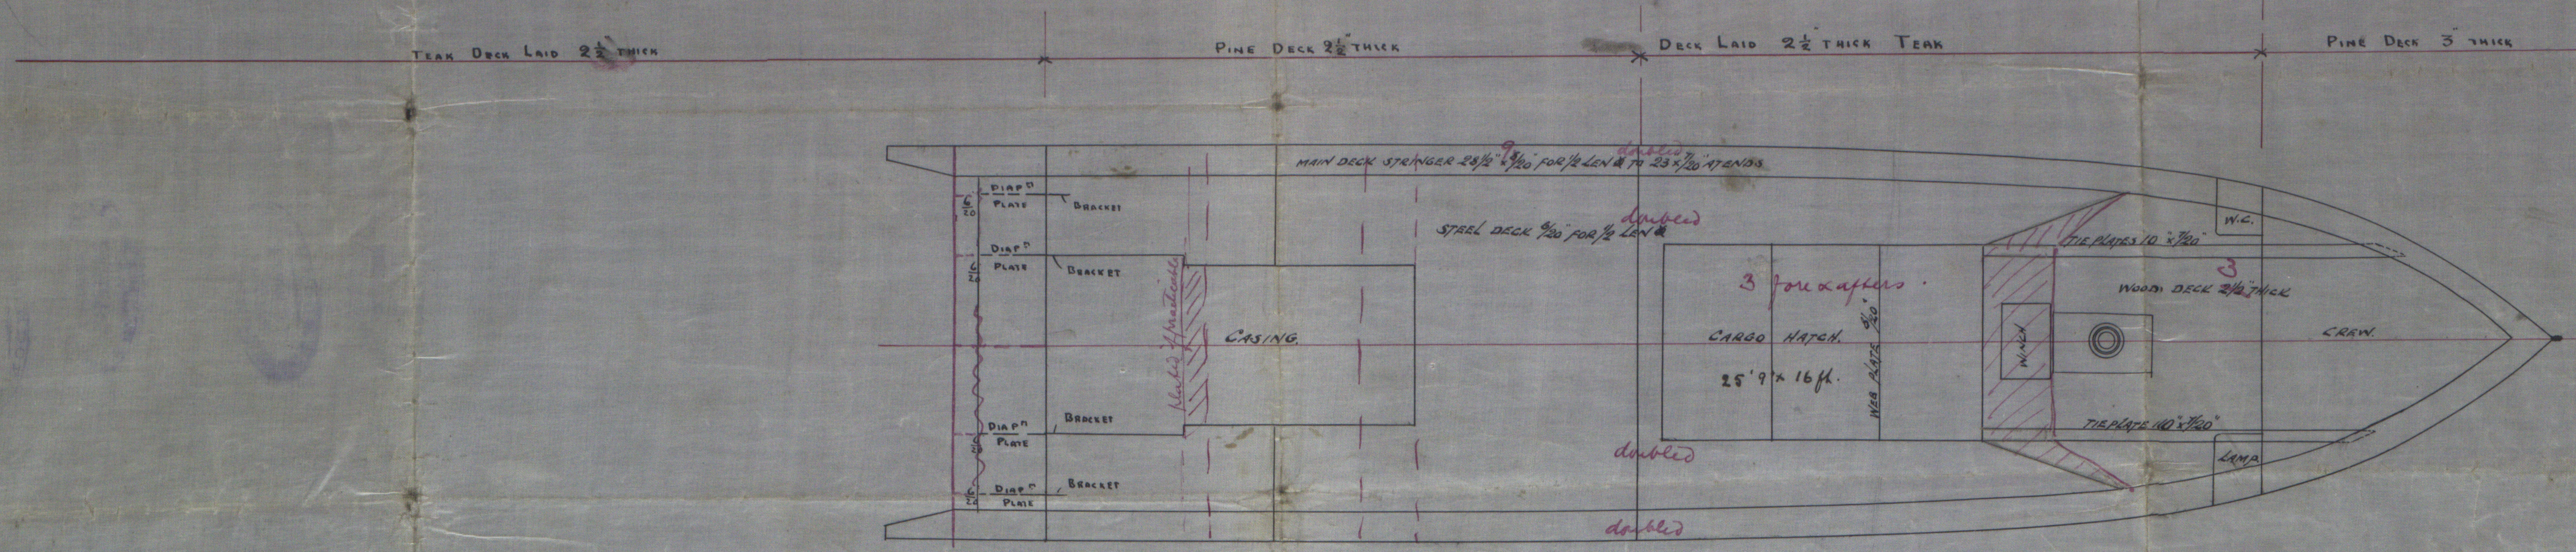

3/8/97
 17/8/97
 19/4/98

LTH567-0097